

LAND-MARK SURVEYING
Mark L. Miritz
Wisconsin Registered Land Surveyor S-2582

N9330 Knuteson Drive
Whitewater, WI 53190
Phone: (262) 495-3284
FAX : (262) 495-8421
LAND-MARKSURVEYING.COM

PLAT OF SURVEY

LOT 10, EVERGREEN PARK SUBDIVISION
CITY OF WHITEWATER, WALWORTH
COUNTY, WISCONSIN.

OWNER: BRUNHILDE W. SOMMER
1614 WILDWOOD ROAD
WHITEWATER, WI 53190

LEGEND




- FOUND IRON PIPE
- FOUND IRON ROD 3/4"
- SET IRON PIPE, 18" LONG, WEIGHING 1.5 LBS./LINEAL FT., 1 1/4" DIA.
- (x x) RECORDED AS DIMENSION
- X--X- WOOD FENCE

SCALE: 1 INCH = 40 FEET

"I hereby certify that the above described property has been surveyed by me or under my direction and that the above map is a true representation thereof and shows the size and location of the property, its exterior boundaries, the location of all visible structures and dimensions of all principal buildings thereon, boundary fences, apparent easements, roadways and visible encroachments, if any."
"This survey is made for the use of the present owners of the property, and also those who purchase, mortgage, or guarantee the title thereto within one year from date hereof."

Mark L. Miritz
MARK L. MIRITZ
WISCONSIN REGISTERED
LAND SURVEYOR S-2582

DATE: MAY 17, 2010 JOB NO. 10.507

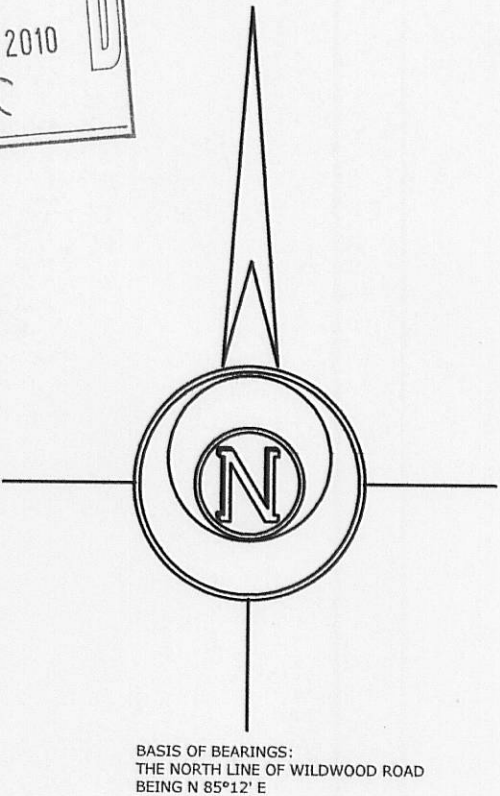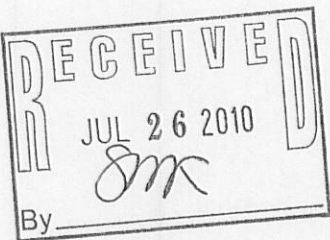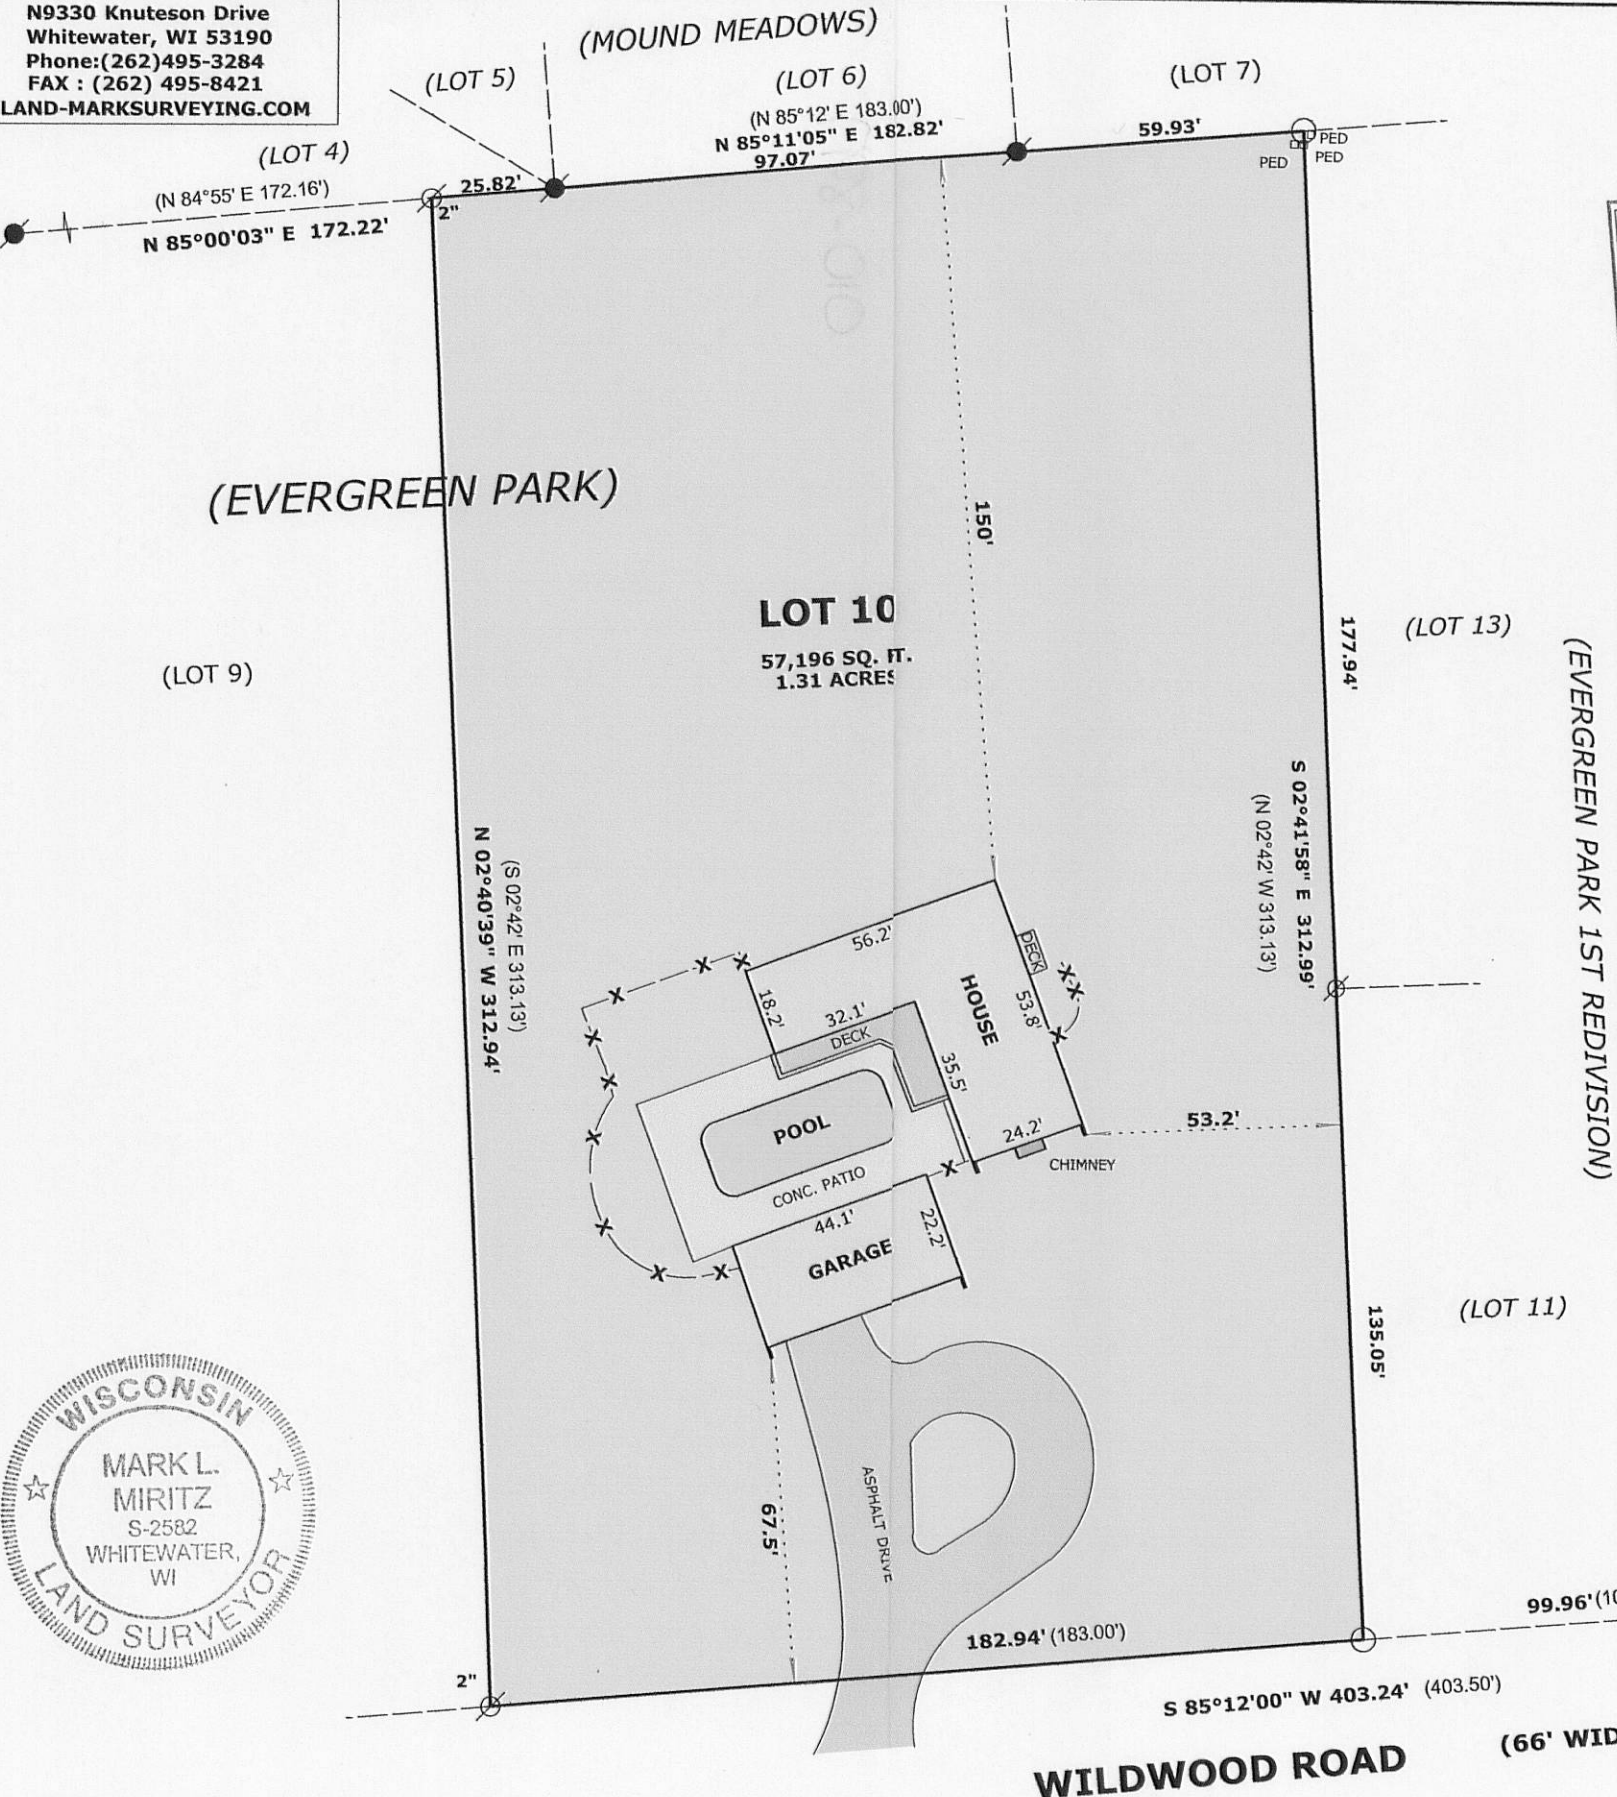

PINE CIRCLE

LEV 10

010 - 897