


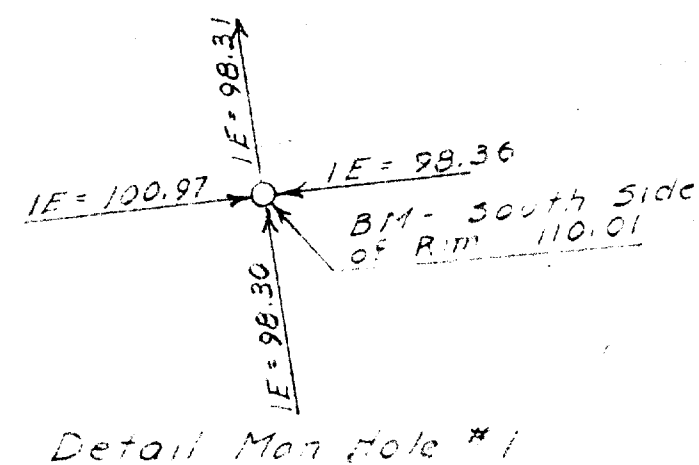

DATE May, 1961