


GEORGE T. DUNHAM  
SURVEYING & SUBDIVIDING  
DELAVER, WISCONSIN

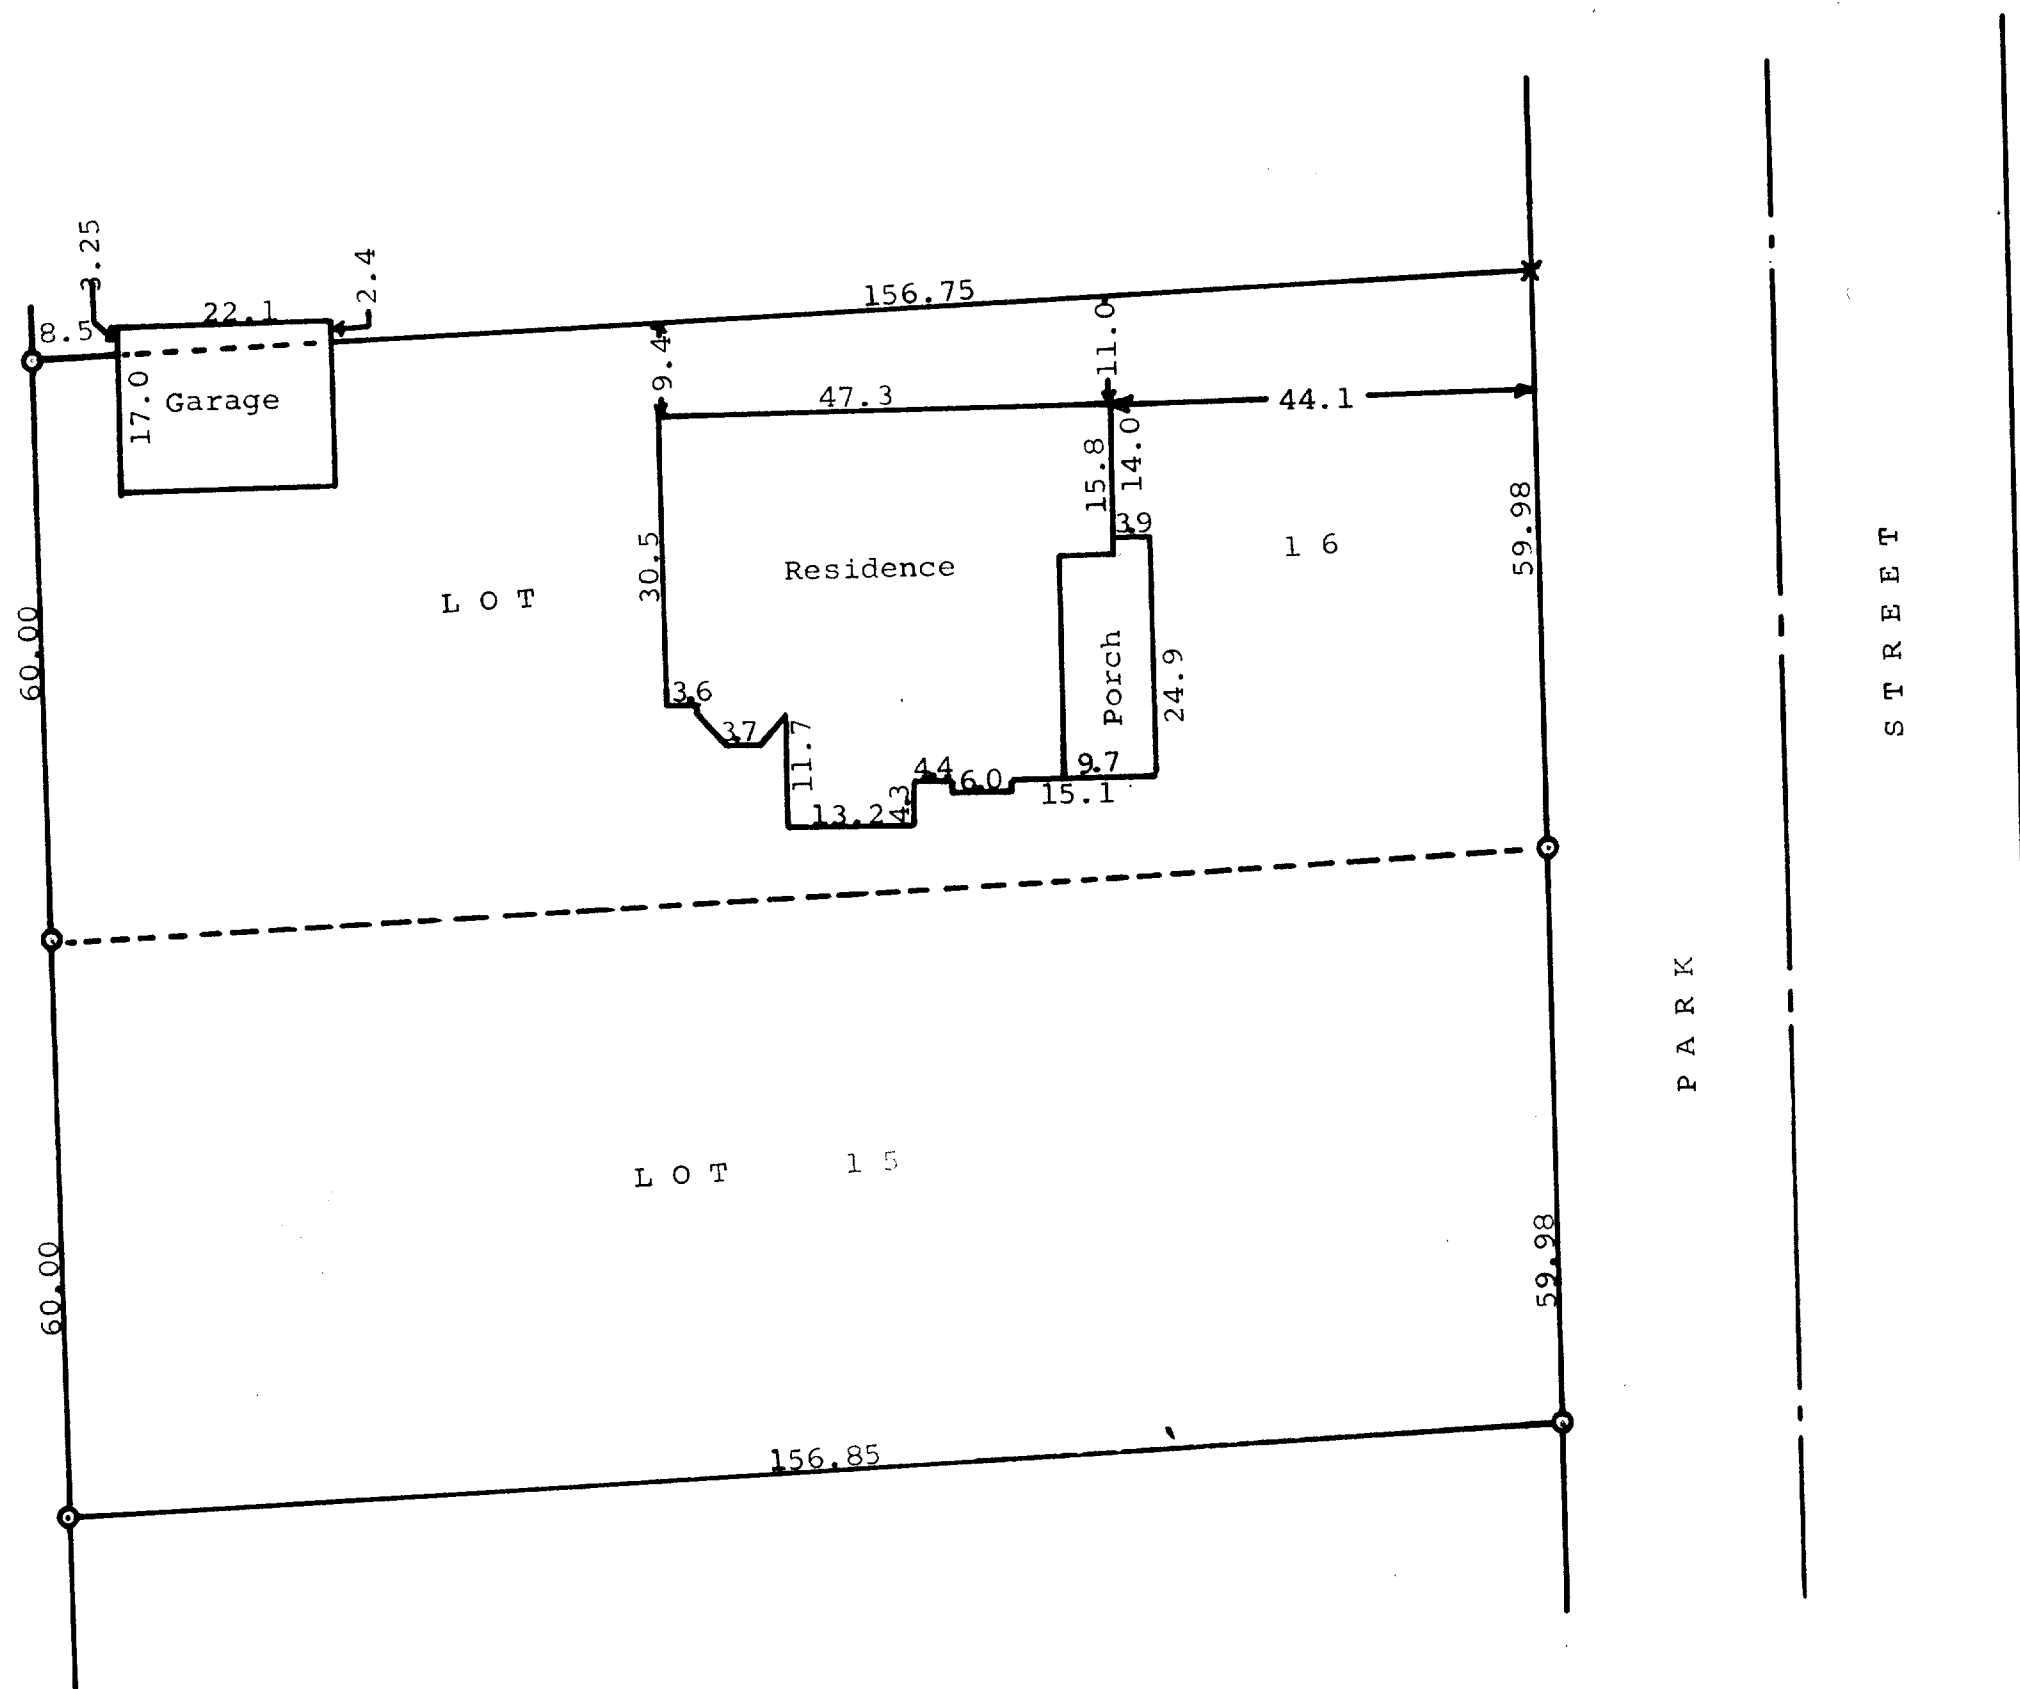

Scale - 1" = 20'  
 O = Iron Pipe  
 X = Cross in Concrete

State of Wisconsin ) SS  
 Walworth County )

I, George T. Dunham, Surveyor do certify that I have surveyed the property described as follows,  
 Lots 15 & 16 of Clarke's Addition to the City of Whitewater, Walworth County, Wisconsin  
 and that the plat shown above is an accurate survey and a true representation thereof and correctly shows the exterior boundary lines and location of buildings on said property and the correct measurements thereof.  
 October 14, 1965

*George T. Dunham*  
 George T. Dunham, Surveyor

10-92

CLA-15, CLA-16