

LAND-MARK SURVEYING
Mark L. Miritz


Wisconsin Registered Land Surveyor S-2582

N9330 Knuteson Drive
Whitewater, WI 53190
Phone: (262) 495-3284
MARKMIRITZ@
LAND-MARKSURVEYING.COM

PLAT OF SURVEY

That part of Lots 4 and 5, in Block 11 of the City of Whitewater.
and bounded as follows: Commencing at the NW corner of Lot 5 and on
the E. line of Church Street. and running thence S. along the W. line
of Lot 5, 65 ft. to a stake. thence at right angle with the E. line
of said Church Street to the center line of Lot 4 the same block run-
ning N. and S. thence N'y along the center line of said Lot numbered
4 to the alley in the rear of said Lots; thence along the S line of
said Alley to the place of beginning.

OWNER: DALE N. STETTTLER TRUST
GAYLE M. STETTTLER TRUST
P.O. BOX 657
WHITEWATER, WI 53190

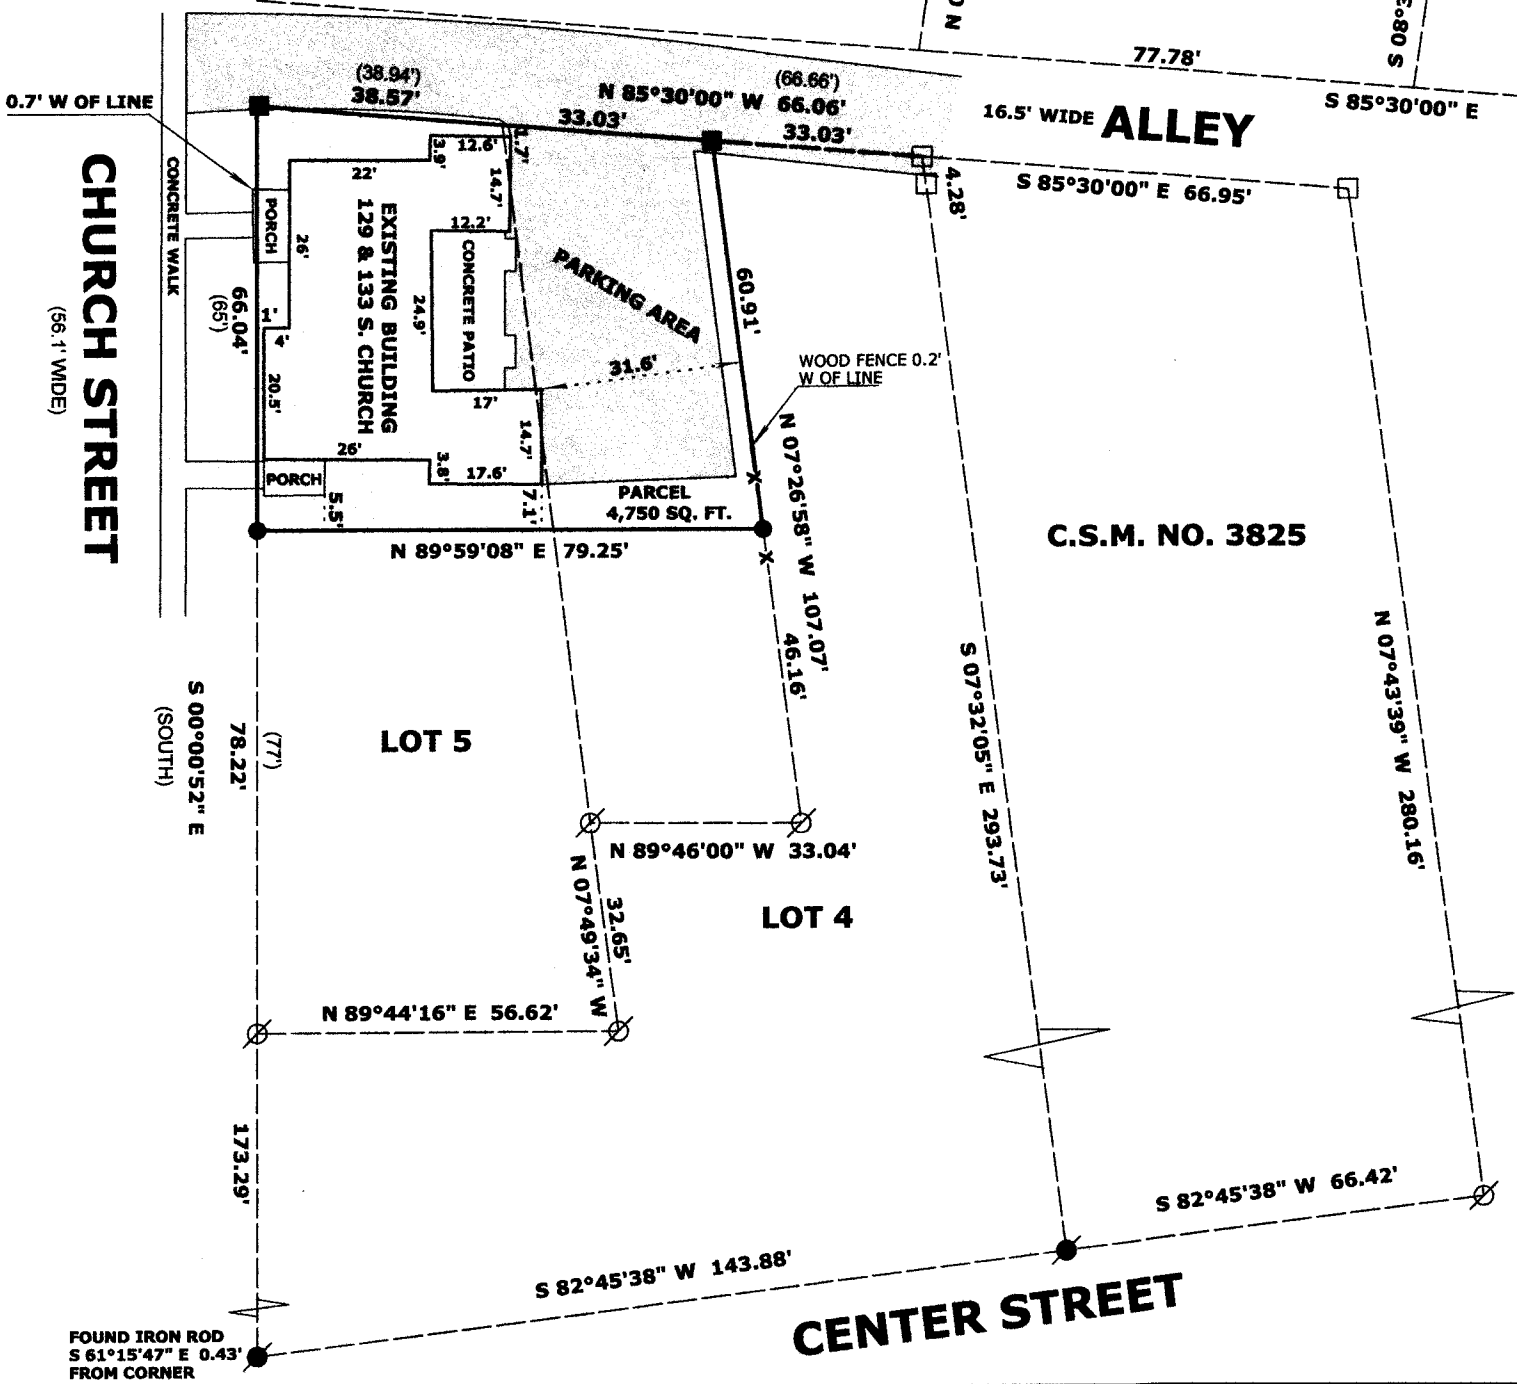

SURVEYOR'S NOTE:

THIS SURVEY RETRACED CERTIFIED SURVEY MAP NO. 3825
WHICH SHOWS OVER RUN NORTH-SOUTH IN BLOCK 11 AND
A SURVEY BY ALAN L. BERG WHICH SHOWS OVER RUN NORTH
SOUTH IN BLOCK 5 (NORTH SIDE OF ALLEY). MONUMENTS FOUND
IN LOTS 4 & 5, RETRACES SURVEYS BY TERRANCE E. PISAREK
DATED 9/7/1995 & 5/4/1995

LEGEND

- FOUND IRON PIPE
- FOUND IRON ROD
- FOUND P.K. NAIL
- SET P.K. NAIL
- SET IRON ROD, 18" LONG, WEIGHING 1.5 LBS./LINEAL FT., 3/4" DIA.
- (x x) RECORDED AS DIMENSION
- EXISTING FENCE


SCALE: 1 INCH = 30 FEET

"I hereby certify that the above described property has
been surveyed by me or under my direction and that the
above map is a true representation thereof and shows the
size and location of the property, its exterior boundaries,
the location of all visible structures and dimensions of all
principal buildings thereon, boundary fences, apparent
easements, roadways and visible encroachments, if any."
"This survey is made for the use of the present owners of
the property, and also those who purchase, mortgage, or
guarantee the title thereto within one year from date
hereof."

Mark L. Miritz
MARK L. MIRITZ
WISCONSIN REGISTERED
LAND SURVEYOR S-2582

DATE: DEC. 3, 2013 JOB NO. 13.1201

DEC 1 2 2013
jk

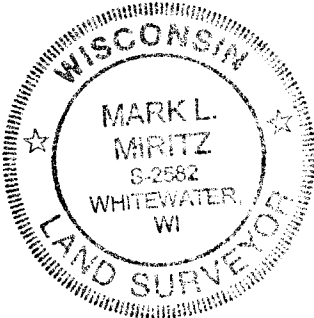

LOT -110 010-944