

LAND-MARK SURVEYING
Mark L. Miritz


Wisconsin Registered Land Surveyor S-2582

N9330 Knuteson Drive
Whitewater, WI 53190
Phone: (262) 495-3284
MARKMIRITZ@
LAND-MARKSURVEYING.COM

PLAT OF SURVEY

**LOT 1, CERTIFIED SURVEY MAP NO. 645,
LOCATED IN THE NORTHWEST 1/4 OF
SECTION 3, TOWN 4 NORTH, RANGE 15
EAST, CITY OF WHITEWATER, WALWORTH
COUNTY, WISCONSIN.**

**OWNER: BENJAMIN POWER COMPANY
611 LANDWEHR ROAD
NORTHBROOK, IL 60052**

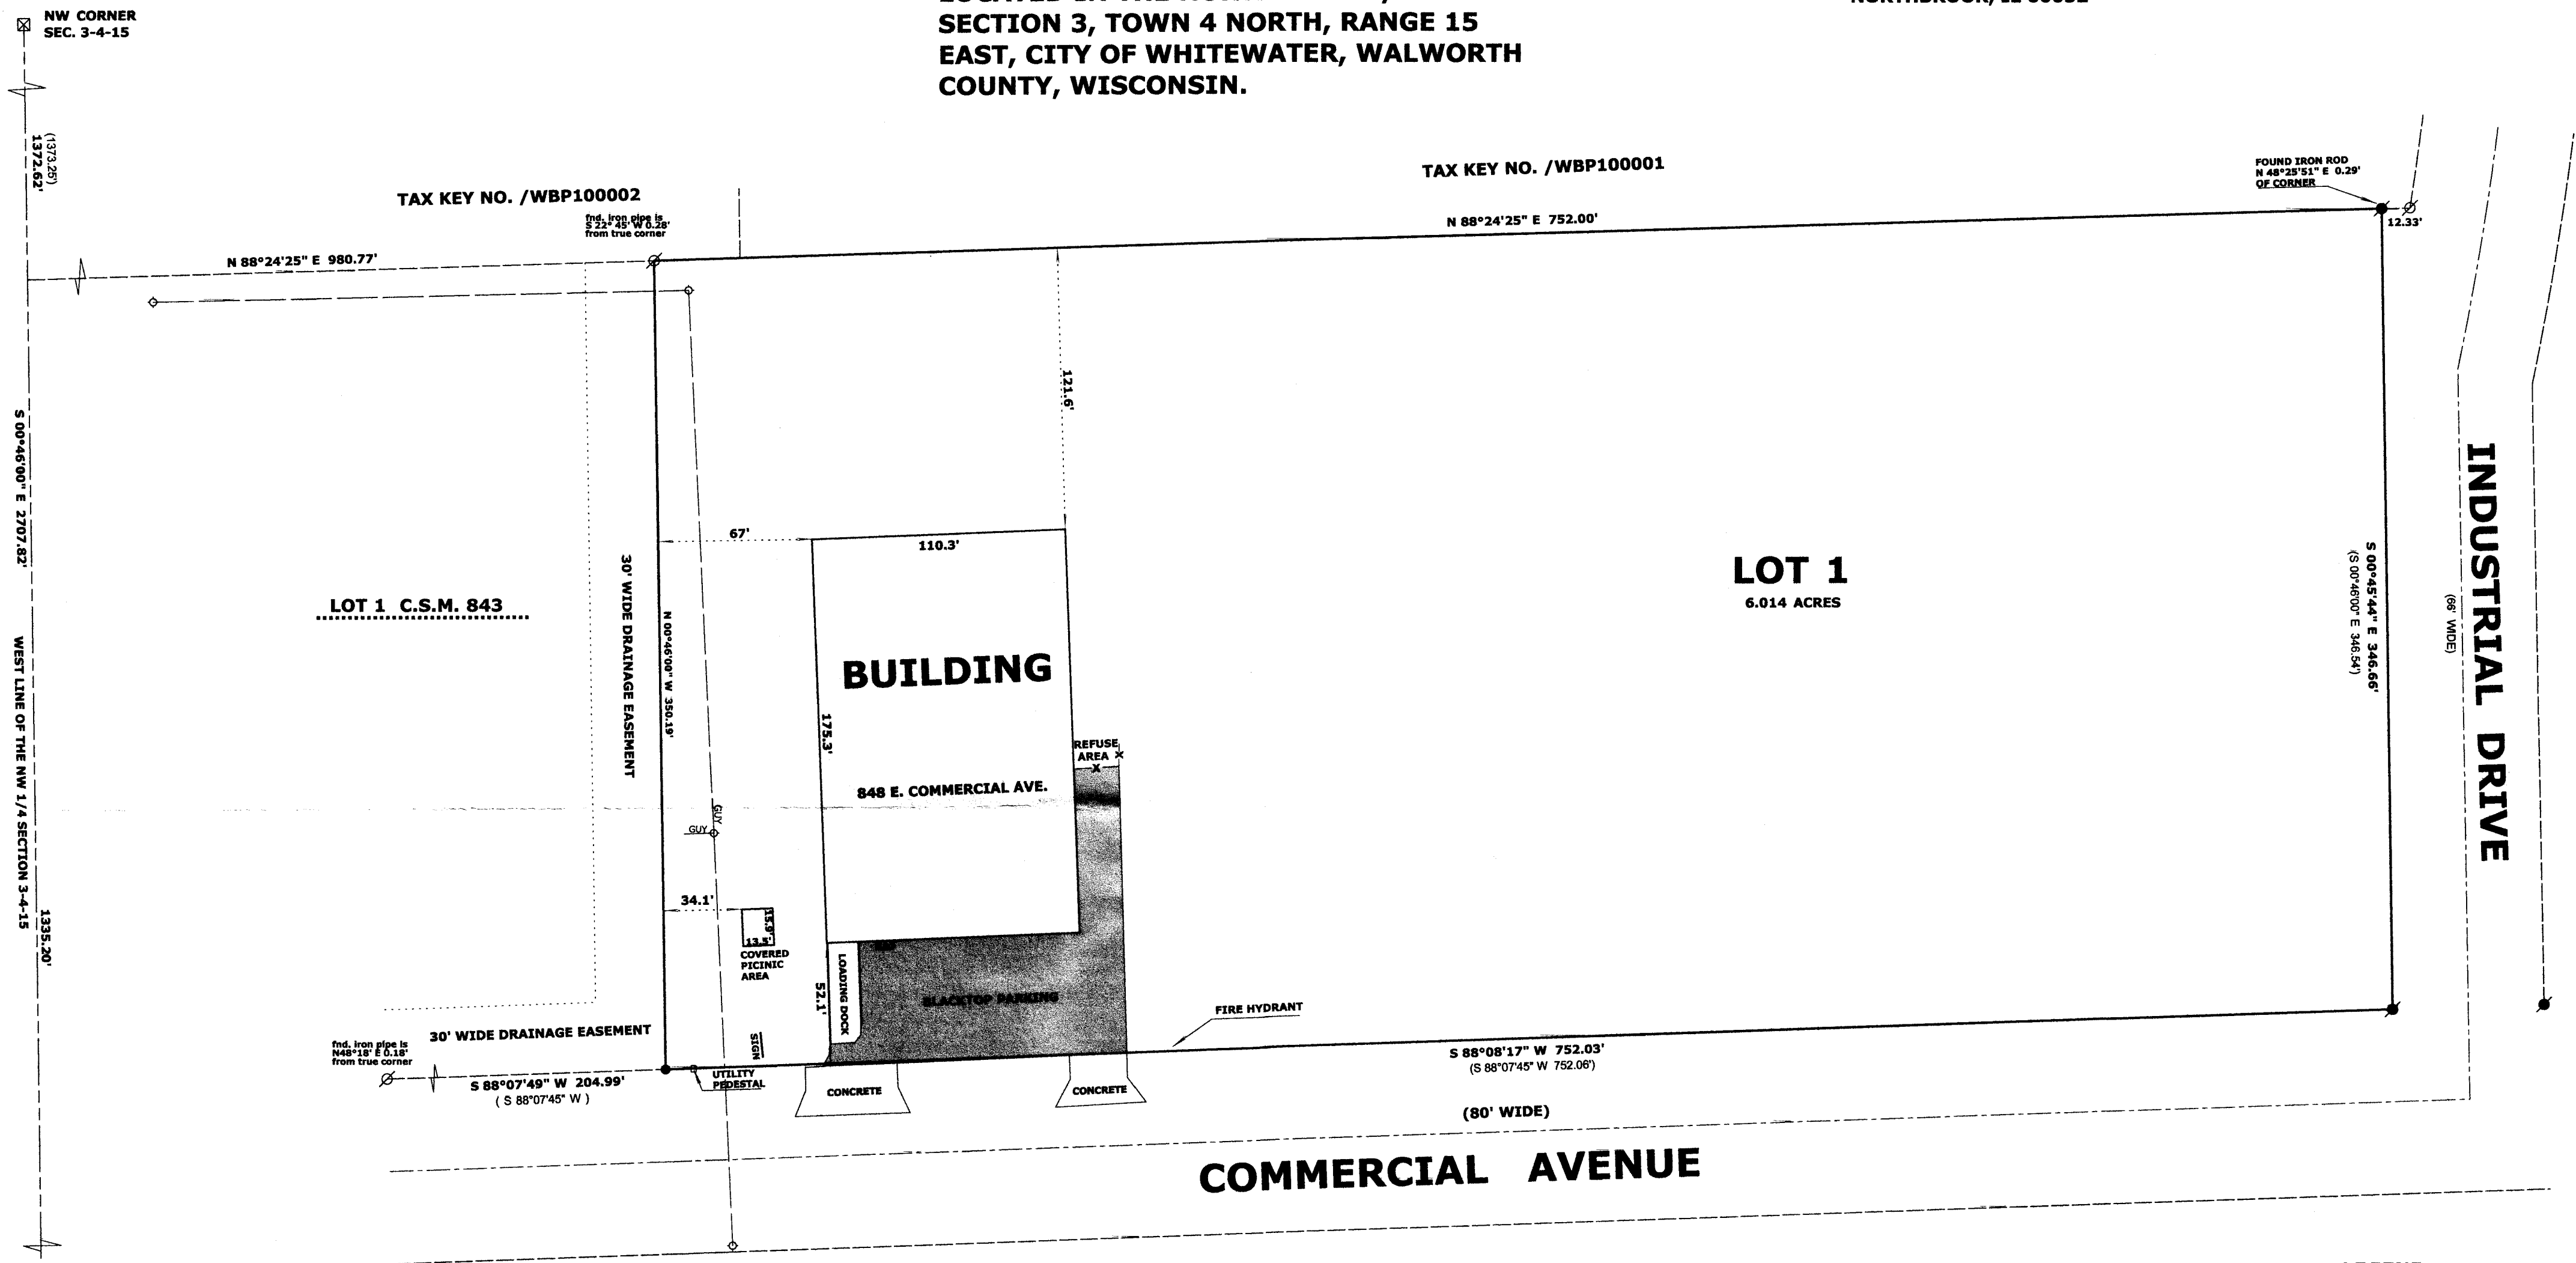

LEGEND


- FOUND IRON PIPE 1.25"
- FOUND IRON ROD .75"
- FOUND IRON ROD 1.25"
- FOUND COUNTY MONUMENT
- UTILITY POLE WITH OVERHEAD LINES
- (x x) RECORDED AS DIMENSION

SCALE: 1 INCH= 50 FEET


"I hereby certify that the above described property has been surveyed by me or under my direction and that the above map is a true representation thereof and shows the size and location of the property, its exterior boundaries, the location of all visible structures and dimensions of all principal buildings thereon, boundary fences, apparent easements, roadways and visible encroachments, if any."

Mark L. Miritz
**MARK L. MIRITZ
WISCONSIN REGISTERED
LAND SURVEYOR S-2582**

DATE: NOV. 10, 2013 JOB NO. 13.1106

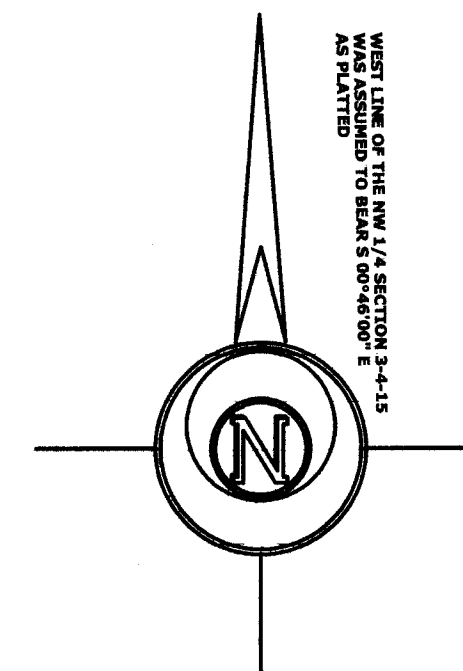

DEC 1 2 2013

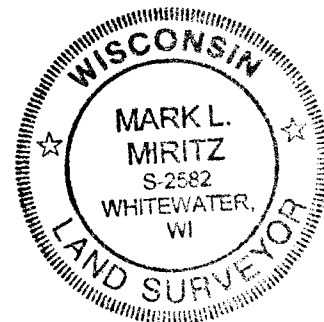

1A 645-1

010-946