

# LAND-MARK SURVEYING

## **Mark L. Miritz**


Wisconsin Registered Land Surveyor S-2582

**N9330 Knuteson Drive  
Whitewater, WI 53190  
Phone: (262) 495-3284  
FAX: (262) 495-8421  
LAND-MARK SURVEYING.COM**

# PLAT OF SURVEY

**LOT 24 OF WESTPARK ADDITION, LOCATED  
IN PART OF THE SOUTHWEST 1/4 OF THE  
SOUTHWEST 1/4 OF SECTION 5, TOWN 4  
NORTH, RANGE 15 EAST, CITY OF WHITEWATER  
WALWORTH COUNTY, WISCONSIN.**

**OWNER: SUSAN G. STONE  
1256 W. COURT STREET  
WHITEWATER, WI 53190**

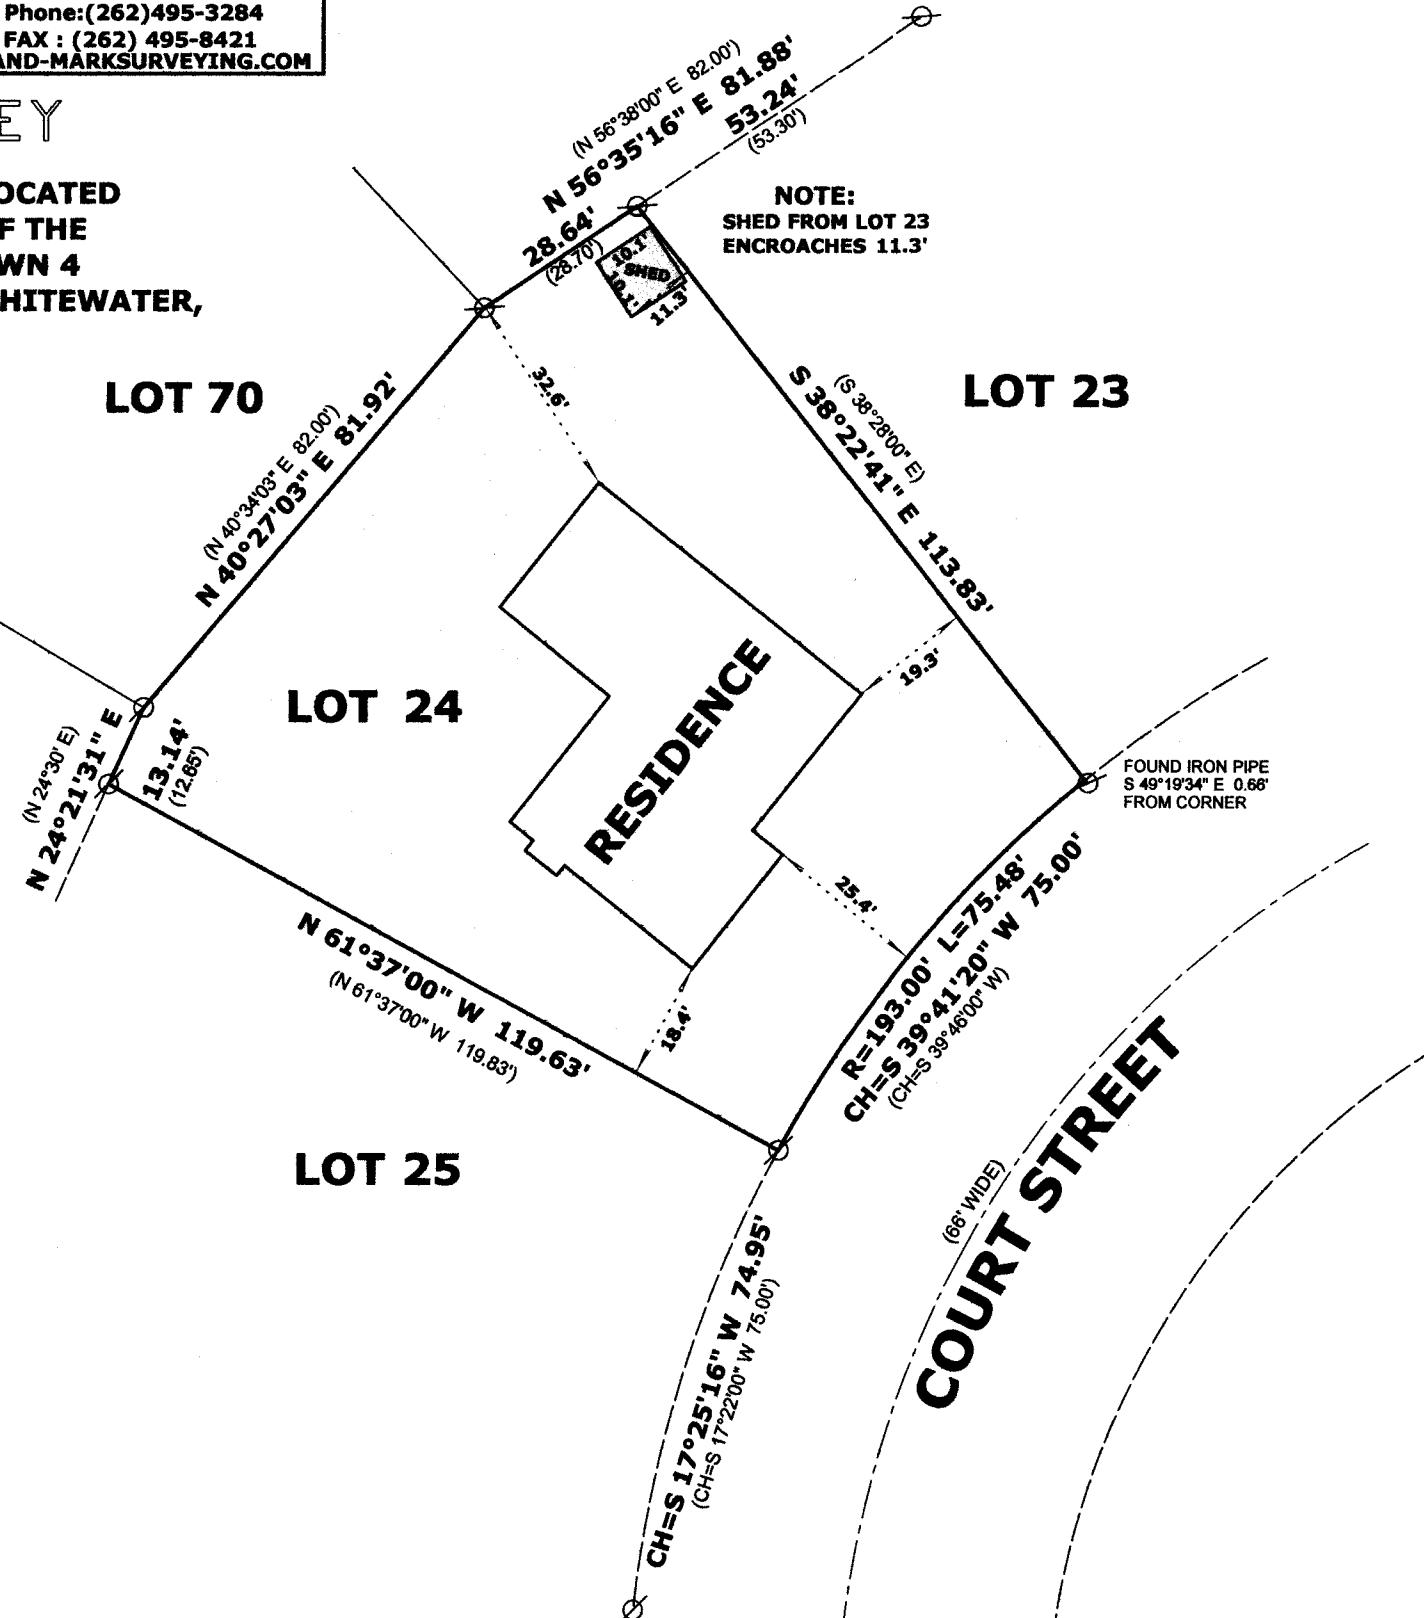

**COURT STREET**  
(66' WIDE)

DEC 12 2013

## LEGEND

I hereby certify that the above described property has been surveyed by me or under my direction in compliance with the owner's/agent's instructions in Chapter A-E 7 of the Wisconsin Administrative Code "Minimum Standards for property surveys"; that the above is correct to the best of my knowledge and belief."

MARK L. MIRITZ  
**WISCONSIN REGISTERED  
LAND SURVEYOR S-2582**

DATE: AUGUST 30, 2013 JOB NO. 13.807

010-951

1WP-24

