


PREPARED FOR
KRIS COLEMAN
301 S. VINE AVE
MARSHFIELD WI 54449

PLAT OF SURVEY

PATHFINDER SURVEYING INC.
(formerly)
J.K. SURVEYING INC.
P.O BOX 322
LAKE GENEVA, WI. 53147
WWW.PATHFINDERSURVEYING.NET
262-248-8303

LOT 4, BLOCK 2, OF TRIPP AND POSEY'S SUBDIVISION OF BLOCK 10 OF TRIPP'S SECOND ADDITION TO THE VILLAGE (NOW CITY) OF WHITEWATER, LOCATED IN THE SE 1/4 OF SECTION 4, TOWN 4 NORTH, RANGE 15 EAST, WALWORTH COUNTY, WISCONSIN.

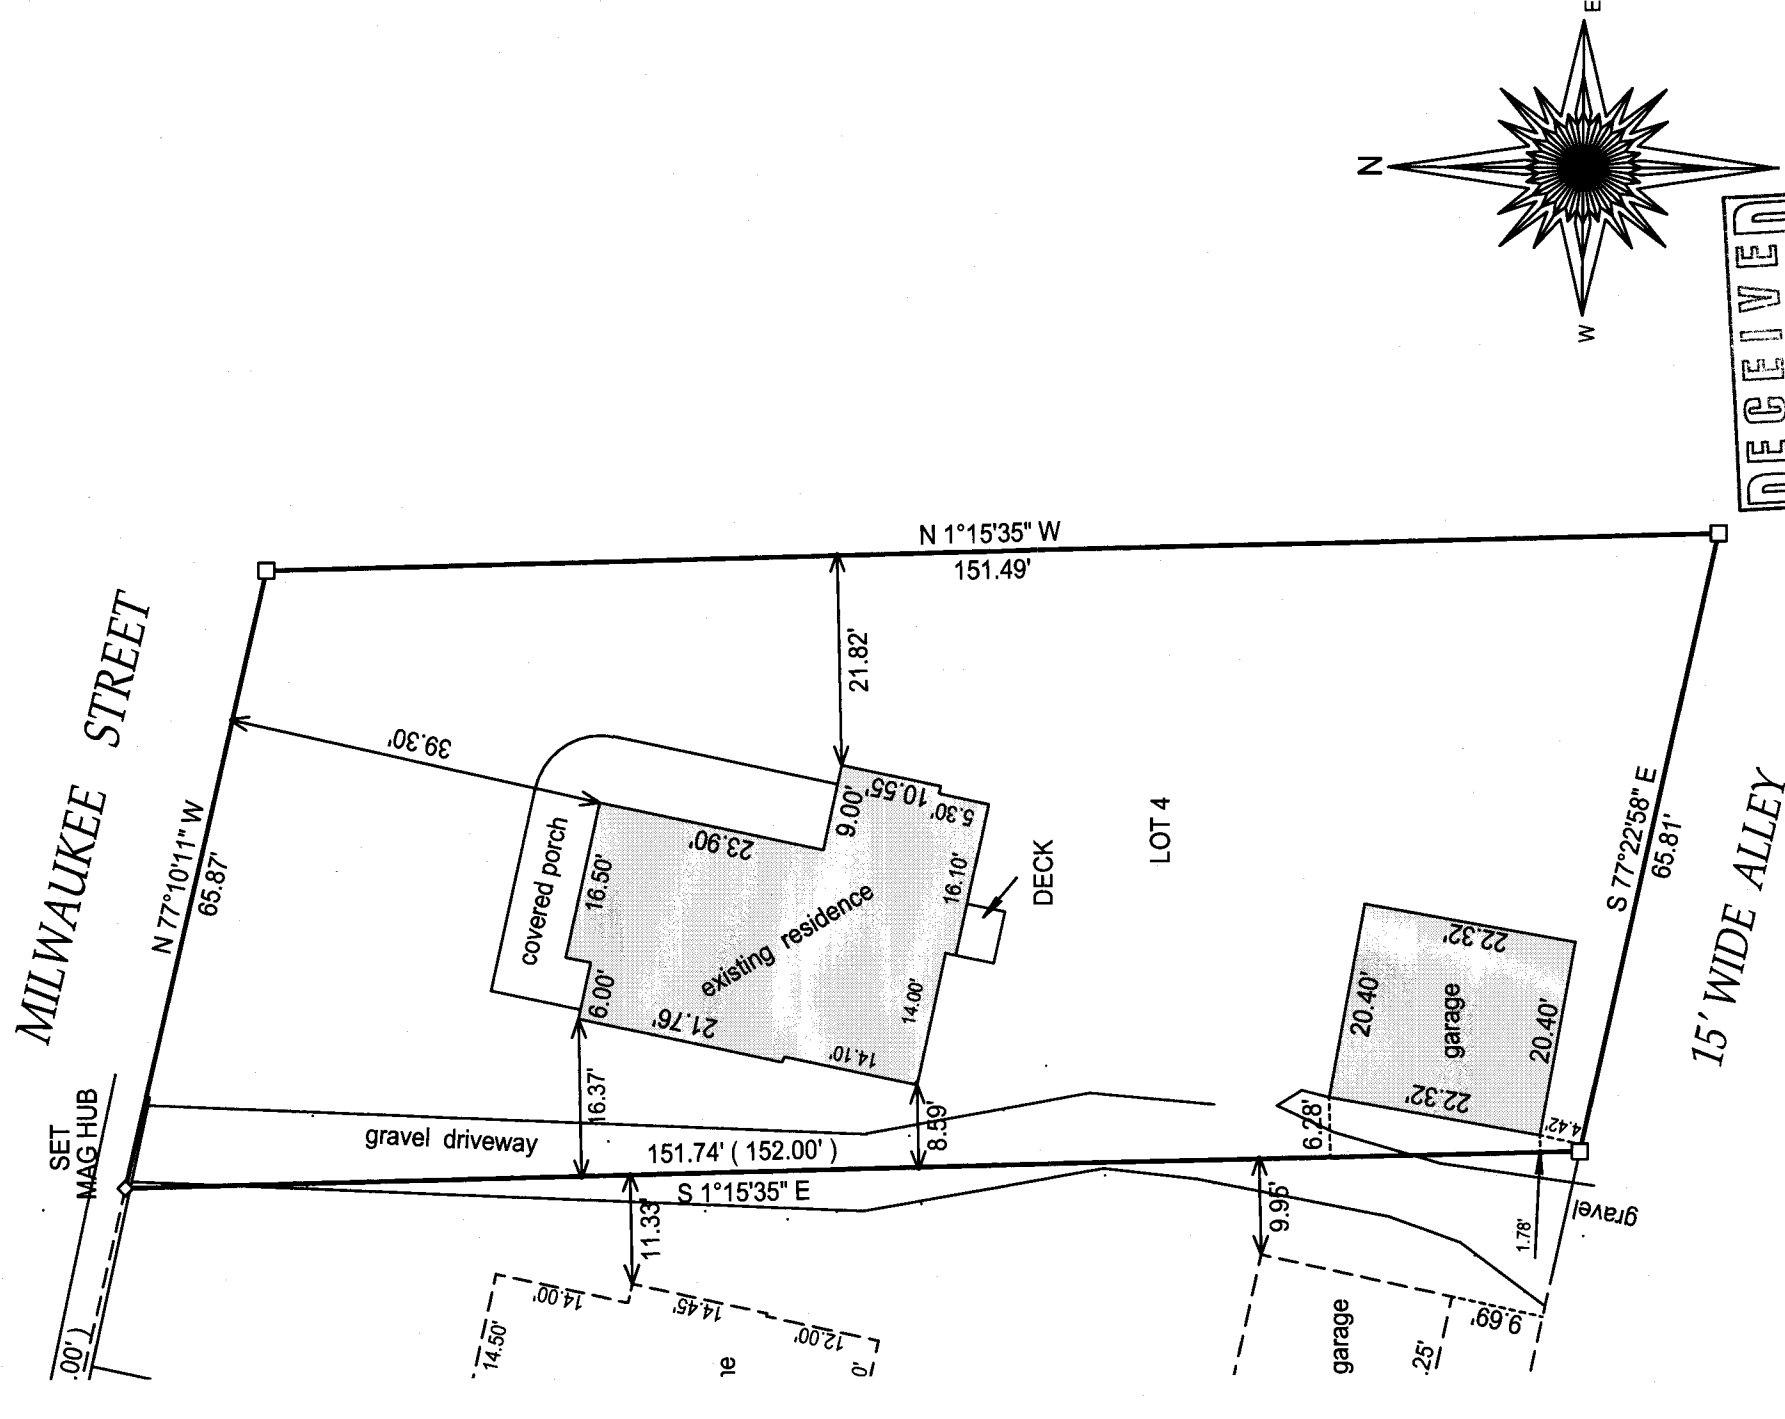


- () = recorded as
- = found iron bar
- = found iron pipe
- = set iron pipe
- = set iron bar

SCALE 1" = 20'

JOB # 00-265 / 14-06

TAX ID # TRP00018




NOTE: DUE TO HEAVY SNOW COVER
ALL IMPROVEMENTS MAY NOT
BE SHOWN.

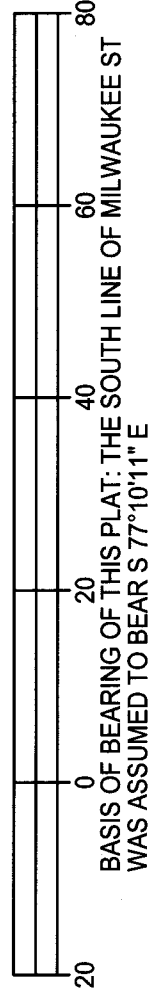

"I hereby certify that I have surveyed the above described property and that the above map is a true representation thereof and shows the size and location of all visible structures, apparent easements and encroachments if any."

This survey is made for the present owners of the property, and those who purchase, mortgage, or guarantee the title thereto, within one year from the date hereof.

DATED THIS 13th DAY OF JANUARY, 2014.

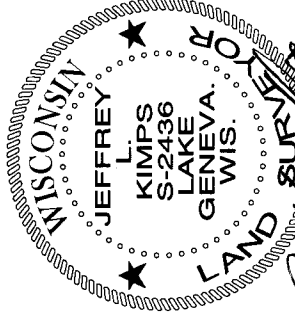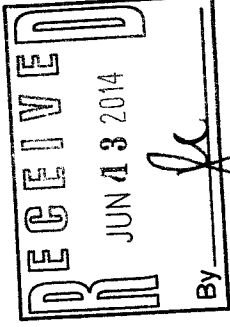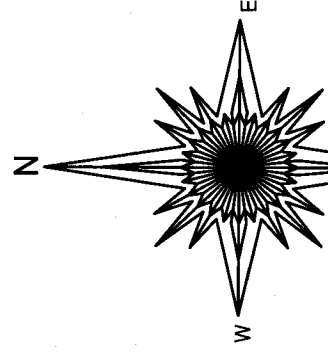

JEFFREY L. KIMPS S - 2436
Wisconsin Registered Land Surveyor
(original if signed in red)

/TRP-18 010-957