

FARRIS, HANSEN & ASSOCIATES, INC.


ENGINEERING — ARCHITECTURE — SURVEYING
7 RIDGWAY COURT — P.O. BOX 437 — ELKHORN, WISCONSIN 53121
PHONE: (262) 723-2098 FAX: (262) 723-5886

PLAT OF SURVEY

PART OF LOT 3 OF BLOCK 15 CITY OF WHITEWATER
WALWORTH COUNTY, WISCONSIN

ASSIGNED SOUTH LINE WEST FOREST AVE
N 68°30'00" E

Map Parcel No.: /OT 00181
A part of Lot 3, Block 15 of the Village, now City of Whitewater, Walworth County, Wisconsin, bounded and described as follows: Commencing at a point in the W. line of said lot, 10 rods N. of the S. corner thereof; and running thence E'ly direction parallel with Whitewater Street to the E. line of said lot; thence in a N'ly direction along the E. line of said lot to the NE corner thereof; thence W'ly to the NW corner of said lot; thence S'ly along the W. line of said lot to the place of beginning. Also known and described as: A part of Lot 3, Block 15, of the Village, now City of Whitewater, Walworth County, Wisconsin, bounded as follows: Commencing at a point in the W. line of said lot, 10 rods N. of the SW corner thereof and running thence in an E'ly direction parallel with Whitewater Street to the E. line of said lot; thence in a N'ly direction along the E. line of said lot to the NE corner thereof; thence W'ly to the NW corner of said lot; thence S'ly along the W. line of said lot to the place of beginning.


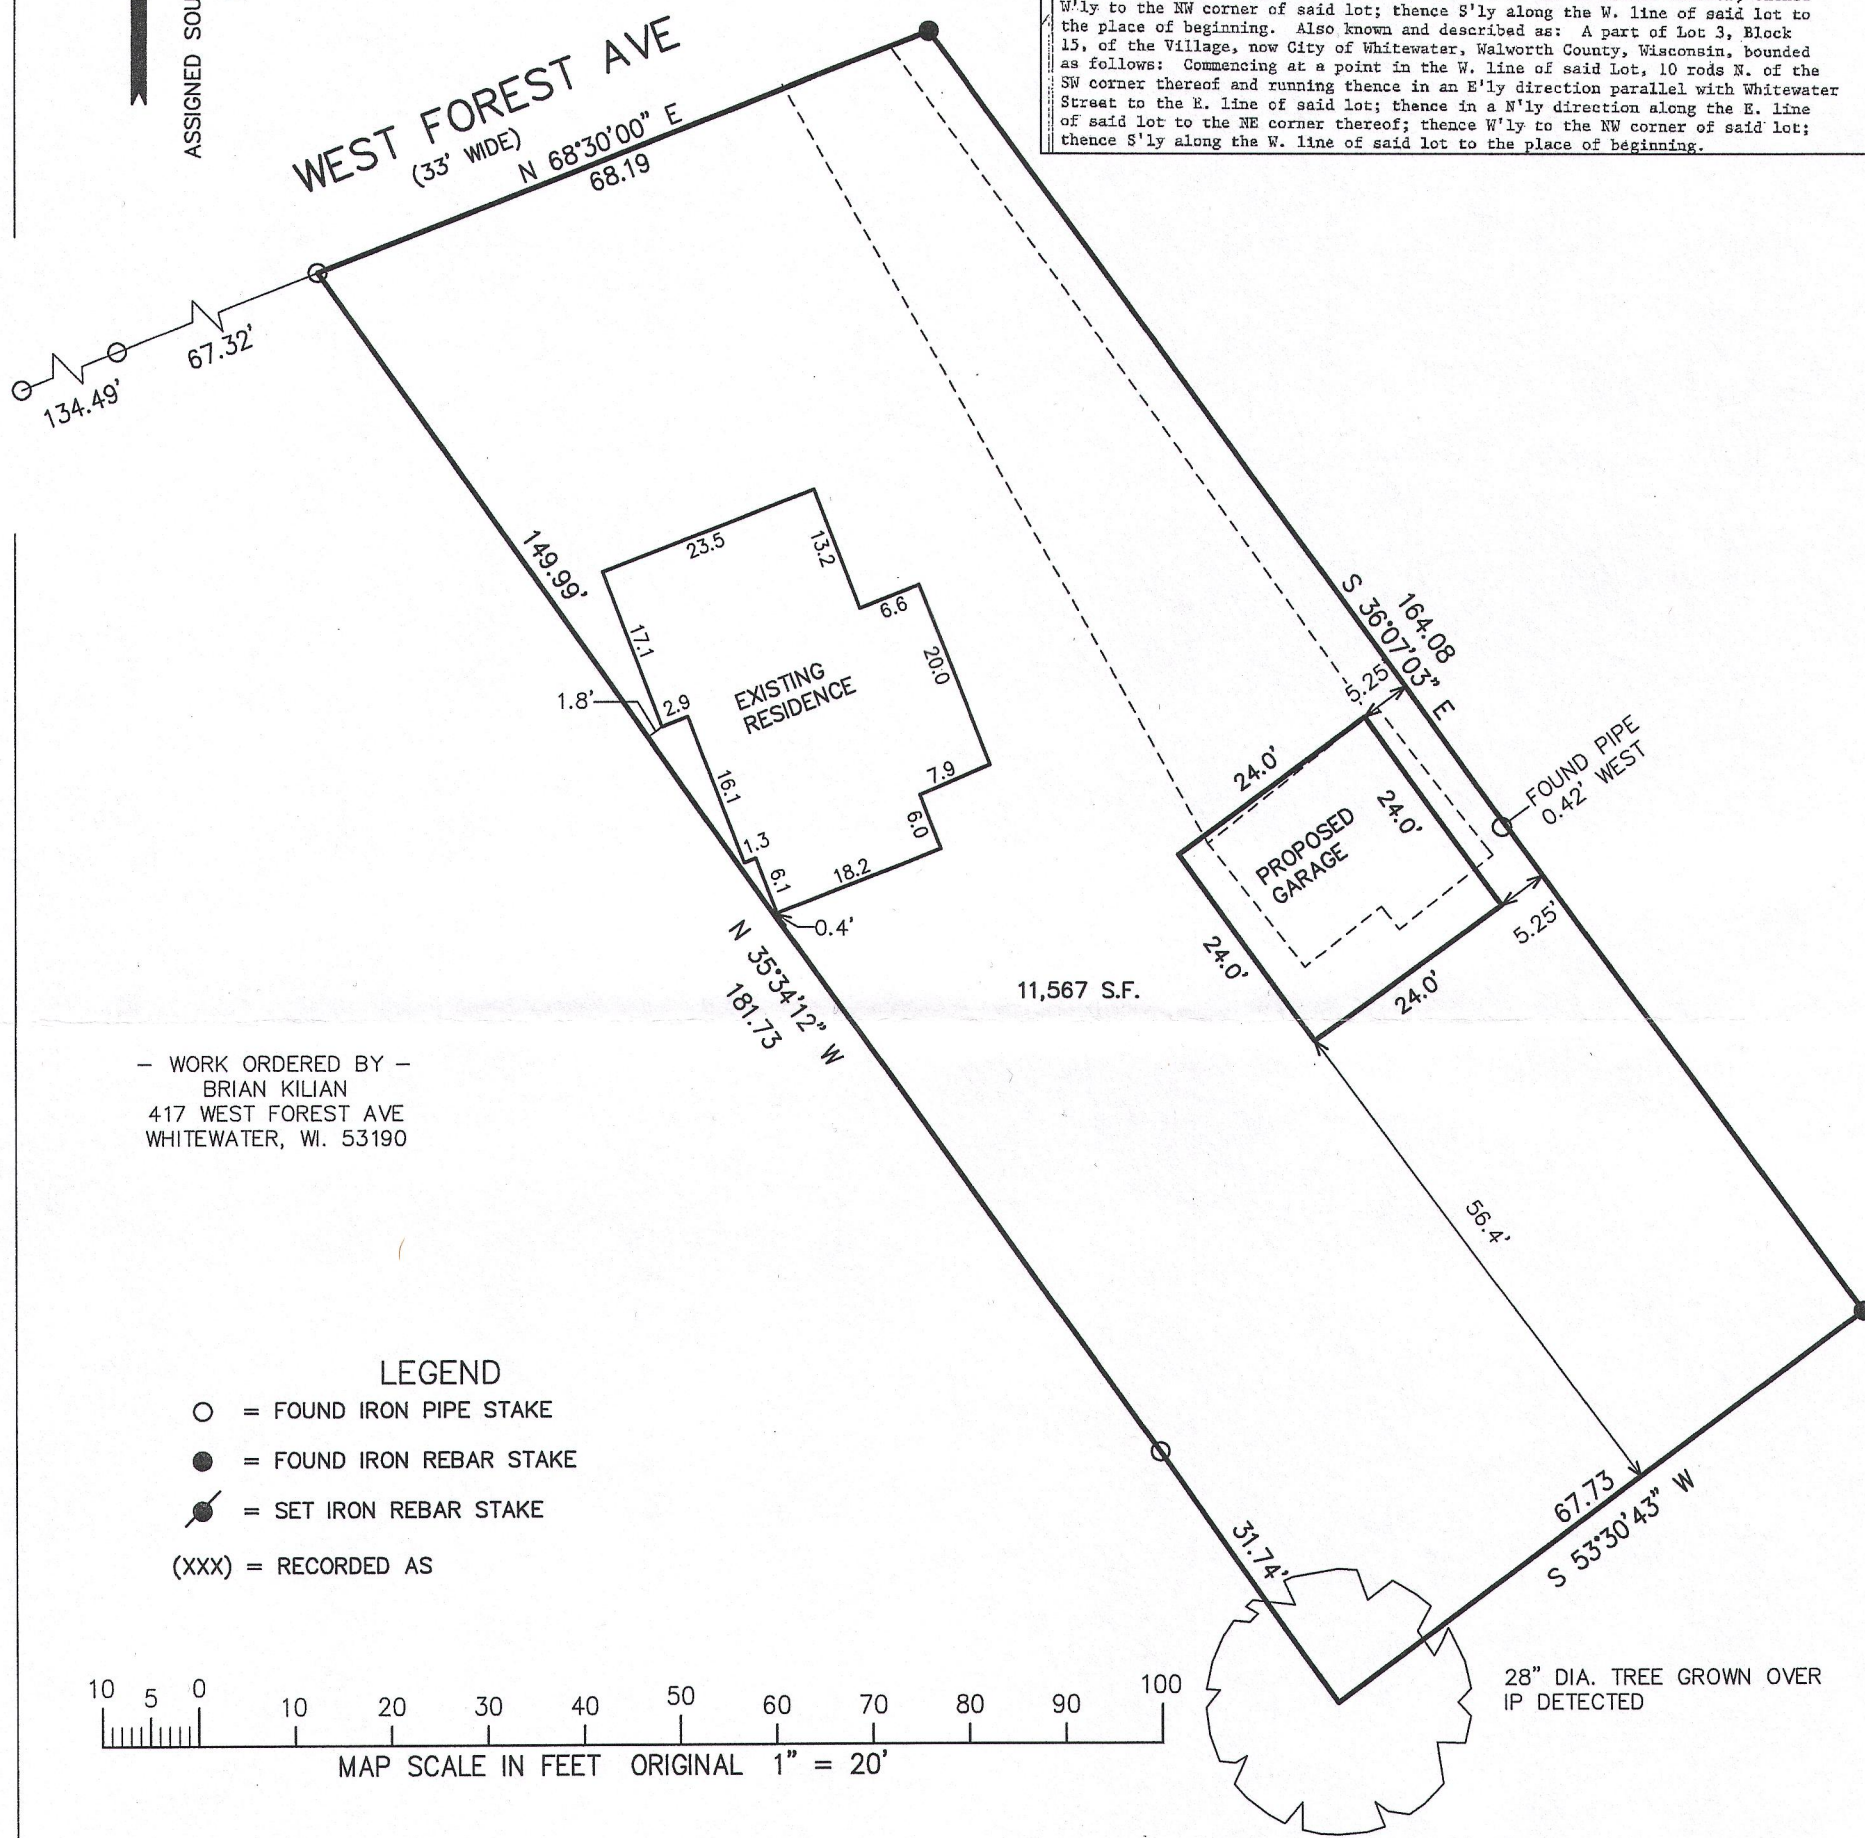


NOTE: COPIES OF THIS MAP TO WHICH THE FOLLOWING CERTIFICATE WILL APPLY SHOW THE SURVEYOR'S ORIGINAL SEAL AND SIGNATURE IN RED INK. COPIES BY ANY OTHER MEANS MAY HAVE ALTERATIONS WHICH DO NOT REPRESENT THE SURVEYOR'S WORK PRODUCT.

I HEREBY CERTIFY THAT THE ABOVE DESCRIBED PROPERTY HAS BEEN SURVEYED UNDER MY DIRECTION AND THAT THE ABOVE MAP IS A TRUE REPRESENTATION THEREOF AND SHOWS THE SIZE AND LOCATION OF THE PROPERTY AND ITS EXTERIOR BOUNDARIES. THIS SURVEY IS MADE FOR THE USE OF THE PRESENT OWNERS OF THE PROPERTY, AND ALSO THOSE WHO PURCHASE, MORTGAGE, OR GUARANTEE THE TITLE THERETO WITHIN ONE YEAR FROM THE DATE HEREOF.

DATED: FEBRUARY 19, 2015

PETER S. GORDON P.L.S. 2101

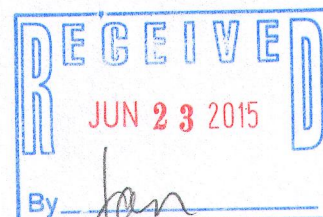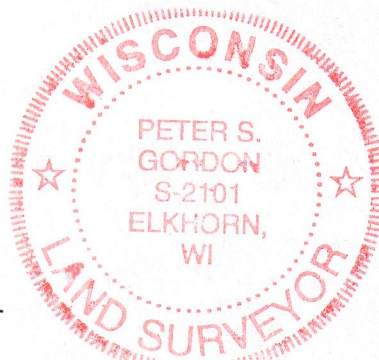

PROJECT: 9226
DATE: 02-12-2015
SHEET 1 OF 1

4/8/2015 X: \Projects\9226\DCAD\SURVEY

10T-181 010-969

APR 08 2015