

LAND-MARK SURVEYING

Mark L. Miritz

Wisconsin Registered Land Surveyor S-2582

N9330 Knuteson Drive
Whitewater, WI 53190
Phone: (262) 495-3284
FAX : (262) 495-8421
LAND-MARKSURVEYING.COM

MAPLE LANE
(60' WIDE)

LOT 6

10' UTILITY
& DRAINAGE
EASEMENT

N 00°00'02" E 66.01'

(N 89°57'38" E 139.33')

N 89°57'28" E 139.33'

EXISTING
FOUNDATION

LOT 7
11,192 SQ. FT.

60.4'

10' UTILITY AND
DRAINAGE EASE.

30'
TREE PRESERVATION
EASEMENT

S 00°00'02" W 66.03'

HOWARD ROAD

LEGEND



FOUND IRON PIPE



SET IRON ROD, 18" LONG, WEIGHING
1.5 LBS./LINEAL FT., 3/4" DIA.

(x x)

RECORDED AS DIMENSION

SCALE: 1 INCH = 20 FEET

"I hereby certify that the above described property has been surveyed by me or under my direction and that the above map is a true representation thereof and shows the size and location of the property, its exterior boundaries, the location of all visible structures and dimensions of all principal buildings thereon, boundary fences, apparent easements, roadways and visible encroachments, if any."
"This survey is made for the use of the present owners of the property, and also those who purchase, mortgage, or guarantee the title thereto within one year from date hereof."

MARK L. MIRITZ
WISCONSIN REGISTERED
LAND SURVEYOR S-2582


DATE: MARCH 5, 2015 JOB NO. 14.503

PLAT OF SURVEY

LOT 7 IN WALTON'S PINE BLUFF SUBDIVISION,
LOCATED IN PART OF THE SOUTHEAST 1/4 AND
THE SOUTHWEST 1/4 OF THE SOUTHEAST 1/4
OF SECTION 3, TOWN 4 NORTH, RANGE 15 EAST,
CITY OF WHITEWATER, WALWORTH COUNTY,
WISCONSIN.


OWNER: SCOTT M. KOWALSKI
N6417 DELANEY ROAD
WHITEWATER, WI 53190

JAKES WAY
(66' WIDE)

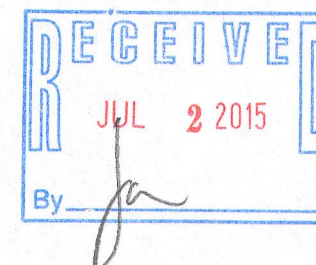

REVISED APRIL 16, 2015 TO
SHOW FOUNDATION "AS BUILT"

NO OUTLET

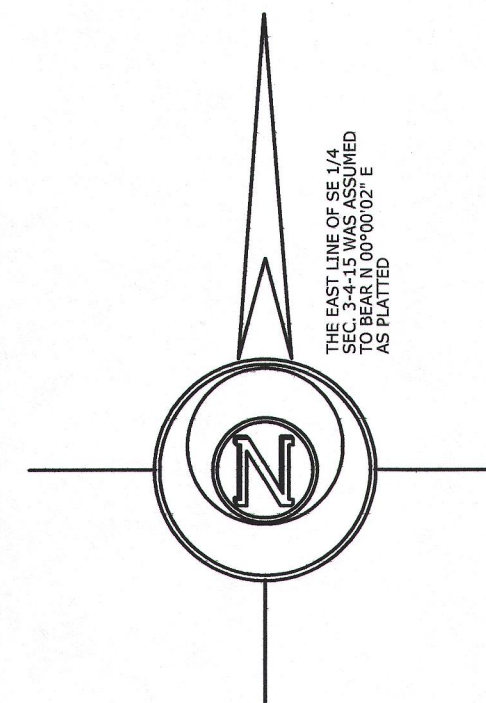

1 WPB-7

010-972