

LAND-MARK SURVEYING

Mark L. Miritz

Wisconsin Professional Land Surveyor S-2582


N9330 Knuteson Drive
Whitewater, WI 53190
Phone: (262) 495-3284
MARKMIRITZ@
LAND-MARKSURVEYING.COM

PLAT OF SURVEY

LOT 1, BLOCK 1, WARD ADDITION TO THE CITY OF WHITEWATER, LOCATED IN PART OF THE SOUTHWEST 1/4 OF THE NORTHWEST 1/4 OF SECTION 5, TOWN 4 NORTH, RANGE 15 EAST, CITY OF WHITEWATER, WALWORTH COUNTY WISCONSIN. EXCEPTING A STRIP OF LAND DESCRIBED AS FOLLOWS: THE NORTH 25 FEET OF THE EAST 68 FEET OF SAID LOT 1, BLOCK 1, WARD ADDITION. FURTHER EXCEPTING THE SOUTH 2 FEET FOR HIGHWAY PURPOSES.

ORDERED BY: JOE PYZYK
1238 W. MAIN ST.
WHITEWATER, WI 53190

SALISBURY LN.

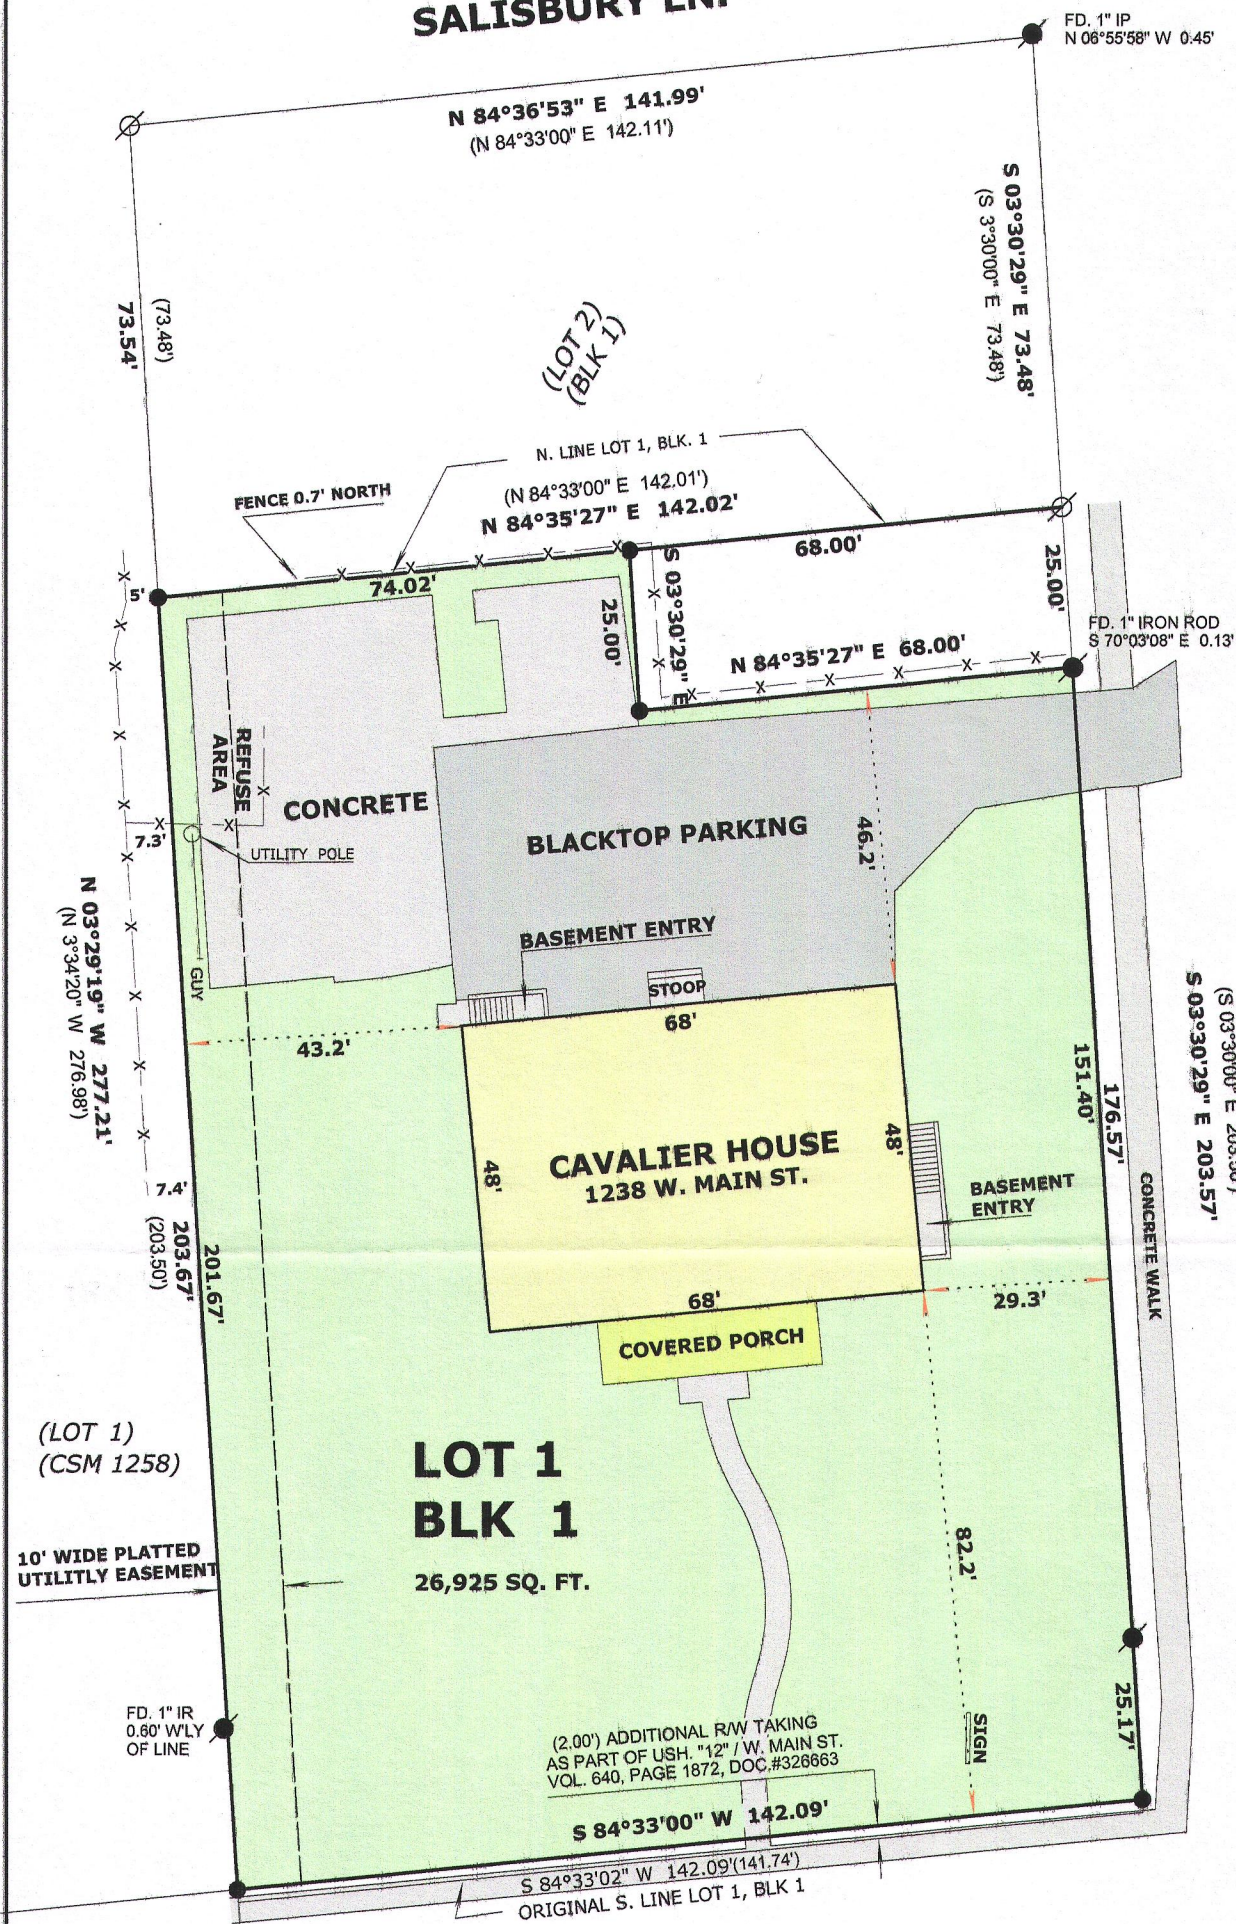

12TH PLACE
(66' WIDE)

LEGEND

- FOUND IRON PIPE 1 1/4"
- FOUND IRON ROD 1"
- FOUND COUNTY MONUMENT
- SET IRON ROD, 18" LONG, WEIGHING 1.5 LBS./LINEAL FT., 3/4" DIA.
- RECORDED AS DIMENSION
- EXISTING WOOD FENCE

SCALE: 1 INCH = 30 FEET


"I hereby certify that the above described property has been surveyed by me or under my direction and that the above map is a true representation thereof and shows the size and location of the property, its exterior boundaries, the location of all visible structures and dimensions of all principal buildings thereon, boundary fences, apparent easements, roadways and visible encroachments, if any." "This survey is made for the use of the present owners of the property, and also those who purchase, mortgage, or guarantee the title thereto within one year from date hereof."

Mark L. Miritz
MARK L. MIRITZ
WISCONSIN PROFESSIONAL
LAND SURVEYOR S-2582

DATE: JUNE 10, 2015 JOB NO. 15.602

W. MAIN ST.

N 84°33'00" E 2599.07'
WIDTH VARIES

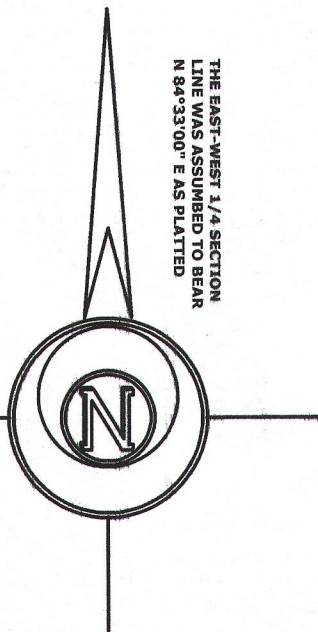

THE EAST-WEST 1/4 SECTION
LINE WAS ASSUMED TO BEAR
N 84°33'00" E AS PLATTED

WEST 1/4 CORNER
SECTION 5-4-15

CENTER OF
SEC. 5-4-15