


PLAT OF SURVEY

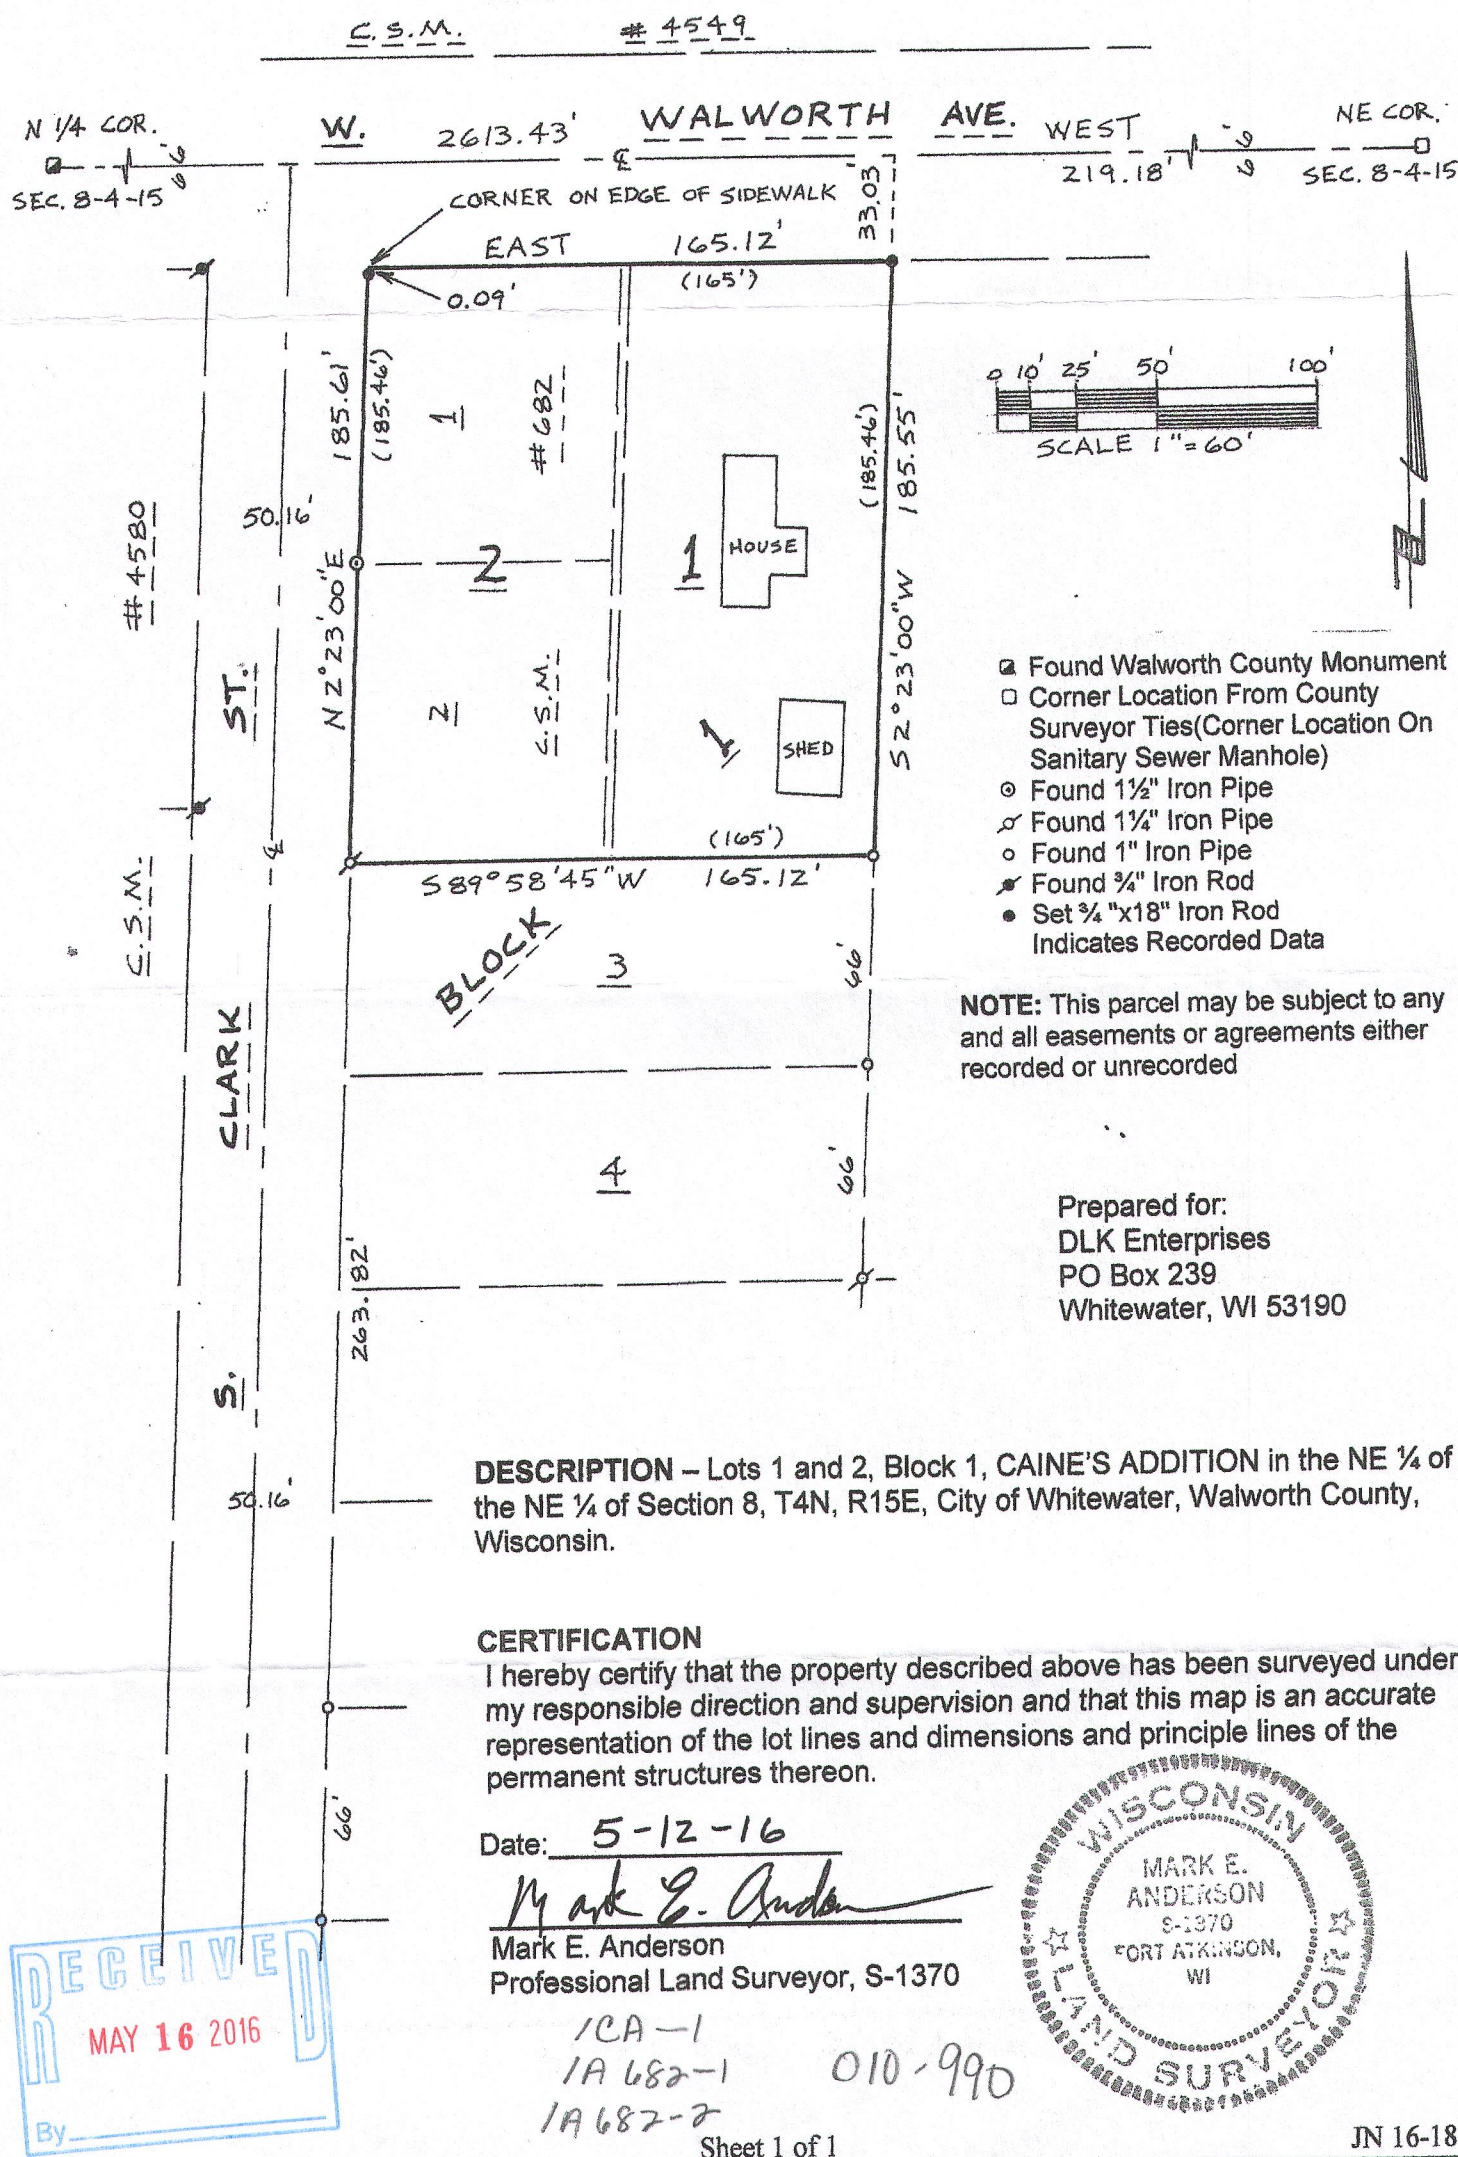

ANDERSON LAND SURVEYING LLC
W 6141 Star School Road, Fort Atkinson, WI 53538

Professional Land Surveyor
Phone (920) 563-8162