

Lot 52

Lot 51

Lot 50

Overhead Wires

S89°42'57"E 59.84'

Guy

Overhead Wires

# Plat of Survey


of

## Lot 6 of Jewell's Subdivision,


located in the Northeast 1/4 of the Southeast 1/4 of Section 1, Town 1 North, Range 16 East, Village of Williams Bay, Walworth County, Wisconsin.

Surveyed for: **Peter Forster**

4052 North Springfield Avenue  
Chicago, Illinois. 60618

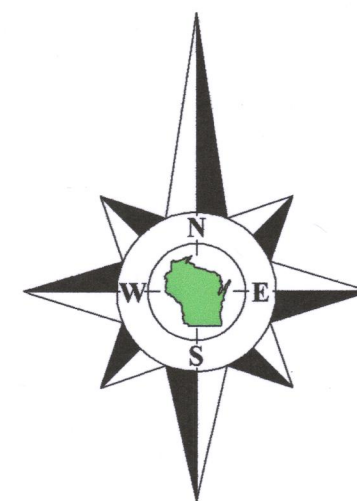

Bearings referenced to the South line of Jewell Drive, recorded as N89°38'29"W on a prior survey of Lot 32 of Lackey Brothers' Subdivision dated August 25, 2011.

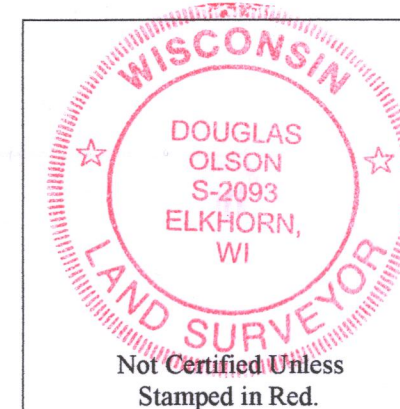

### Notes:

- 1) This Plat of Survey is not certified unless signed and sealed in red ink.
- 2) This survey is subject to Wisconsin lien laws. This Plat of Survey is the notice of intent to file lien. Lien waiver required.
- 3) The Survey Date shown on this Plat of Survey is the completion date of the field work.

Sanitary Manhole  
Rim Elev.=112.49  
Inv. Elev.=102.6

Sanitary Manhole  
Rim Elev.=100.00 - Assumed  
Inv. Elev.=86.5

## Jewell Drive

(30' Wide)



Lot 32  
Lackey Brothers' Subdivision  
See survey dated August 25, 2011.

Copyright© 2017 by Olson Land Surveying, LLC.

All rights reserved. No part of this survey plat may be reproduced or transmitted in any form by any means - graphic, electronic, or mechanical, including photocopying, tracing, or information storage and retrieval systems - without permission in writing from Douglas G. Olson, Olson Land Surveying, LLC.

I hereby certify that I have surveyed the above described property in compliance with Chapter A-E 7 of the Wisconsin Administrative Code and that the map hereon is correct to the best of my knowledge and belief.

Douglas G. Olson  
Wisconsin Professional Land Surveyor - 2093

Sheet 1 of 1 Sheets

Drawing Name:

Job Reference Number  
**2017.034**

### Legend of Symbols & Abbreviations

- Found Iron Pipe
- Set Wood Lath
- Recorded Information
- Utility Pole
- Manhole
- Water Valve
- Asphalt Surface
- Deciduous Tree

N North  
S South  
E East  
W West  
In Bearings  
° Degrees  
' Minutes  
" Seconds  
In Distances  
Feet  
Inches



45 South Wisconsin Street | P.O. Box 322  
Elkhorn, Wisconsin. 53121  
Telephone: (262) 723-3434  
Facsimile: (262) 723-8044  
Email: doug@olsonsurveying.com  
Website: www.olsonsurveying.com

Scale in Feet  
1" = 10'



Survey Date: April 20, 2017.  
Revisions:

2017.034

WJ-5 011-2783