
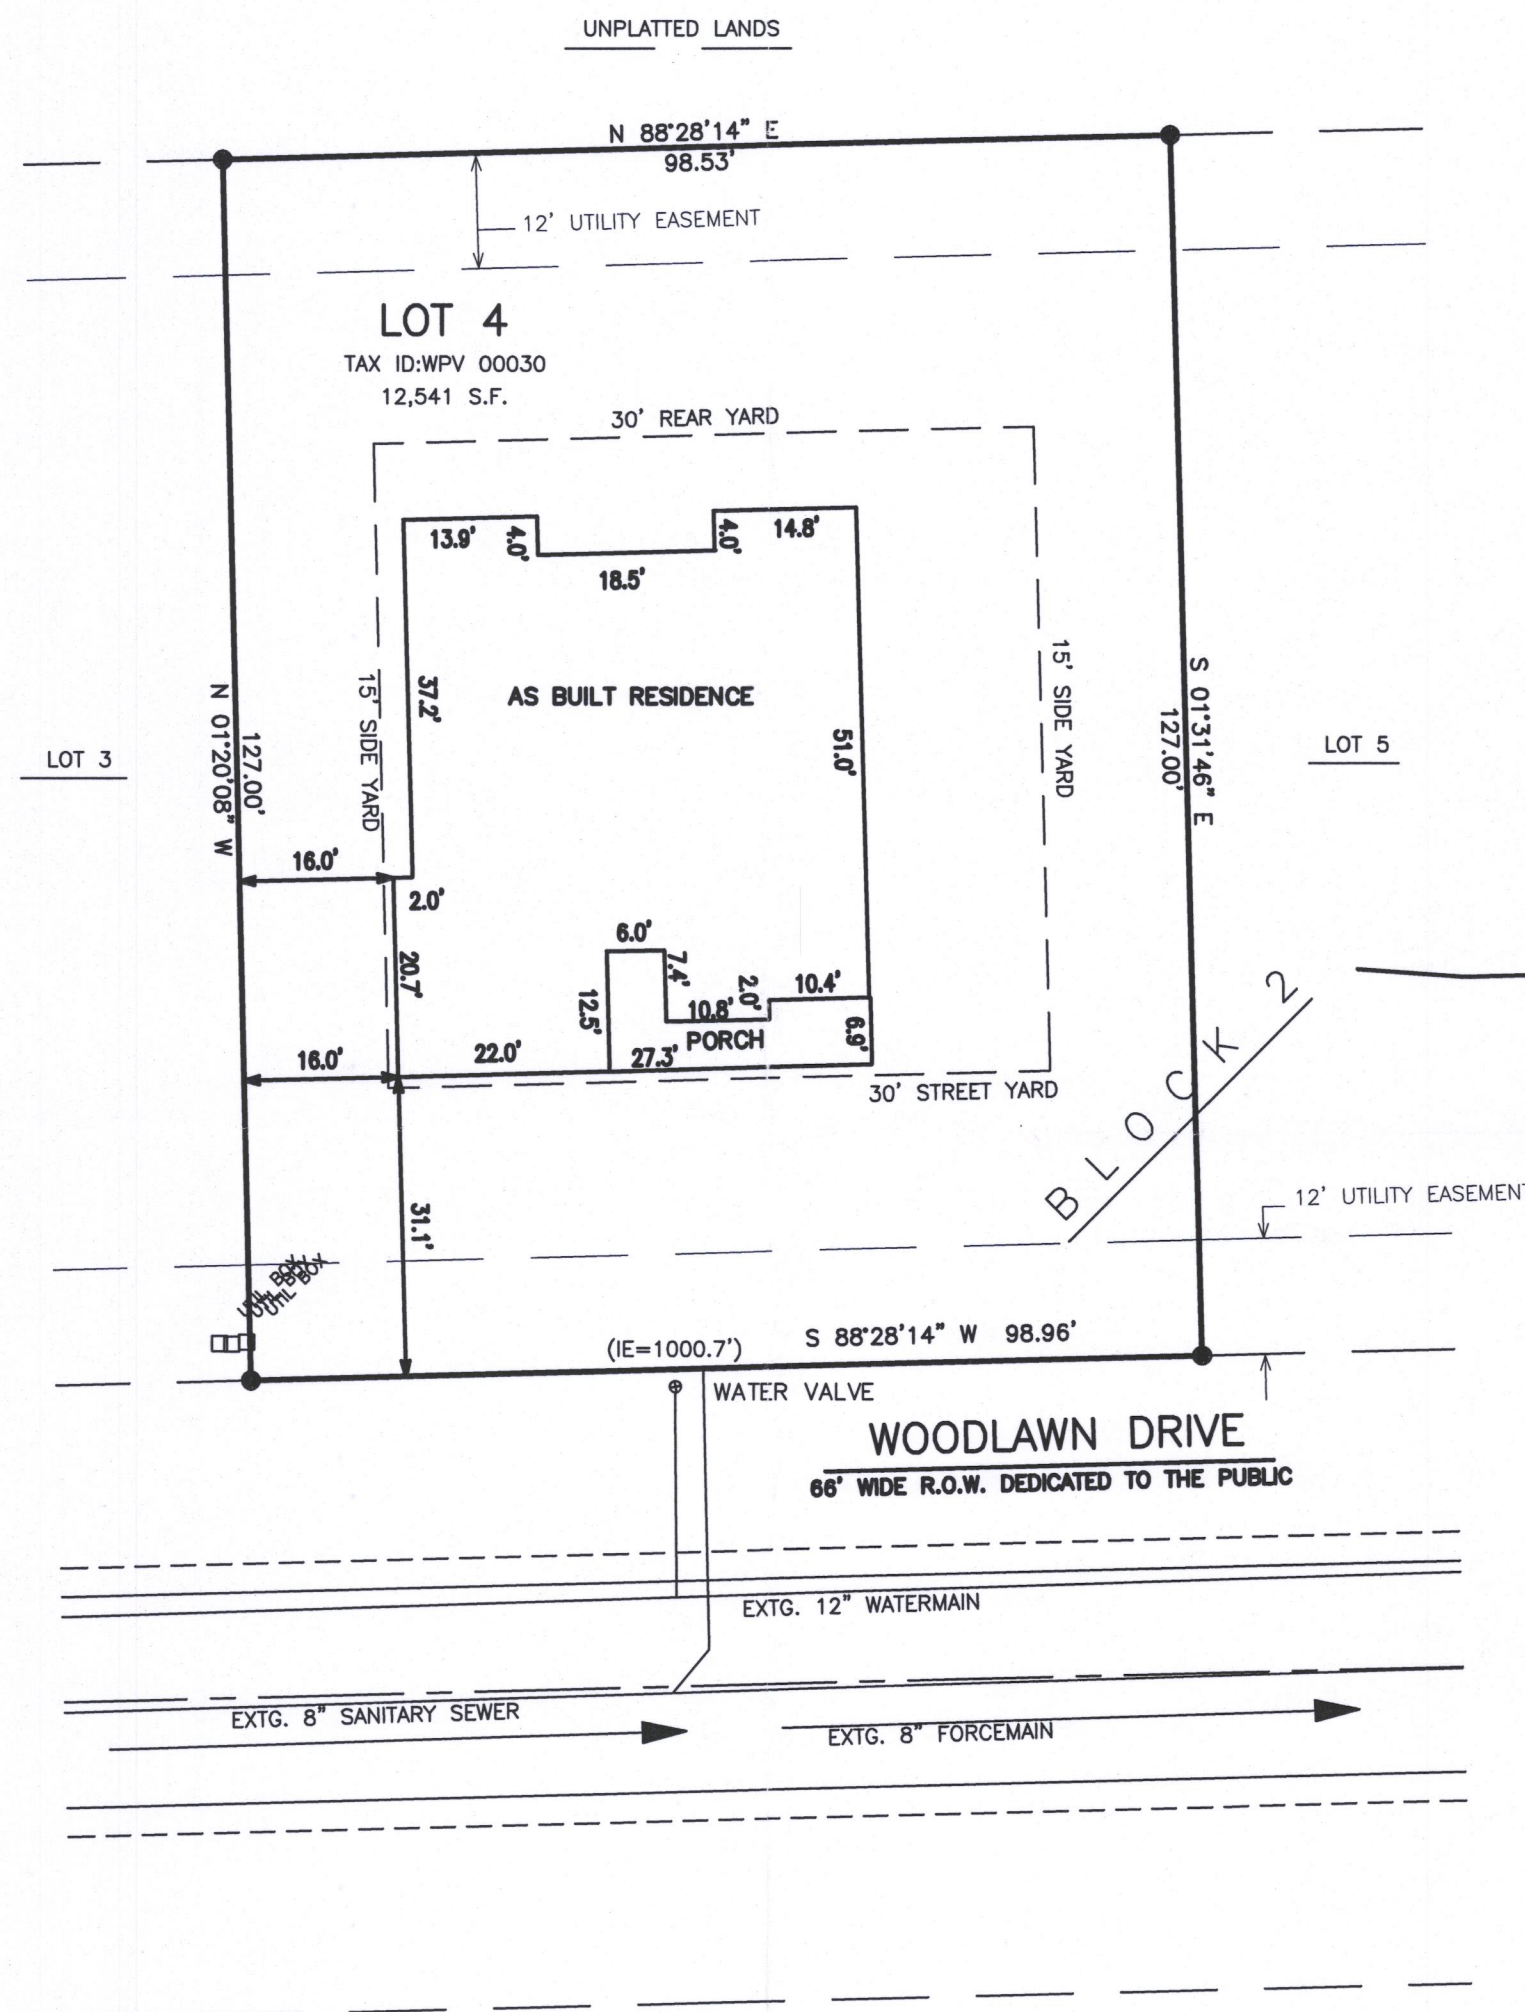


— WORK ORDERED BY —
SHODEEN — MIKE PTACK
17 N. 1ST STREET — SUITE 7
GENEVA, IL 60134

FARRIS, HANSEN & ASSOCIATES, INC.
ENGINEERING - ARCHITECTURE - SURVEYING
7 RIDGWAY COURT P.O. BOX 437
ELKHORN, WISCONSIN 53121
OFFICE: (262) 723-2098 FAX: (262) 723-5886


REVISIONS
08/24/2017 - LB ADD PROP. RES.
12/07/2017 - LB AS BUILT

PROJECT NO. 5825.02.04
DATE: 07/29/2005
SHEET NO. 1 OF 1

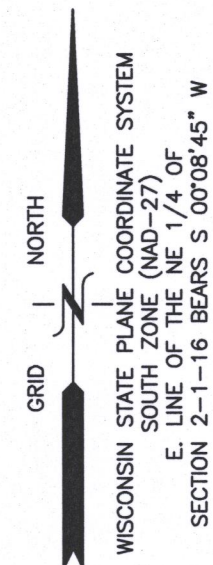

- = FOUND IRON PIPE STAKE, 1 3/8" O.D.
- ✦ = FOUND IRON REBAR STAKE, 3/4" DIA.
- ▣ = FOUND CONCRETE COUNTY MONUMENT
WITH BRASS CAP
- = SET SOLID ROUND IRON BAR STAKE,
1 5/16" x 30" x 4.60 lbs./ft.
- {XXX} = RECORDED AS

ALL OTHER LOT AND OUTLOT CORNERS ARE
SET IRON REBAR STAKES, 3/4" x 24" x
1.50 lbs./ft.

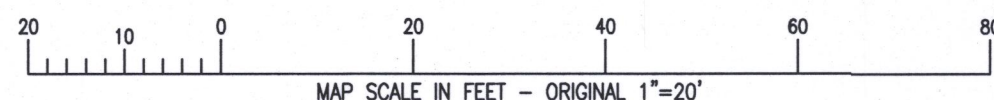

NOTE: COPIES OF THIS MAP TO WHICH THE FOLLOWING CERTIFICATE WILL APPLY SHOW THE SURVEYOR'S ORIGINAL SEAL AND SIGNATURE IN RED INK. COPIES BY ANY OTHER MEANS MAY HAVE ALTERATIONS WHICH DO NOT REPRESENT THE SURVEYOR'S WORK PRODUCT.

I HEREBY CERTIFY THAT THE ABOVE DESCRIBED PROPERTY HAS BEEN SURVEYED UNDER MY DIRECTION AND THAT THE ABOVE MAP IS A TRUE REPRESENTATION THEREOF AND SHOWS THE SIZE AND LOCATION OF THE PROPERTY AND ITS EXTERIOR BOUNDARIES. THIS SURVEY IS MADE FOR THE USE OF THE PRESENT OWNERS OF THE PROPERTY, AND ALSO THOSE WHO PURCHASE, MORTGAGE, OR GUARANTEE THE TITLE THERETO WITHIN ONE YEAR FROM THE DATE HEREOF.

DATED: JULY 29, 2005

12/07/2017 REVISED TO
SHOW SIZE AND LOCATION
OF AS BUILT RESIDENCE.

BMC
BRIAN M. CARLSON P.L.S. 2039

WPV-30

011-2811

Path: \PROJECTS\5825\INDIV LOTS\BLOCK_2\LOT_4\ACAD\5825-02-04.DWG