


PLAT OF SURVEY


**LOT 55 OF BAYWOOD HEIGHTS ADDITION NO. 2
IN THE VILLAGE OF WILLIAMS BAY, WALWORTH
COUNTY, WISCONSIN, ACCORDING TO THE PLAT
THEREOF RECORDED IN THE OFFICE OF THE
WALWORTH COUNTY REGISTER OF DEEDS IN
CABINET "B" OF PLATS ON SLIDE 97 AS
DOCUMENT NO. 197248.**

SANITARY SEWER MANHOLE
RIM ELEV. = 104.0'
I.E. = 90.6'

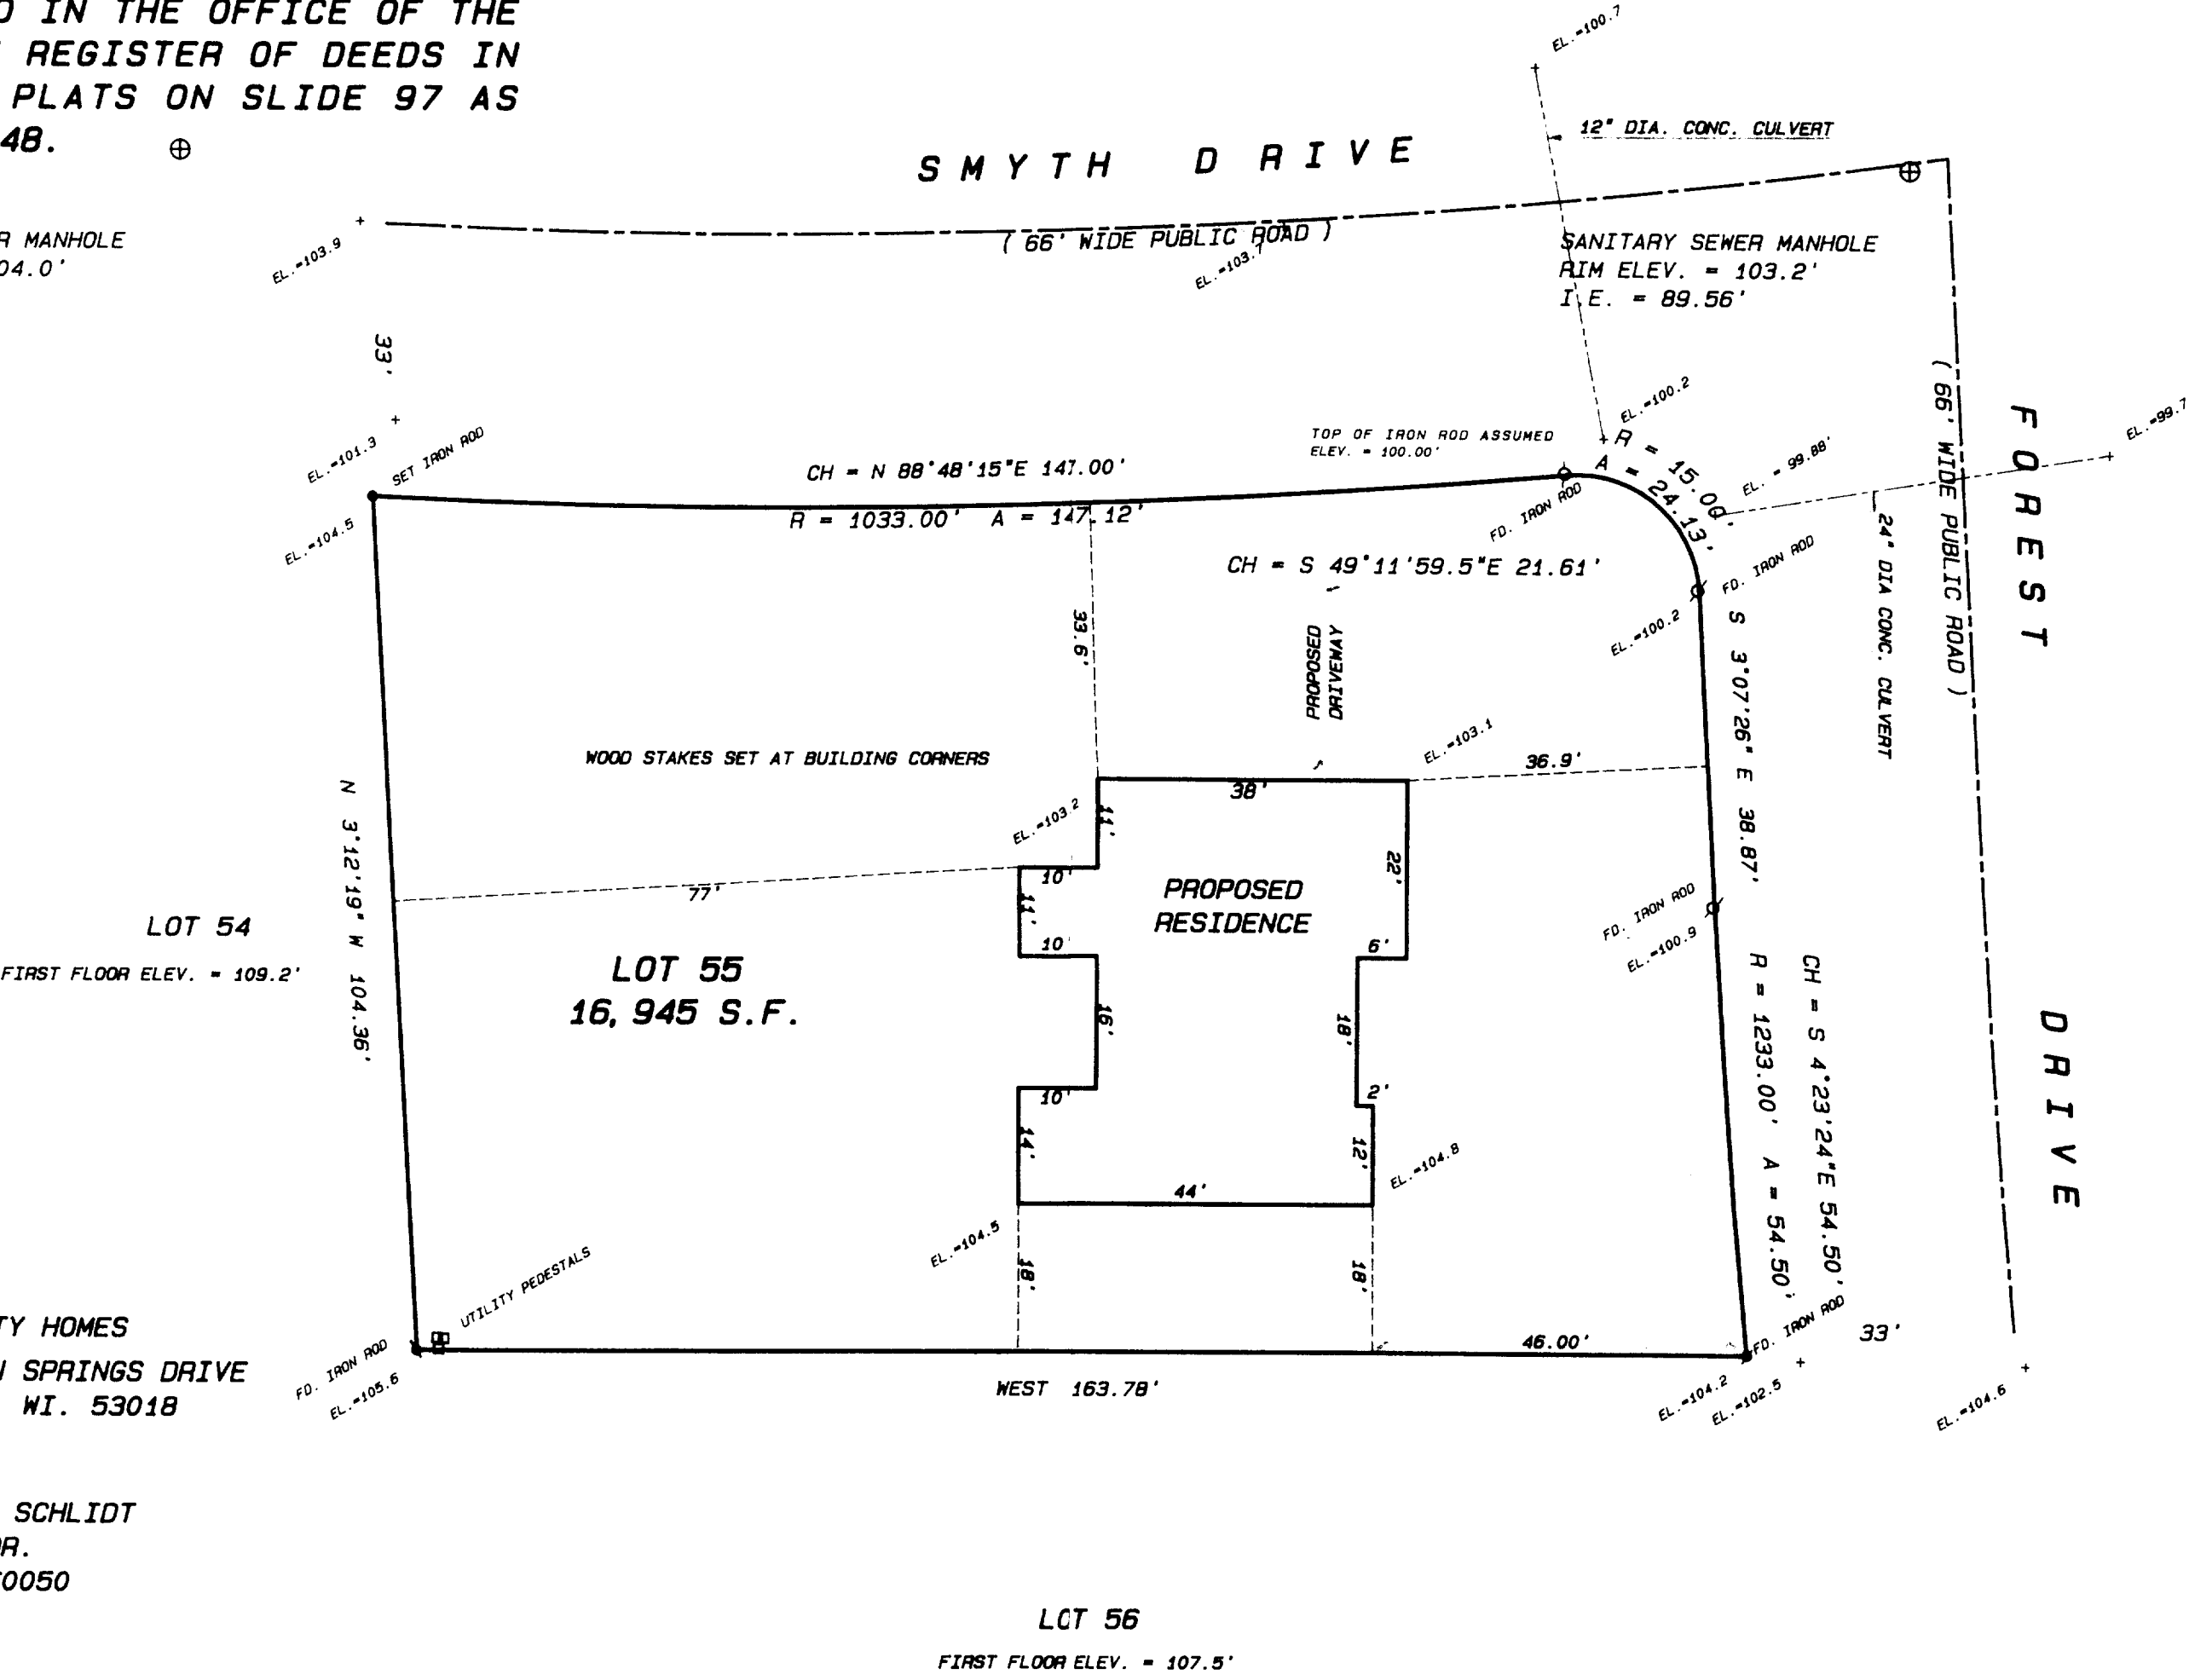


ORDERED BY: OPPORTUNITY HOMES
740 INDIAN SPRINGS DRIVE
DELAFIELD, WI. 53018


OWNERS: JOHN AND KAREN SCHLIDT
3116 BIETONS DR.
MCHENRY, IL. 60050

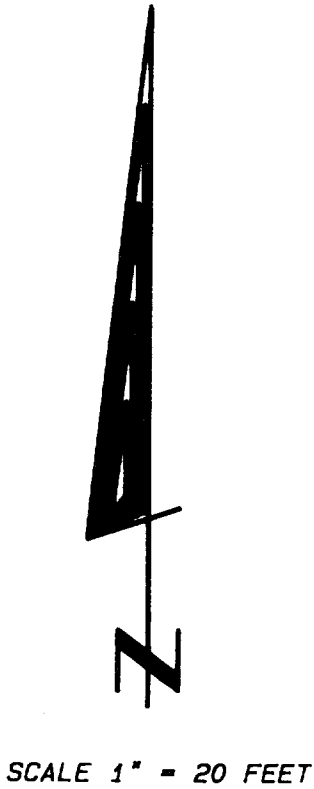

- Legend**
- FOUND IRON PIPE
 - FOUND IRON ROD
 - FOUND BRASS CAPPED MONUMENT
 - FOUND CONCRETE MONUMENT
 - CHISEL CUT IN CONCRETE
 - SET IRON ROD, 24" LONG, WEIGHING 1.5 LBS./LINEAL FT., 3/8" DIA.
 - SET IRON ROD, 30" LONG, WEIGHING 4.5 LBS./LINEAL FT., 1-11/16" DIA.
 - (xx) RECORDED AS DIMENSION
 - EXISTING FENCE

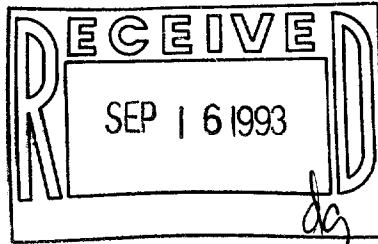

SCALE: 1" = 20 FEET

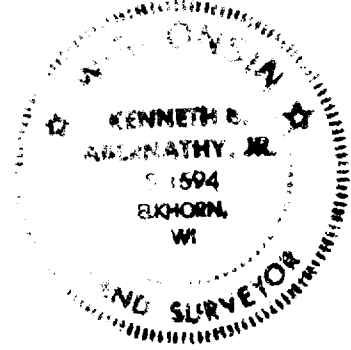

"I hereby certify that I have surveyed the above described property and that the above map is a true representation thereof and shows the site and location of the property, its exterior boundaries, the location of all visible structures and dimensions of all principal buildings thereon, boundary fences, apparent easements, roadways and visible encroachments, if any."

"This survey is made for the use of the present owners of the property, and also those who purchase, mortgage, or guarantee the title thereto within one year from date hereof."

Kenneth B. Abernathy, Jr.
KENNETH B. ABERNATHY, JR.
WISCONSIN REGISTERED LAND SURVEYOR,
S-1594
Date: Aug. 11, 1993 Job No. 93.809

PLAT OF SURVEY

LOT 55 OF BAYWOOD HEIGHTS ADDITION NO. 2
IN THE VILLAGE OF WILLIAMS BAY, WALNORTH
COUNTY, WISCONSIN, ACCORDING TO THE PLAT
THEREOF RECORDED IN THE OFFICE OF THE
WALNORTH COUNTY REGISTER OF DEEDS IN
CABINET "B" OF PLATS ON SLIDE 97 AS
DOCUMENT NO. 197248.

SANITARY SEWER MANHOLE
RIM ELEV. = 104.0'
I.E. = 90.6'

LOT 54
FIRST FLOOR ELEV. = 109.2'


LOT 55
16,945 S.F.

ORDERED BY: OPPORTUNITY HOMES
740 INDIAN SPRINGS DRIVE
DELAFIELD, WI. 53018


OWNERS: JOHN AND KAREN SCHLIDT
3116 BIETONS DR.
MCHEENY, IL. 60050

SMYTH DRIVE

FOREST DRIVE

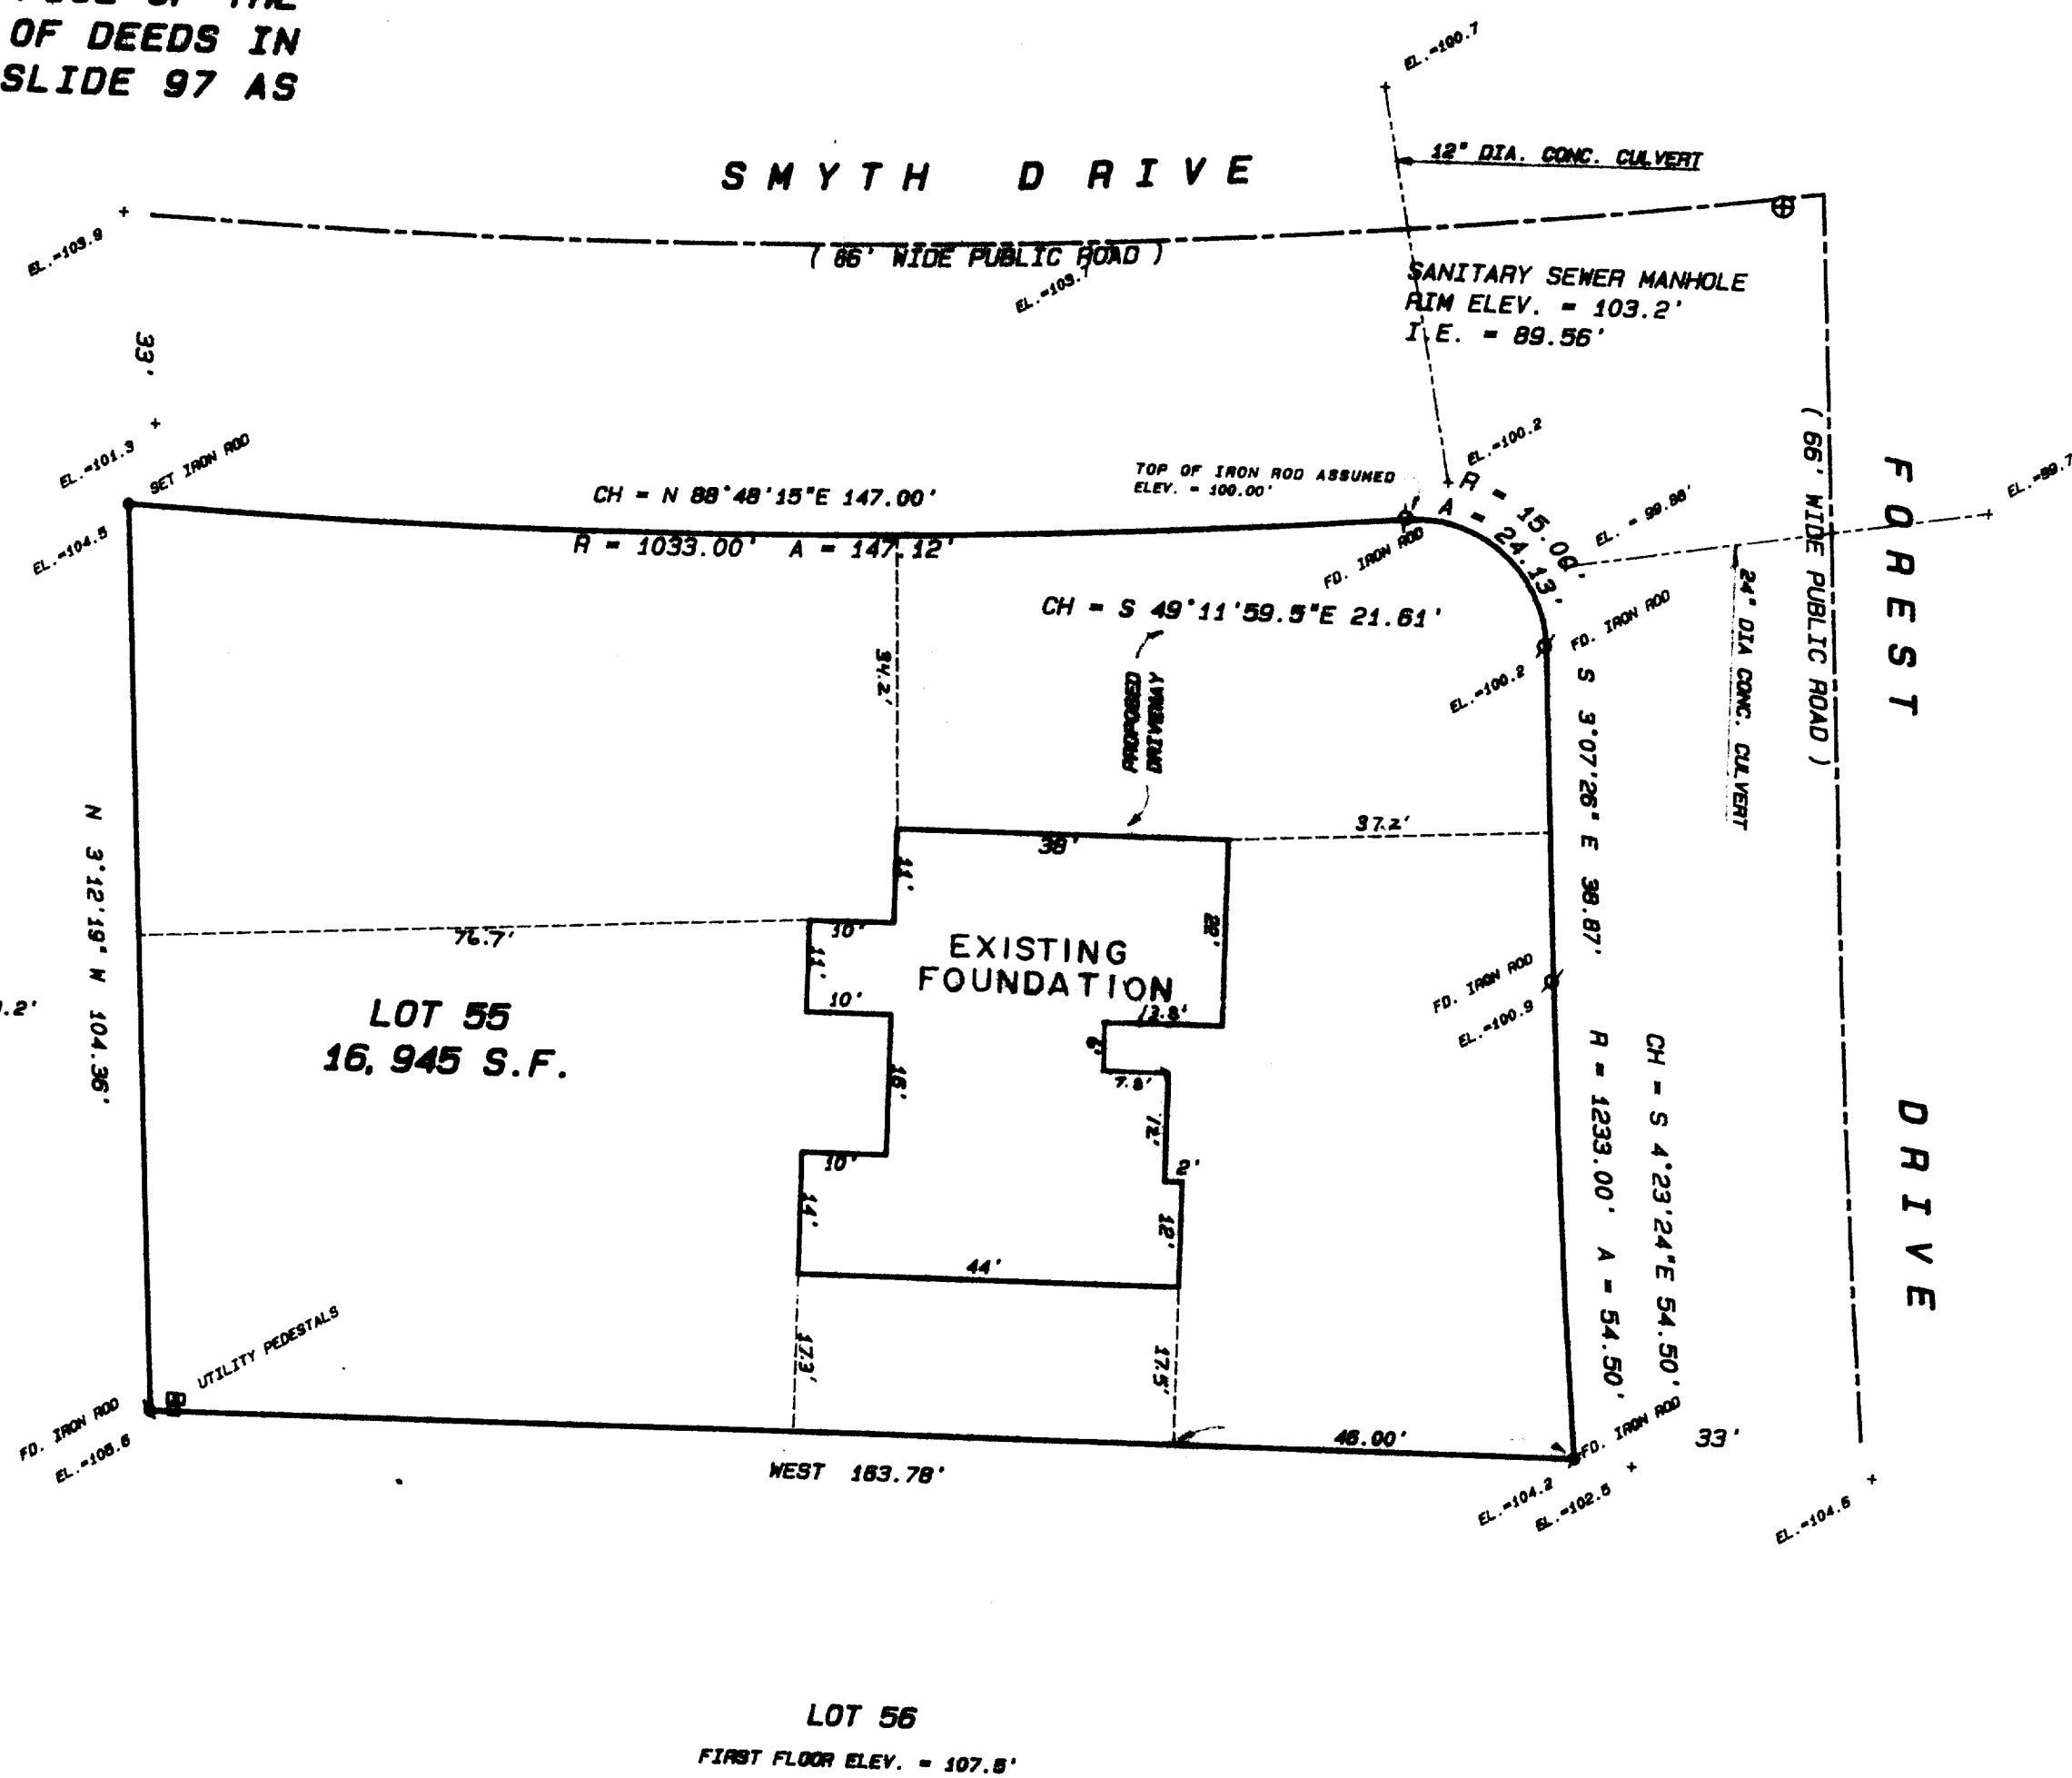

SCALE 1" = 20 FEET

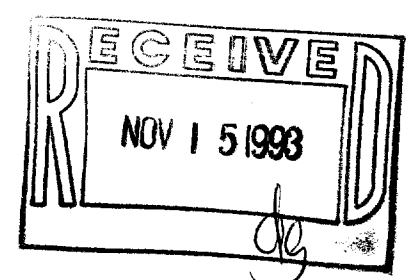

Legend

- FOUND IRON PIPE
- FOUND IRON ROD
- FOUND BRASS CAPPED MONUMENT
- FOUND CONCRETE MONUMENT
- CHISEL CUT IN CONCRETE
- SET IRON ROD, 28" LONG, WEIGHING 1.5 LBS./LINEAL FT., 3/4" DIA.
- SET IRON ROD, 30" LONG, WEIGHING 4.5 LBS./LINEAL FT., 1-11/16" DIA.
- RECORDED AS DIMENSION
- EXISTING FENCE

SCALE: 1" = 20 FEET



"I hereby certify that I have surveyed the above described property and that the above map is a true representation thereof and shows the size and location of the property, its exterior boundaries, the location of all visible structures and dimensions of all principal buildings thereon, boundary fences, apparent easements, roadways and visible encroachments, if any."

"This survey is made for the use of the present owners of the property, and also those who purchase, mortgage, or guarantee the title thereto within one year from date hereof."

Kenneth S. Abernathy, Jr.
KENNETH S. ABERNATHY, JR.
WISCONSIN REGISTERED LAND SURVEYOR,
S-1594
Date: Aug. 11, 1993 Job No. 98-809
REVISED 10-4-93