




SCALE 1"=20'
O = IRON STAKE

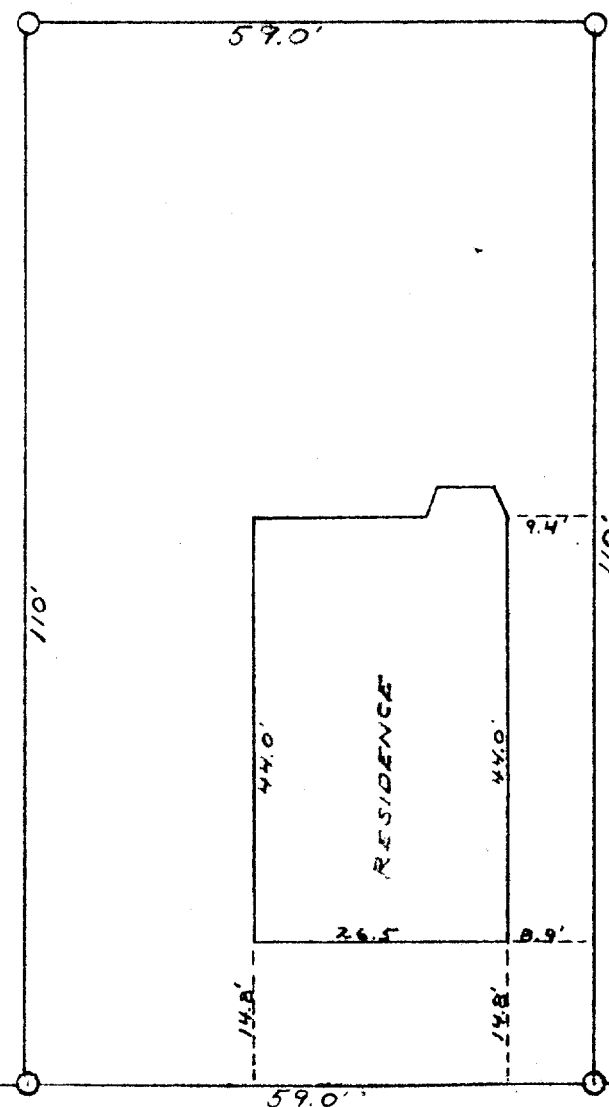

S.E. CORNER LOT 1
OF THE ORIGINAL
PLAT OF WILKS BAY

ELM

STREET

WALWORTH

I CERTIFY THAT THE ABOVE IS A TRUE AND CORRECT PLAT OF A SURVEY MADE BY ME THIS 17TH DAY OF FEBRUARY, 1951, OF A PARCEL OF LAND DESCRIBED AS FOLLOWS: BEGINNING AT AN IRON STAKE IN THE SOUTH LINE OF LOT 1, BLOCK 4 OF THE ORIGINAL VILLAGE OF WILLIAMS BAY, WALWORTH COUNTY, WISCONSIN, 250 FEET WEST OF THE SOUTH-EAST CORNER OF SAID LOT; THENCE NORTH 110 FEET TO AN IRON STAKE; THENCE WEST 59 FEET TO AN IRON STAKE; THENCE SOUTH 110 FEET TO AN IRON STAKE; THENCE EAST 59 FEET TO THE PLACE OF BEGINNING.
SAID PLAT SHOWS THE LOCATION AND DIMENSIONS OF ALL BUILDING IMPROVEMENTS, EASEMENTS OR RIGHTS OF WAY IN EVIDENCE OR KNOWN TO ME, AND ENCROACHMENTS BY OR ON THE PREMISES.
DATED FEBRUARY 19, 1951

OP-61

H. E. Johnson
SURVEYOR

11-100J