


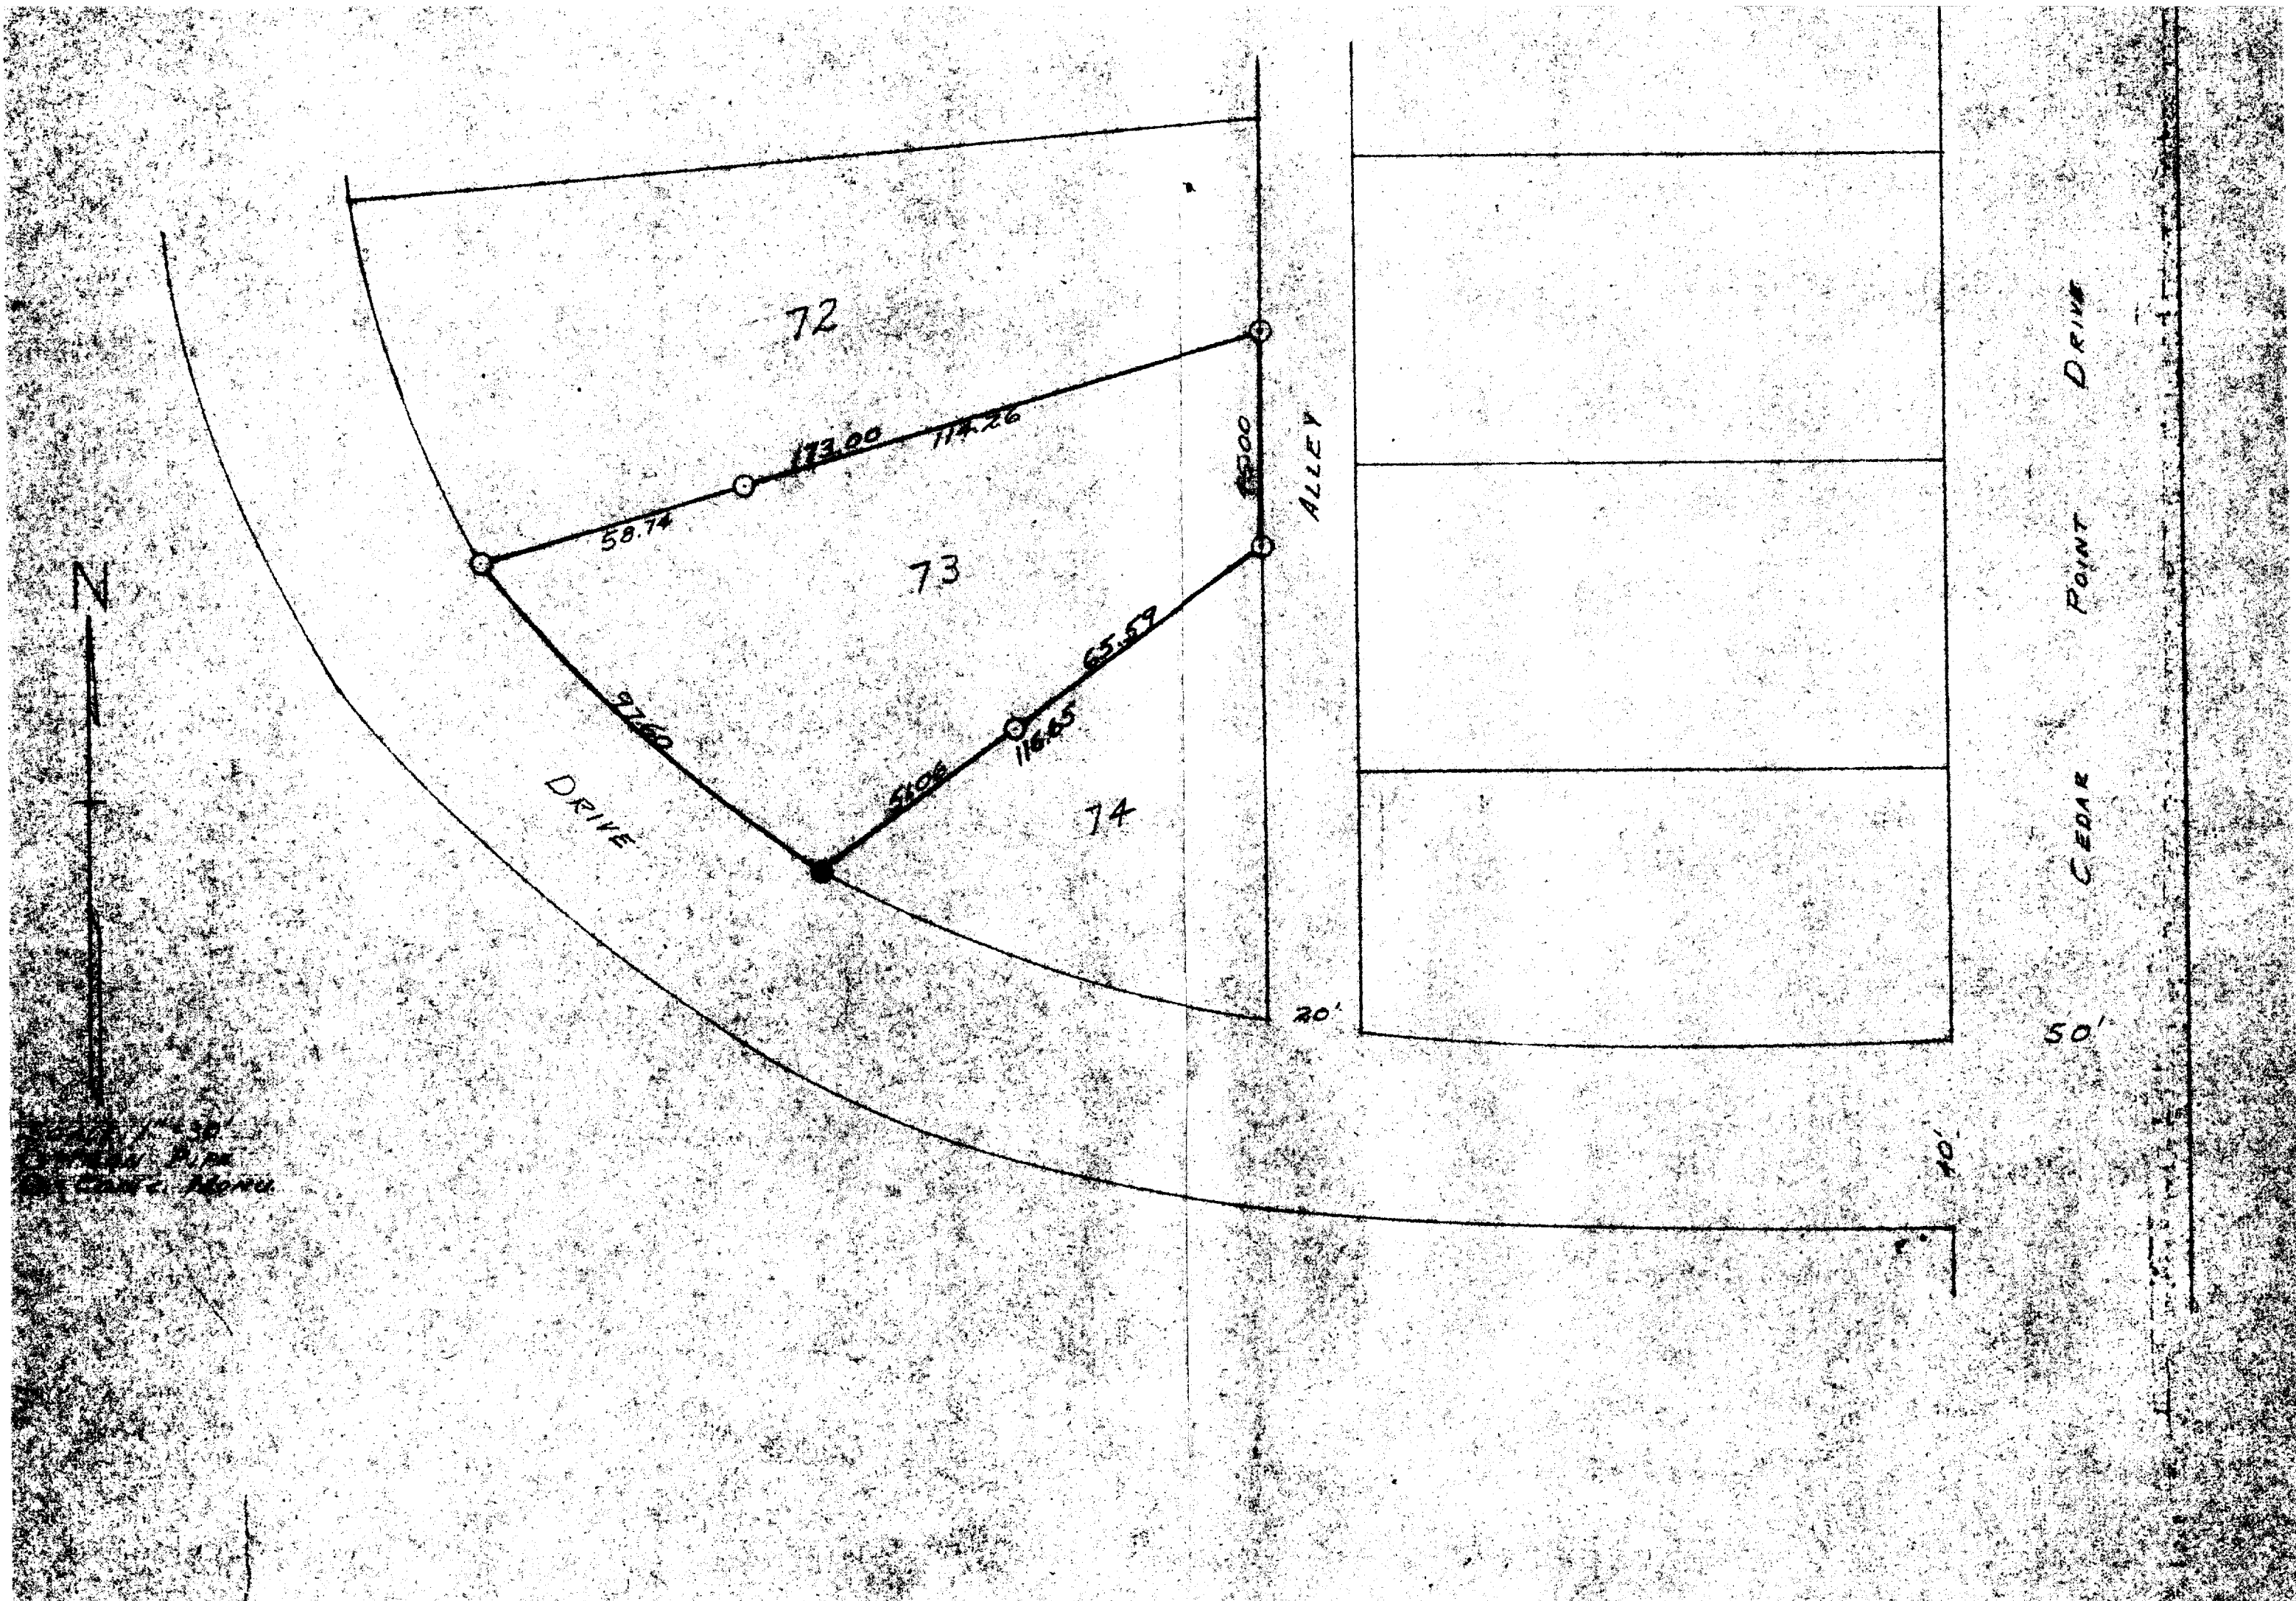

PLAT OF SURVEY OF LOT 73, 1ST ADDITION TO CEDAR POINT PARK, VILLAGE OF WILLIAMS BAY, WALNORTH COUNTY, WISCONSIN.

MAY 1951

Lloyd L. Lunn
 COUNTY SURVEYOR

11-101 J