


HAROLD H. KOLB

REGISTERED PROFESSIONAL LAND SURVEYOR
LAKE GENEVA, WISCONSIN

JACKSON PARKWAY

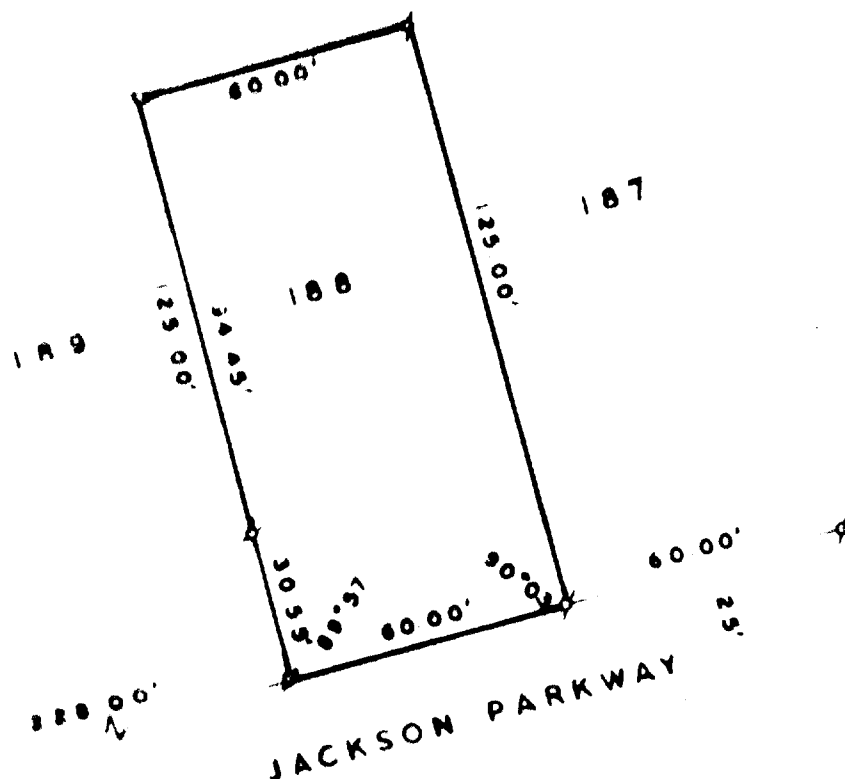

N



SCALE 1" = 40'

LEGEND

- IT - IRON PIPE FOUND
- IP - IRON PIPE PLACED
- - CONCRETE MONUMENT
- X - SPIKE



PLAT OF LOT 188

LOT 188, Cedar Point Park Subd.,
TIN, R1/2, Village of Williams
Bay, Walworth County, Wisconsin

I, HAROLD H. KOLB, DO HEREBY CERTIFY THAT I HAVE
SURVEYED THE PROPERTY HEREON DESCRIBED ACCORDING
TO THE OFFICIAL RECORDS, AND THAT THE PLAT HEREON
IS A CORRECT REPRESENTATION OF THE LOT LINES.

Harold H. Kolb

HAROLD H. KOLB

WISCONSIN REGISTERED LAND SURVEYOR, S-187

DATE April 17, 1969

WCP-162

11-102