


I HEREBY CERTIFY THAT I HAVE VIEWED THE LAST MENTIONED ABOVE AND THAT THE PLAT DRAWN HEREIN IS A CORRECT REPRESENTATION OF SAID SURVEY. I FURTHER CERTIFY THAT THE BUILDINGS ON SAID LAND ARE LOCATED AS SHOWN ON THIS PLAT.

A circular seal with a double-lined border. The outer ring contains the text "WISCONSIN" at the top and "LAND SURVEYOR" at the bottom, separated by two five-pointed stars on the left and right. The center of the seal contains the text "JOHN E. DEGEN" in a large, bold, serif font, with "BURLINGTON, WIS." in a smaller, bold, serif font directly below it.

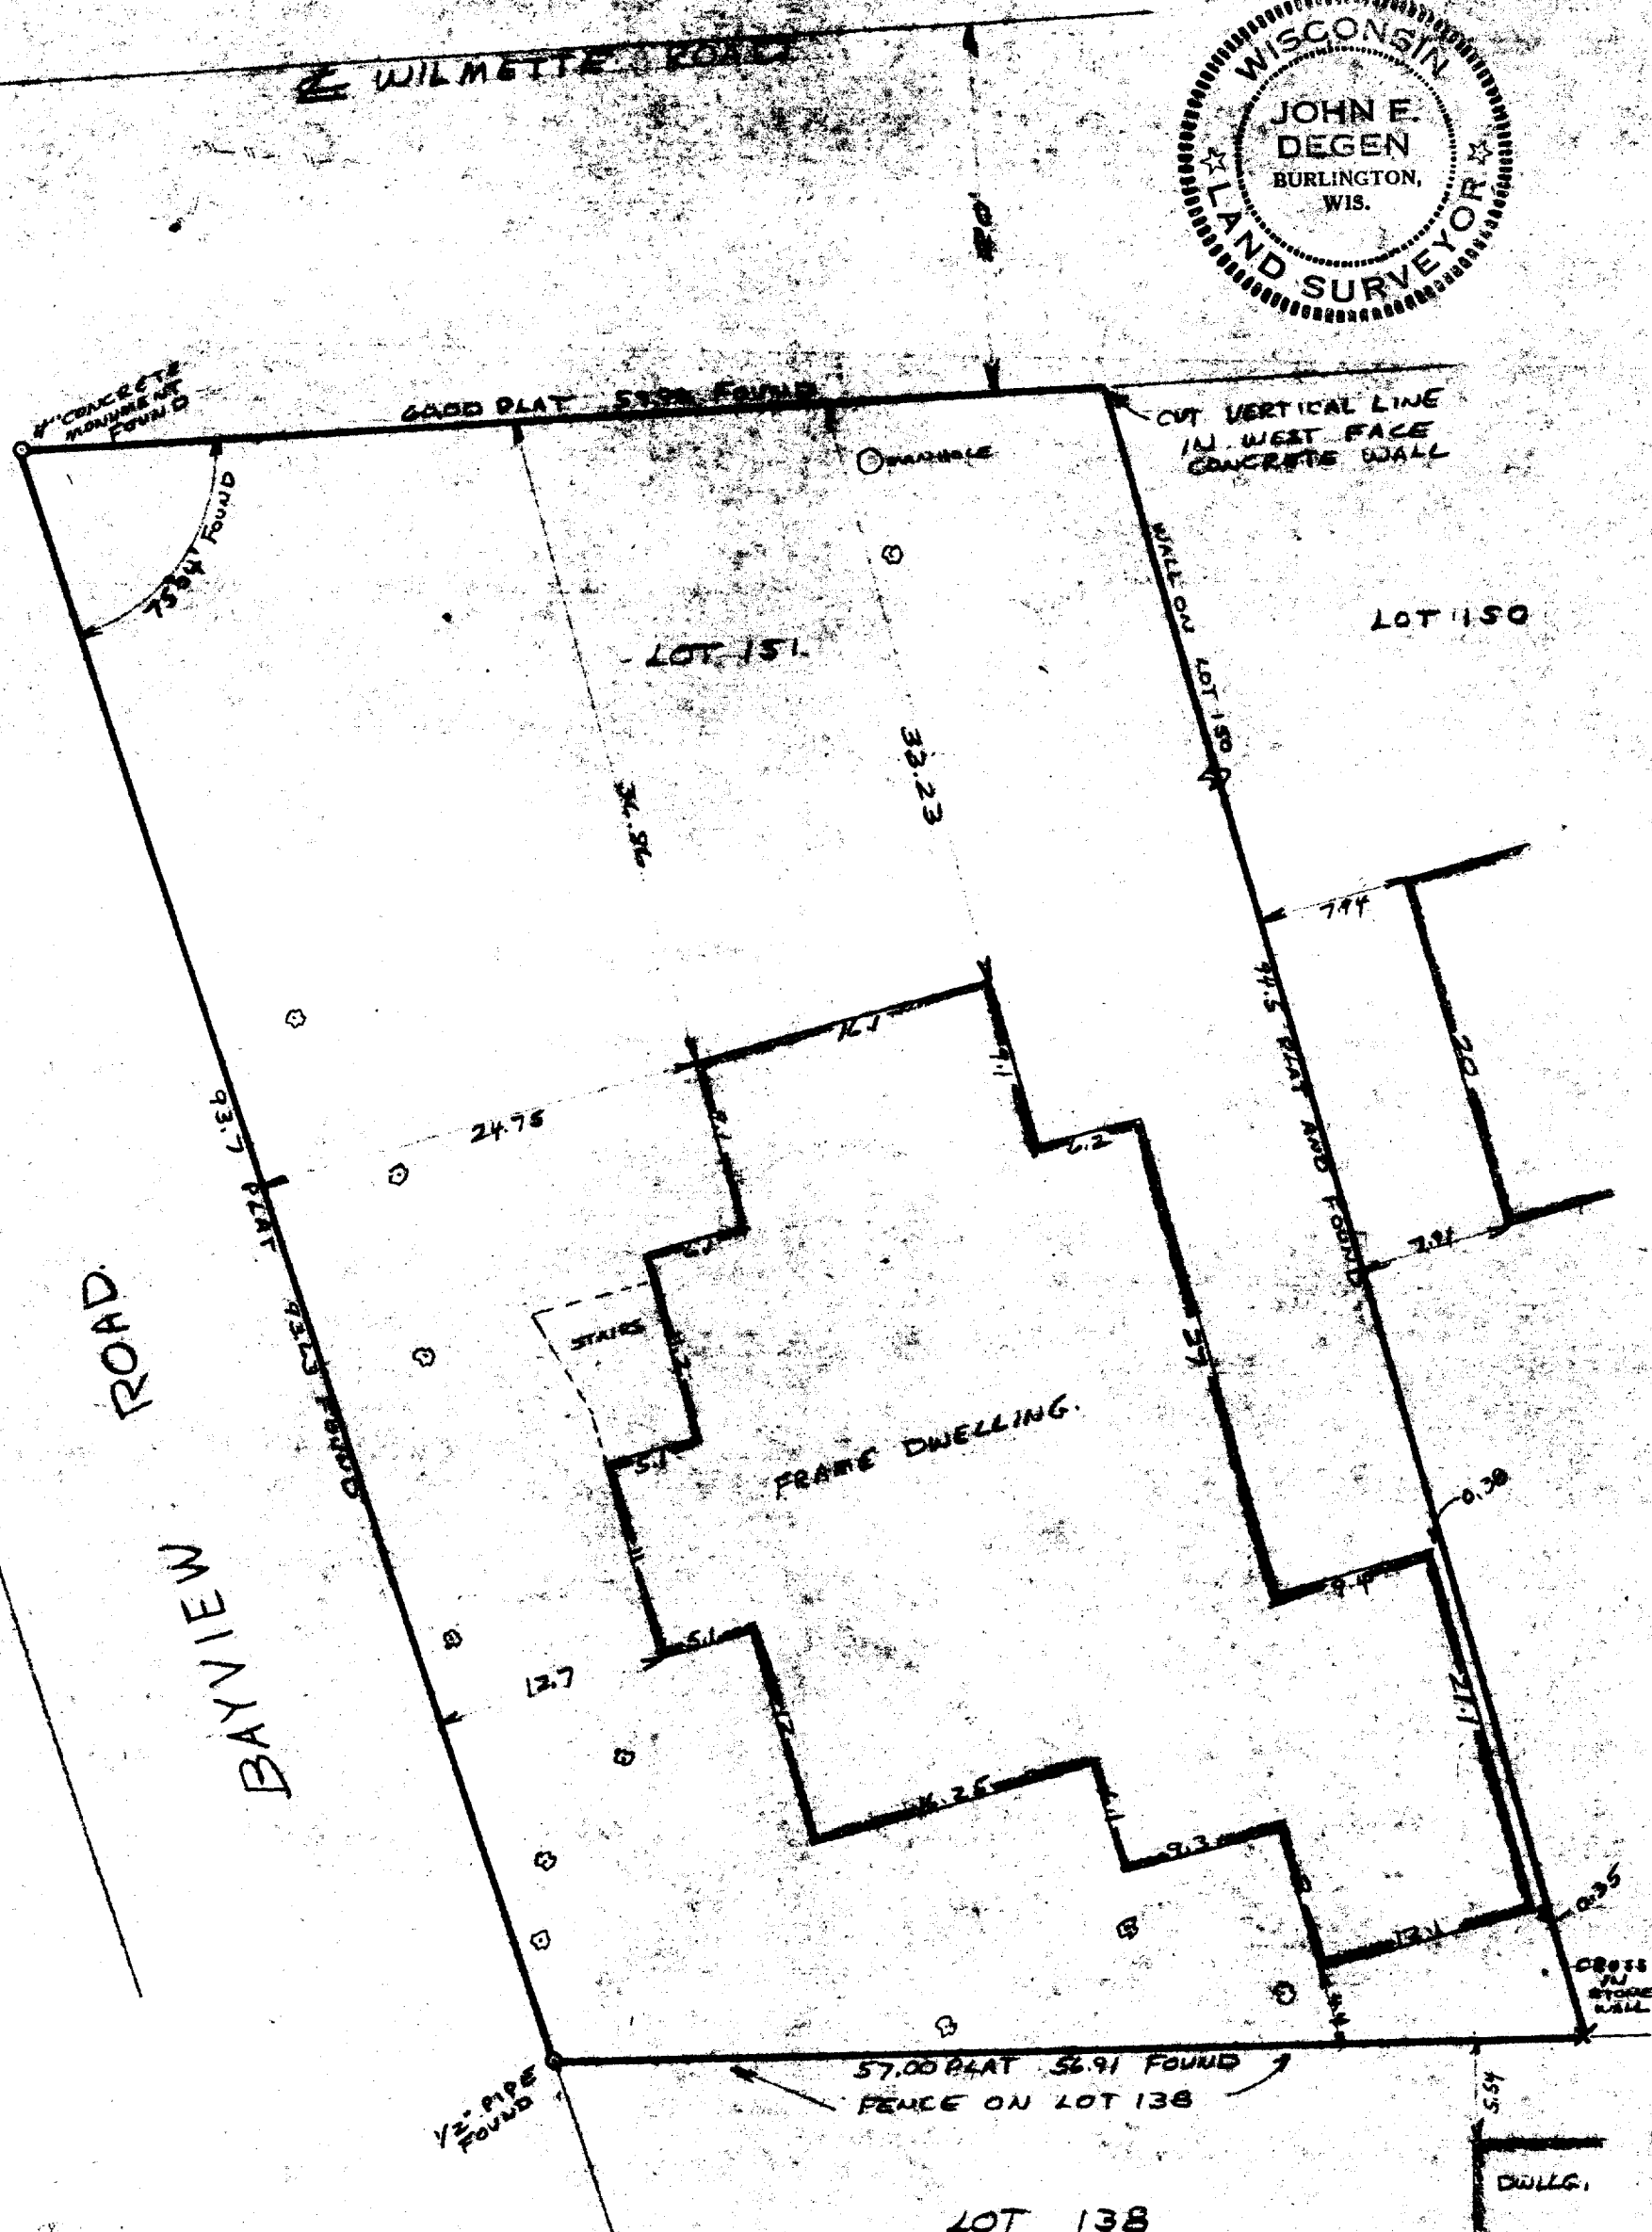

SCALE 1" = 10'
 = TREE.

✓ DRAWER 6-F.
WCP 2-47

11-103
4-8-70