


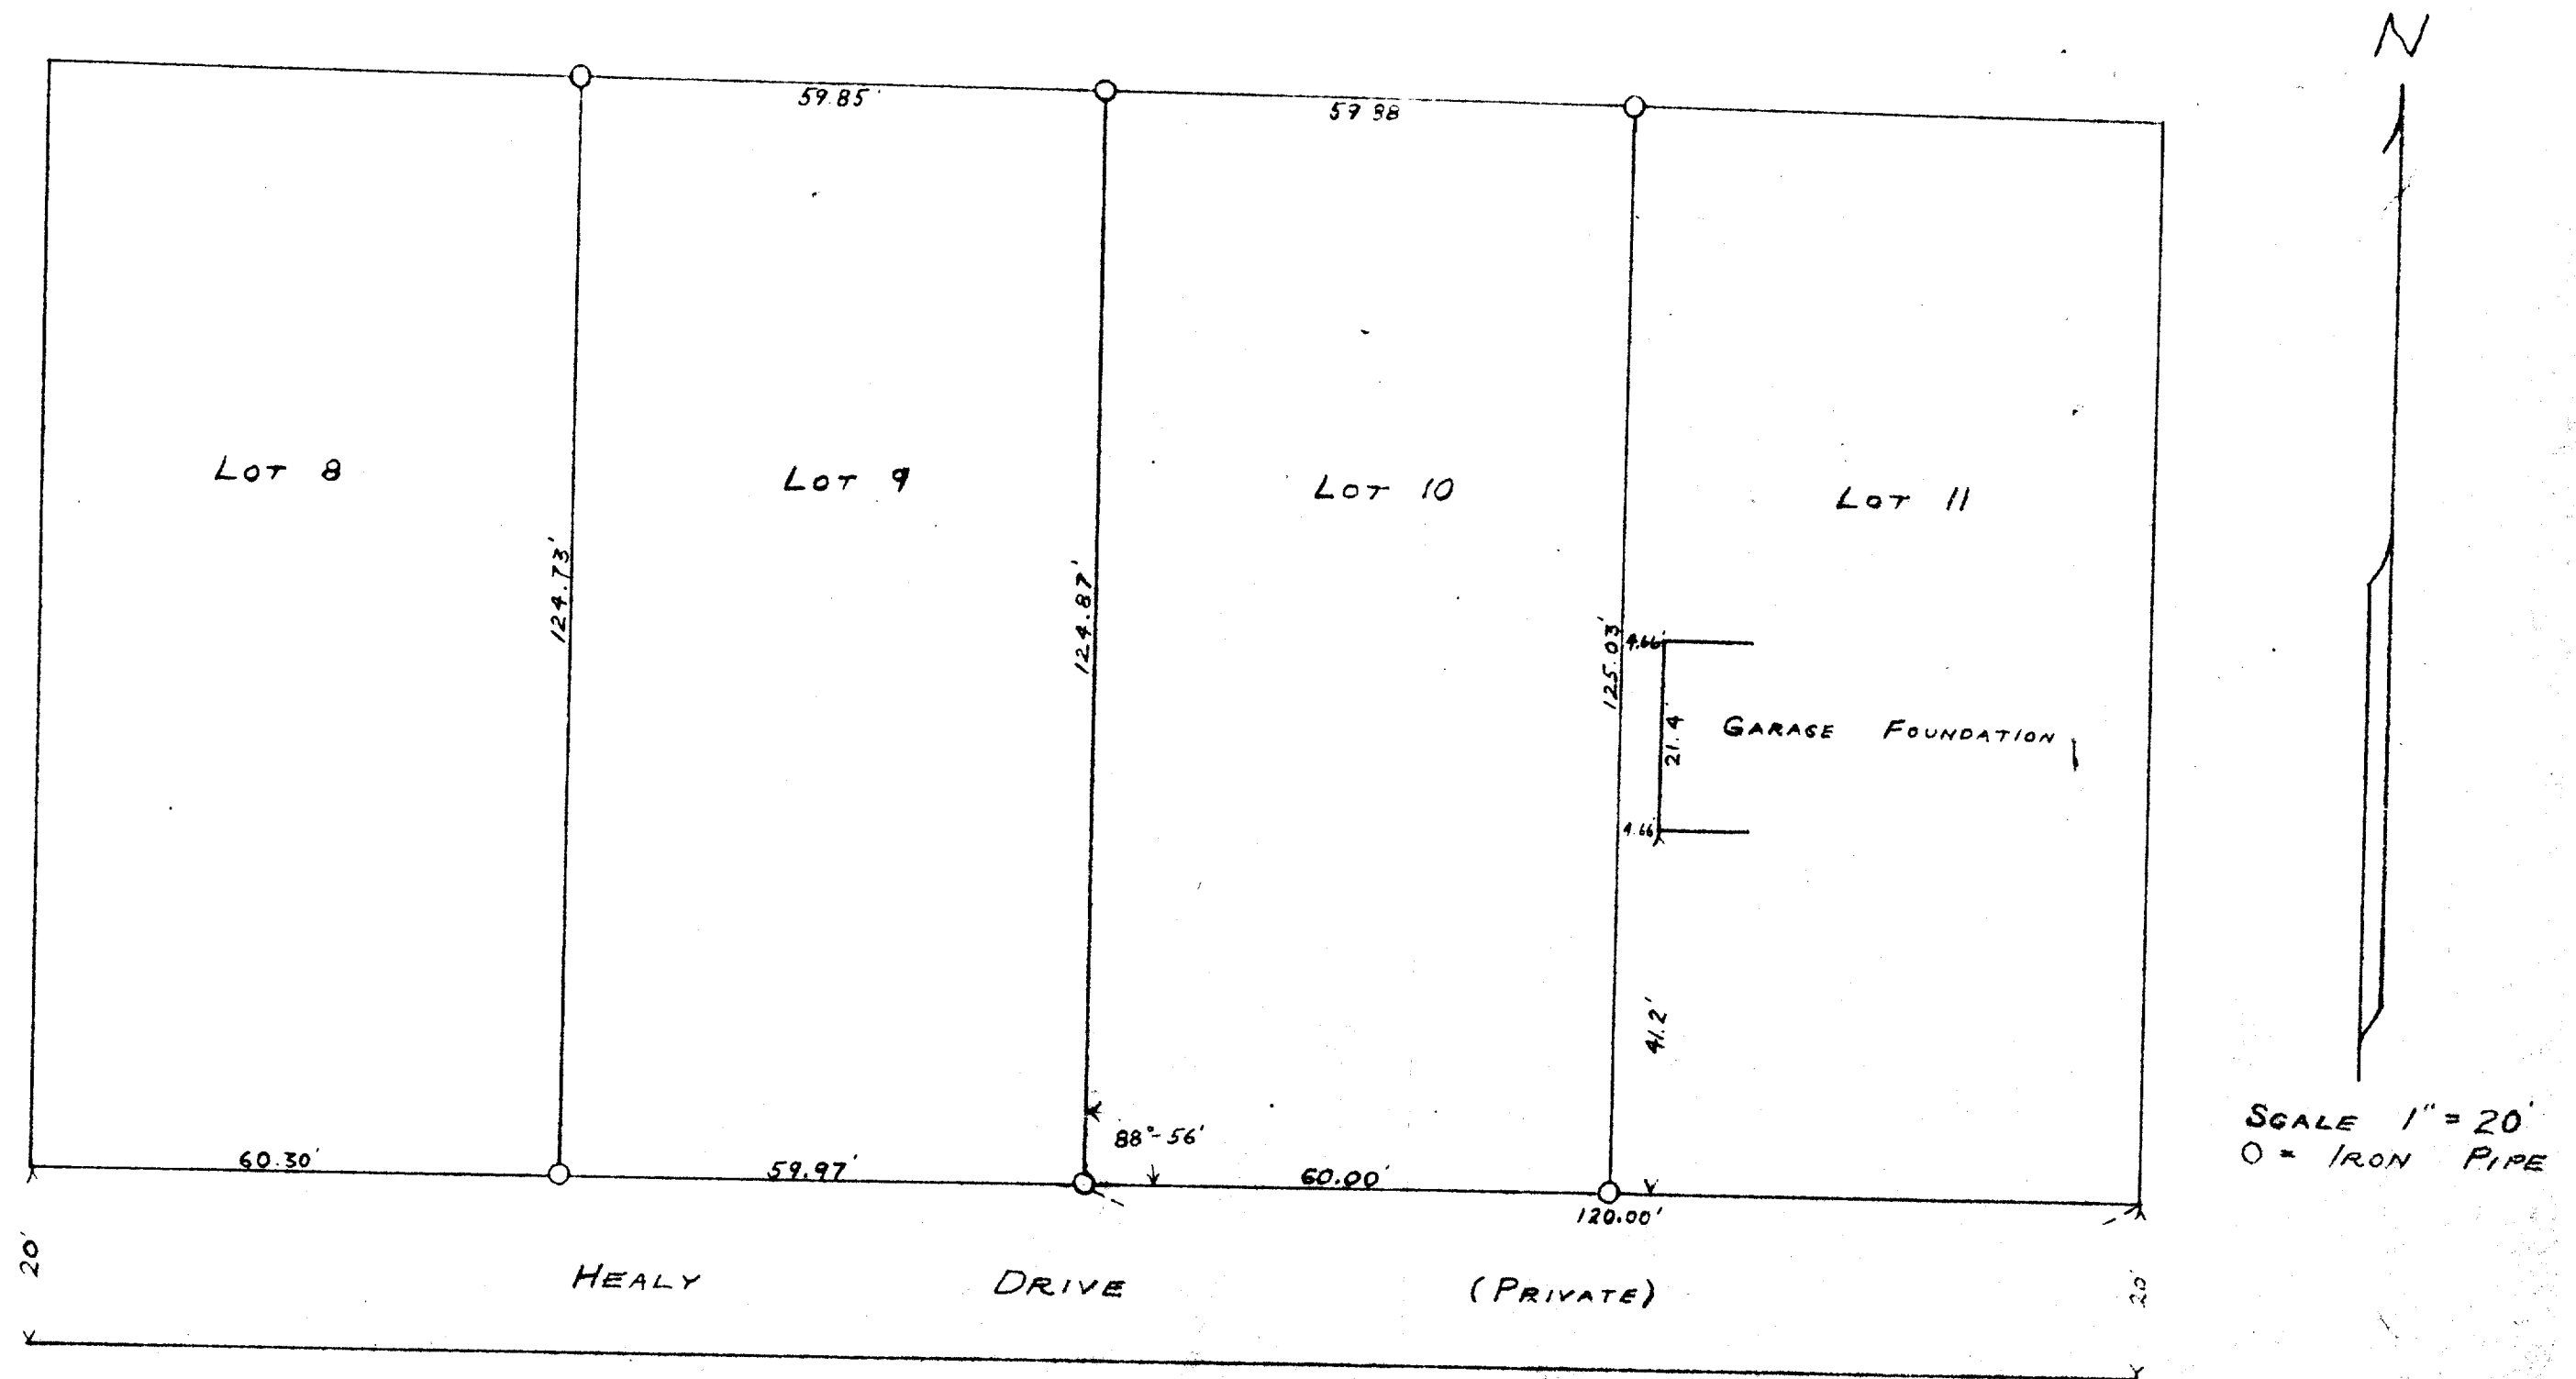

PLAT OF SURVEY OF LOTS 9 + 10  
LACKEY BROTHERS SUBDIVISION LOCATED IN  
THE VILLAGE OF WILLIAMS BAY, WALWORTH  
COUNTY, WISCONSIN.  
JULY 20, 1951

*Lloyd L. Jensen*  
COUNTY SURVEYOR

WLR-9, 10

11-103 J