


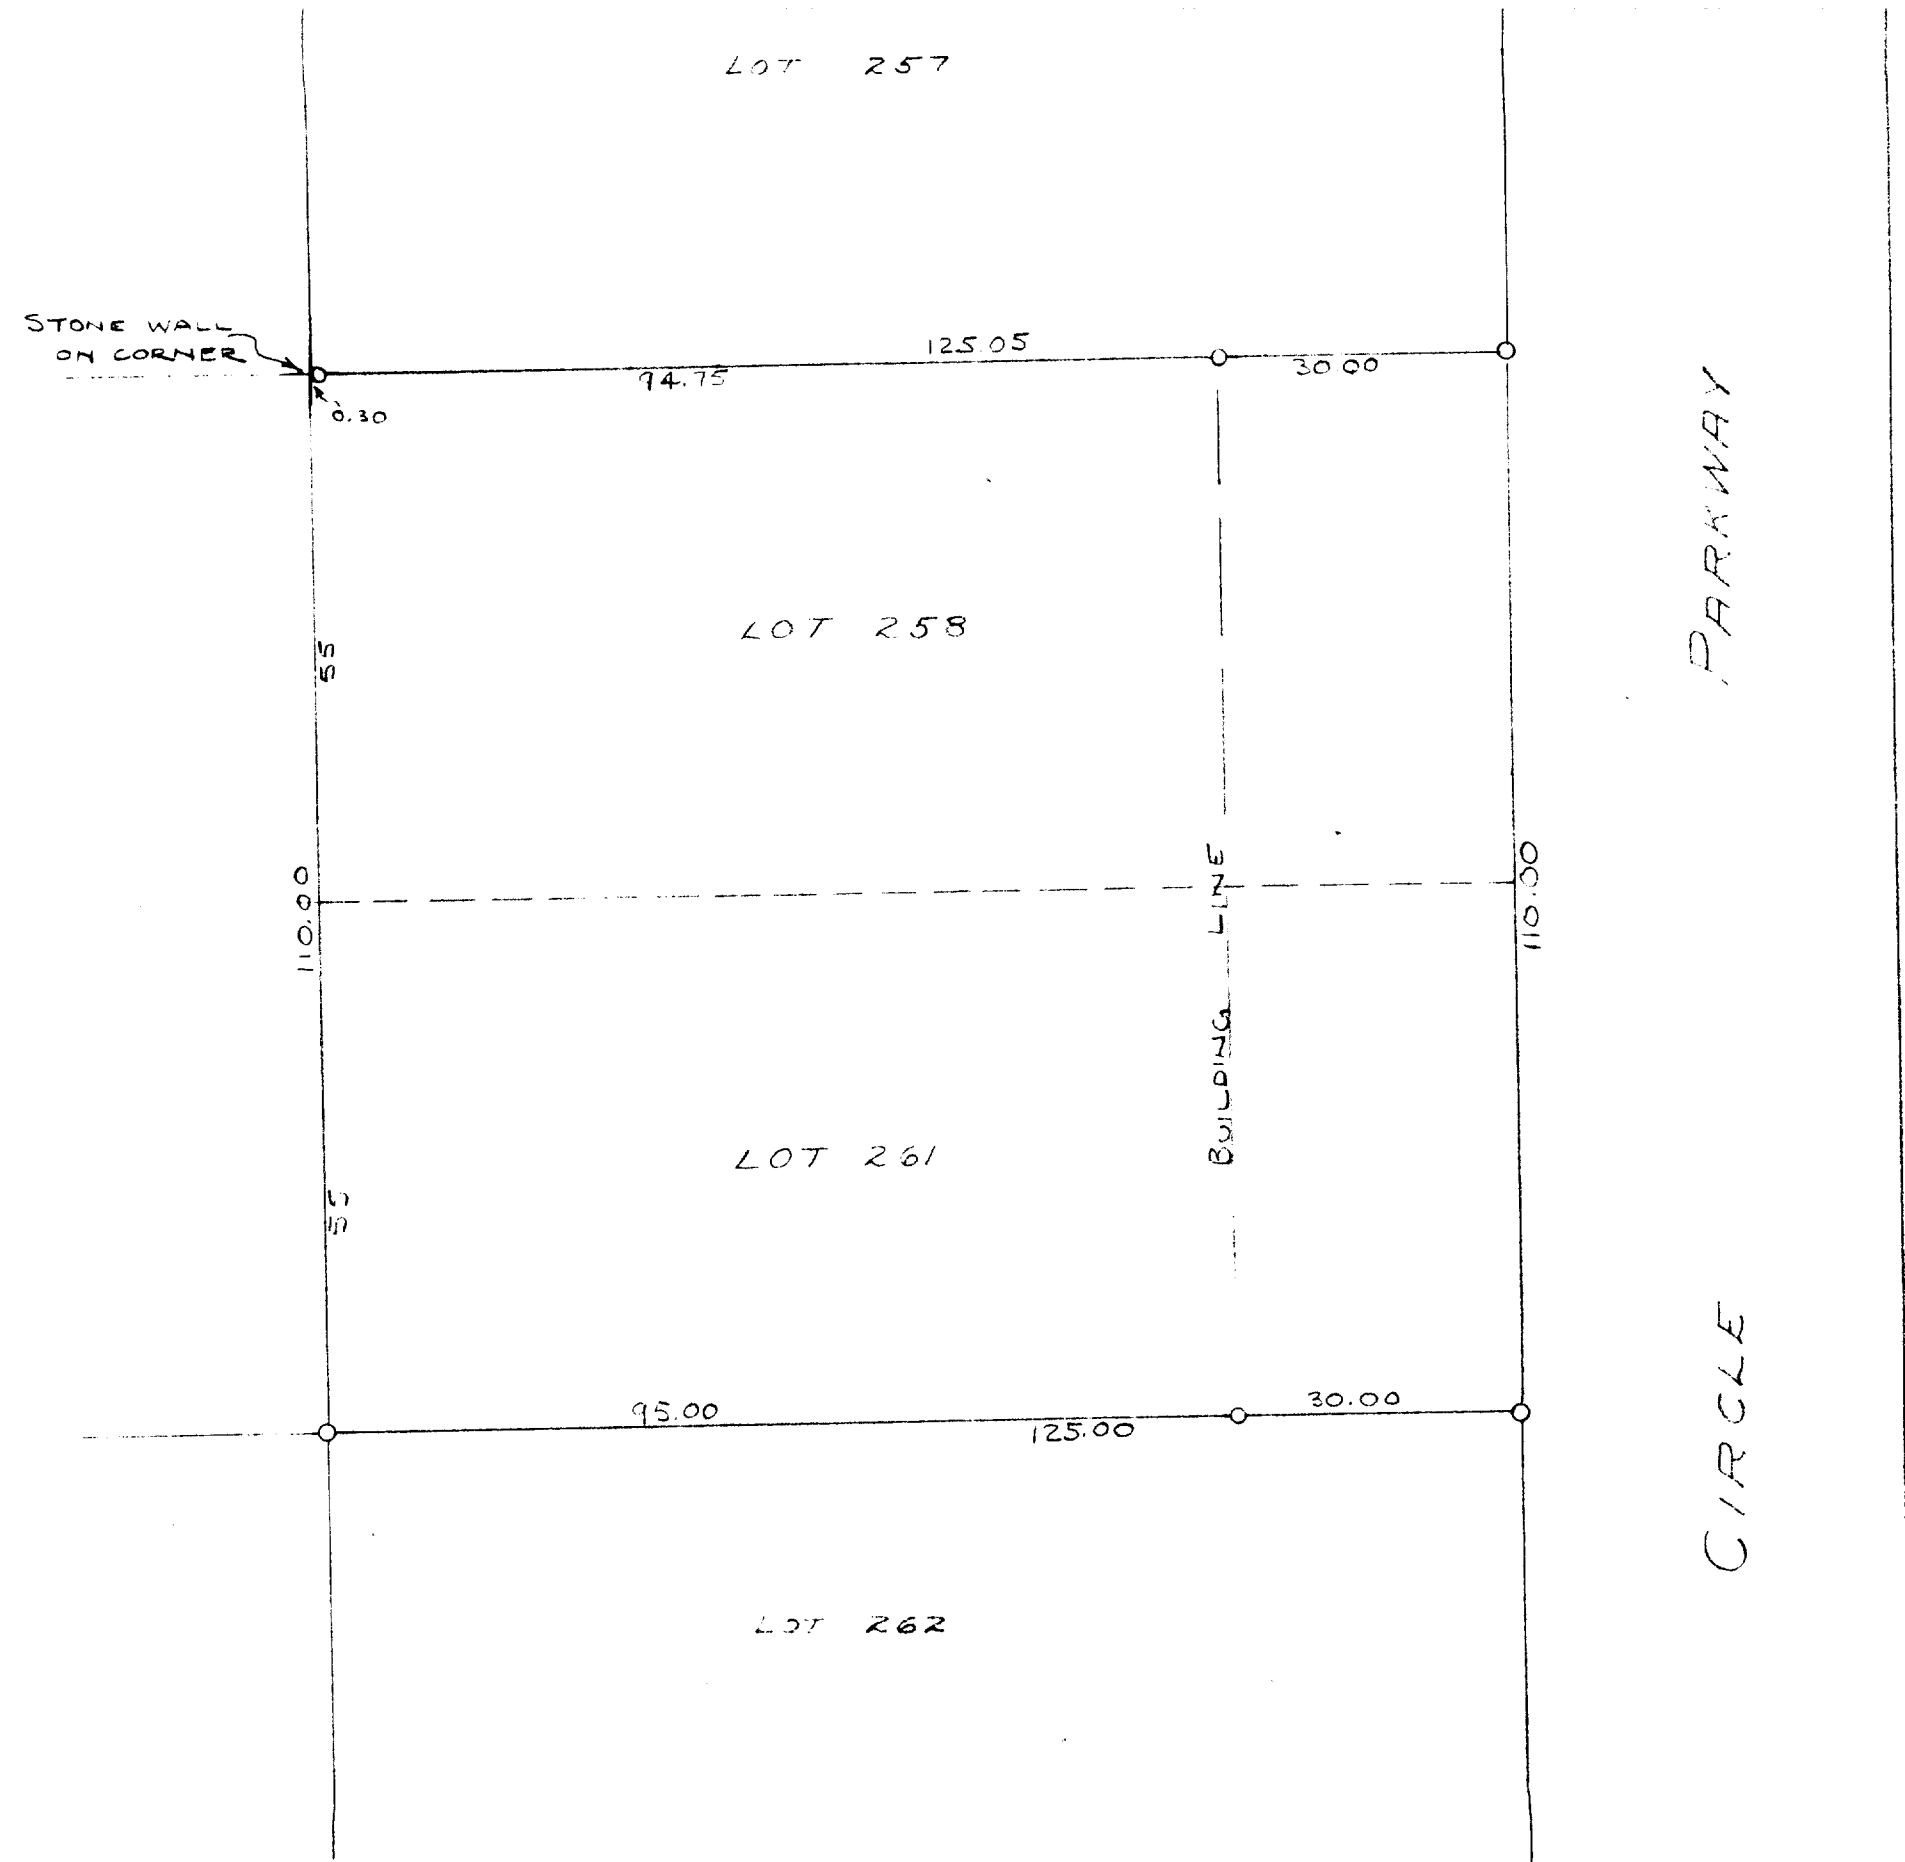

SCALE 1" = 20
 O = IRON PIPE

PLAT OF SURVEY OF LOTS 258 AND 261 OF THE 3RD
 ADDITION TO CEDAR POINT PARK, LOCATED IN THE VILLAGE
 OF WILLIAMS BAY, WALWORTH COUNTY, WISCONSIN.

MARCH 19, 1951

H. E. J. Jensen
 SURVEYOR

11-104J