


KOLB LAND CONSULTING, INC.
LAND SURVEYING • SUBDIVIDING • LAND PLANNING

929 WILLIAMS STREET

LAKE GENEVA, WISCONSIN 53147

414-248-3697

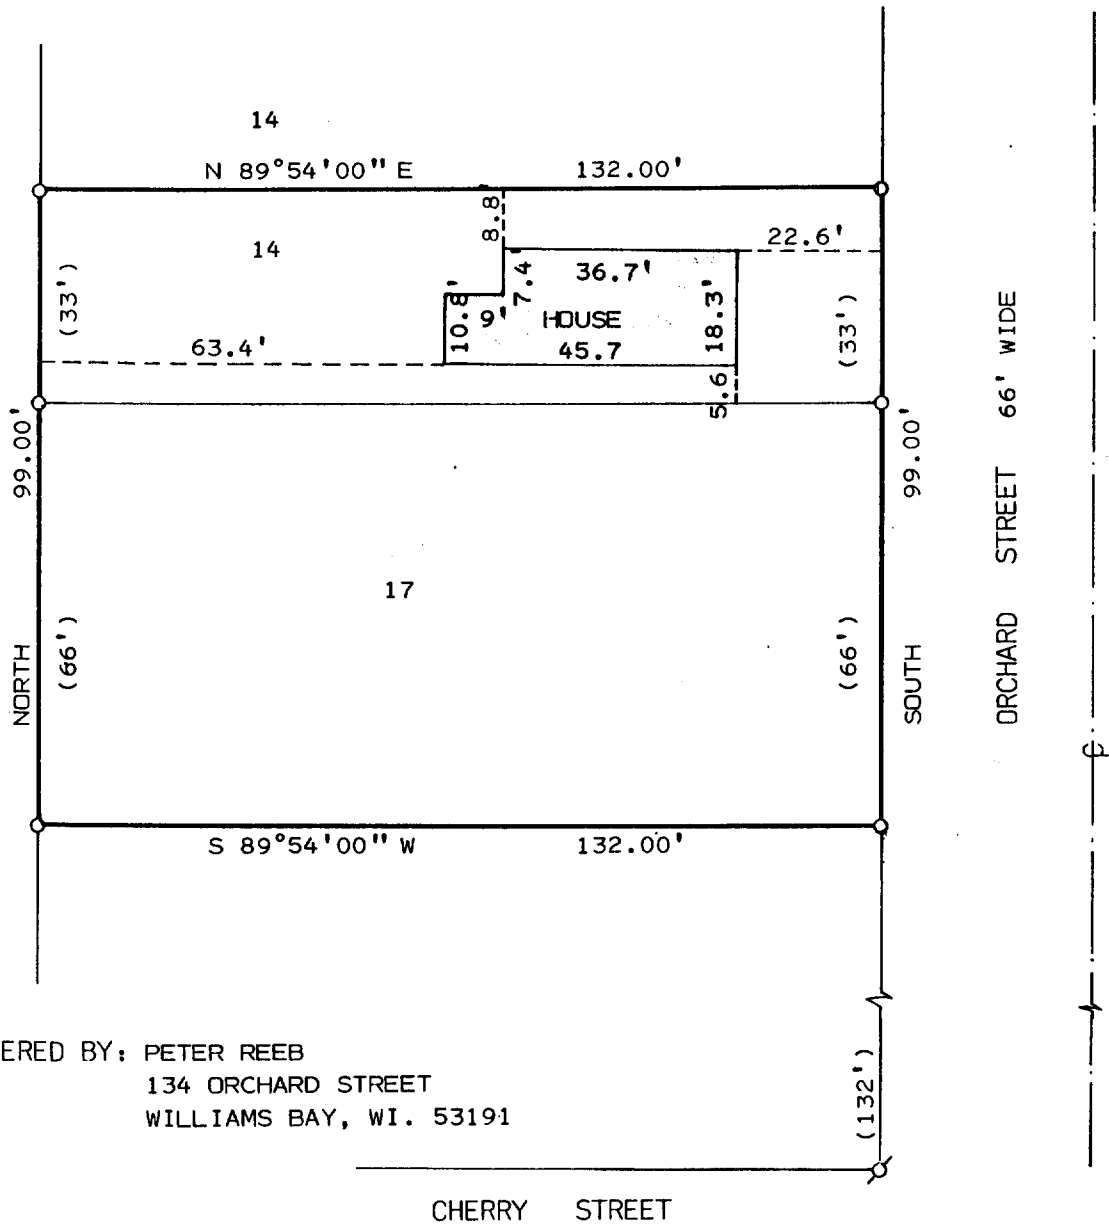


ORDERED BY: PETER REEB
134 ORCHARD STREET
WILLIAMS BAY, WI. 53191

PLAT OF SURVEY OF

NOTE: THE WEST STREET LINE OF
ORCHARD STREET ASSUMED
DUE NORTH-SOUTH.

THE SOUTH 1/2 OF LOT 14 AND LOT 17 OF LOCKWOOD'S
ADDITION A SUBDIVISION LOCATED IN THE VILLAGE OF
WILLIAMS BAY, WALWORTH COUNTY, WISCONSIN.

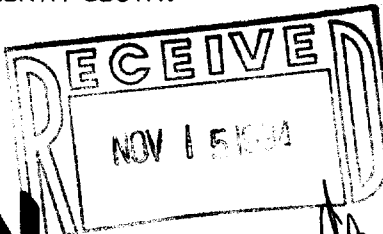

SCALE: 1" = 30'

LEGEND

- Ø - IRON PIPE FOUND
O - IRON PIPE SET
(66') - AS RECORDED

I, HAROLD H. KOLB, DO HEREBY CERTIFY
THAT I HAVE SURVEYED THE PROPERTY
HEREON DESCRIBED ACCORDING TO THE
OFFICIAL RECORDS AND THAT THE PLAT
HEREON IS A CORRECT REPRESENTATION
OF THE LOT LINES AND THE PRINCIPAL
LINES OF THE BUILDING, TO THE BEST
OF MY KNOWLEDGE AND BELIEF.
SURVEY NOT VALID UNLESS SURVEYOR'S SIGNATURE
IS IN RED.

HAROLD H. KOLB

WISCONSIN REGISTERED LAND SURVEYOR, S-187

DATE FEBRUARY 23, 1994

REVISED

REVISED

WMB-70

WLW-12
WLW-14

11-1065