
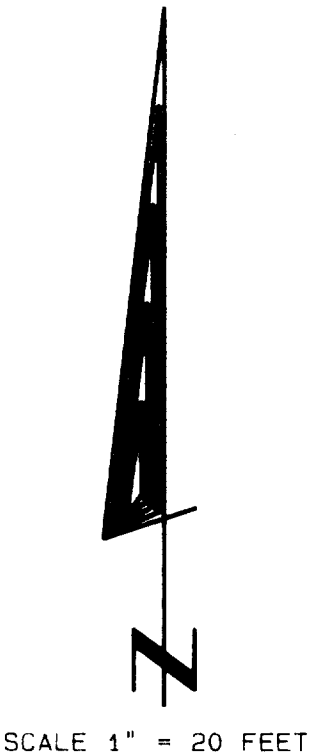


PLAT OF SURVEY


LOT 34 OF LACKEY BROTHERS  
SUBDIVISION, LOCATED IN THE VILLAGE  
OF WILLIAMS BAY, WALWORTH COUNTY,  
WISCONSIN.

SELLER: VIRGINIA BENDEL  
RR77 JEWELL DR.  
WILLIAMS BAY, WI. 53191

ORDERED BY: DAG SVARC  
4149 RFD  
LONG GROVE, ILL. 60047

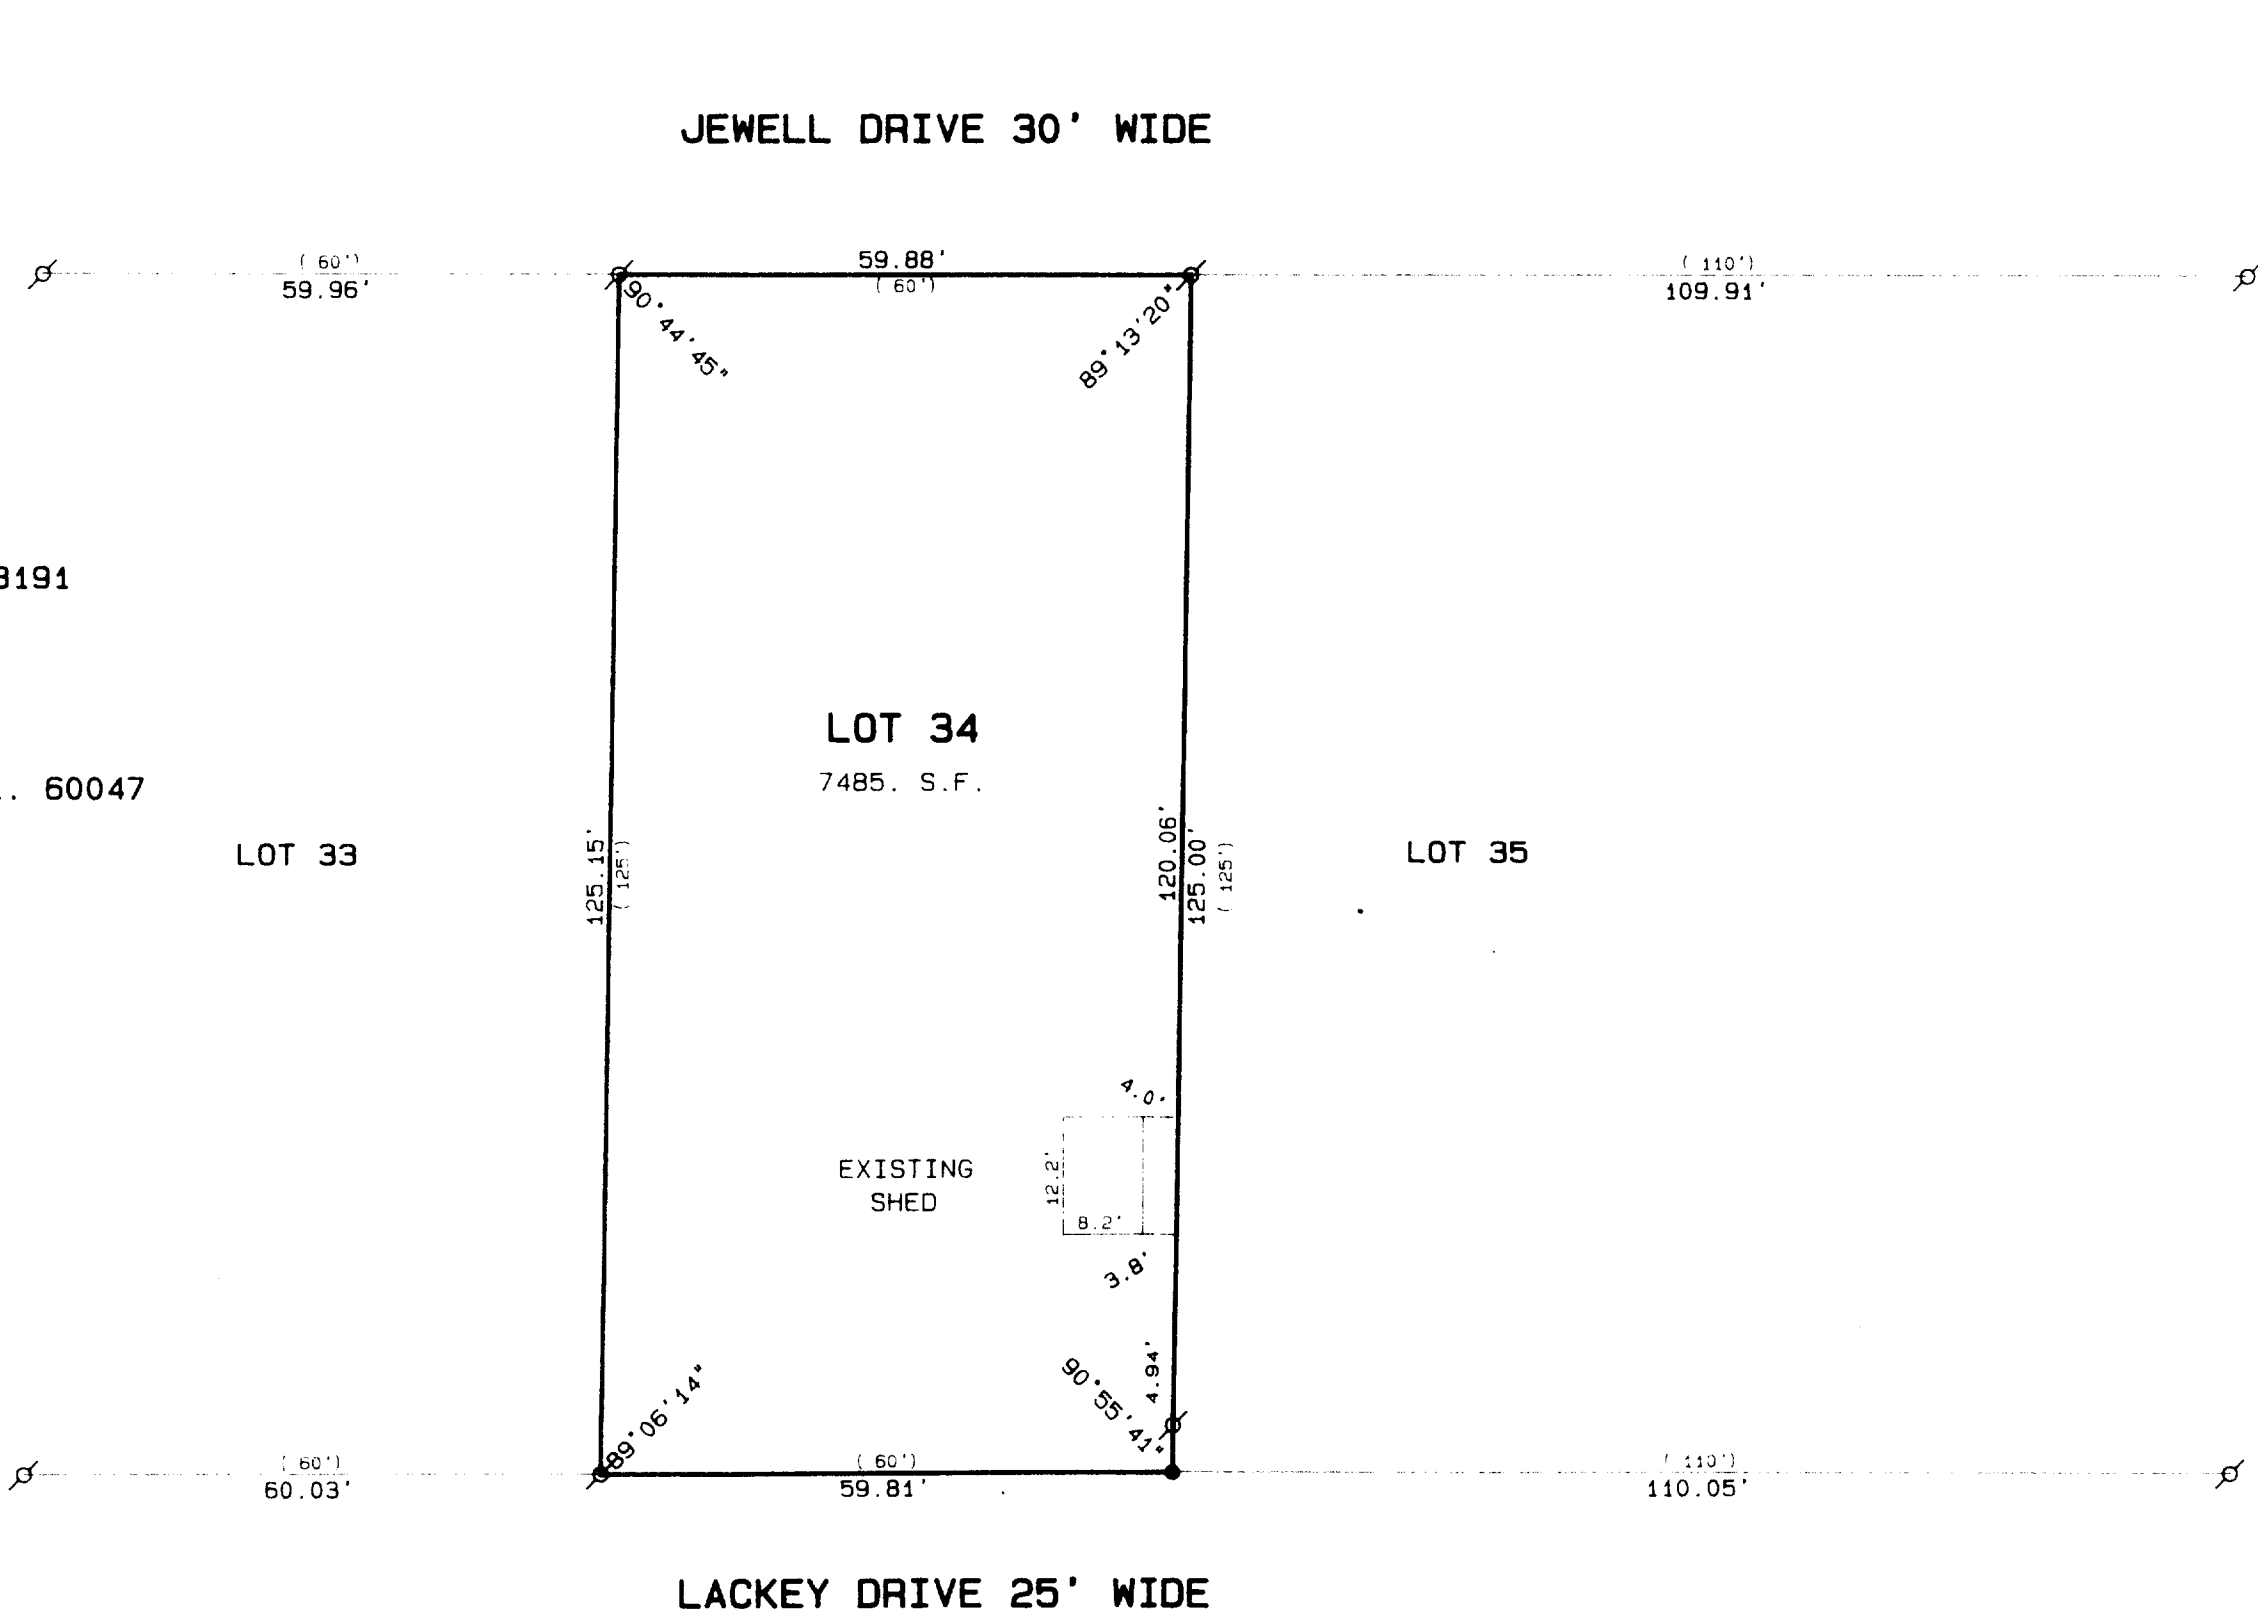

- Legend**
- FOUND IRON PIPE
  - FOUND IRON ROD
  - FOUND BRASS CAPPED MONUMENT
  - ✱ FOUND CONCRETE MONUMENT
  - ✱ CHISEL CUT IN CONCRETE
  - SET IRON ROD, 24" LONG, WEIGHING 1.5 LBS., LINEAL FT., 3/4" DIA.
  - SET IRON ROD, 30" LONG, WEIGHING 4.5 LBS., LINEAL FT., 1-11/16" DIA.
  - (XX) RECORDED AS DIMENSION
  - X-X- EXISTING FENCE

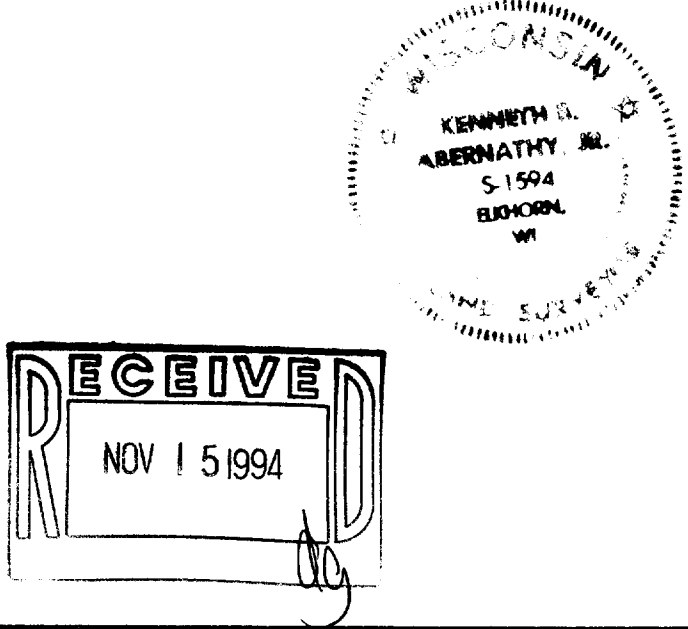

SCALE: 1" = 20 FEET

I hereby certify that I have surveyed the above described property and that the above map is a true representation thereof and shows the size and location of the property, its exterior boundaries, the location of all visible structures and dimensions of all principal buildings thereon, boundary fences, apparent easements, roadways and visible encroachments, if any.

This survey is made for the use of the present owners of the property, and also those who purchase, mortgage, or guarantee the title thereto within one year from date hereof.

*Kenneth B. Abernathy, Jr.*  
KENNETH B. ABERNATHY, JR.  
WISCONSIN REGISTERED LAND SURVEYOR,  
S-1594  
Date: 9-8-94 Job No. 94.303