
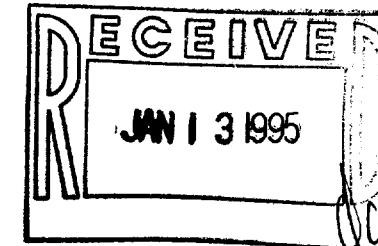


WALWORTH COUNTY
SURVEYING & MAPPING
727 HENRY STREET
LAKE GENEVA, WISCONSIN
414-248-0505

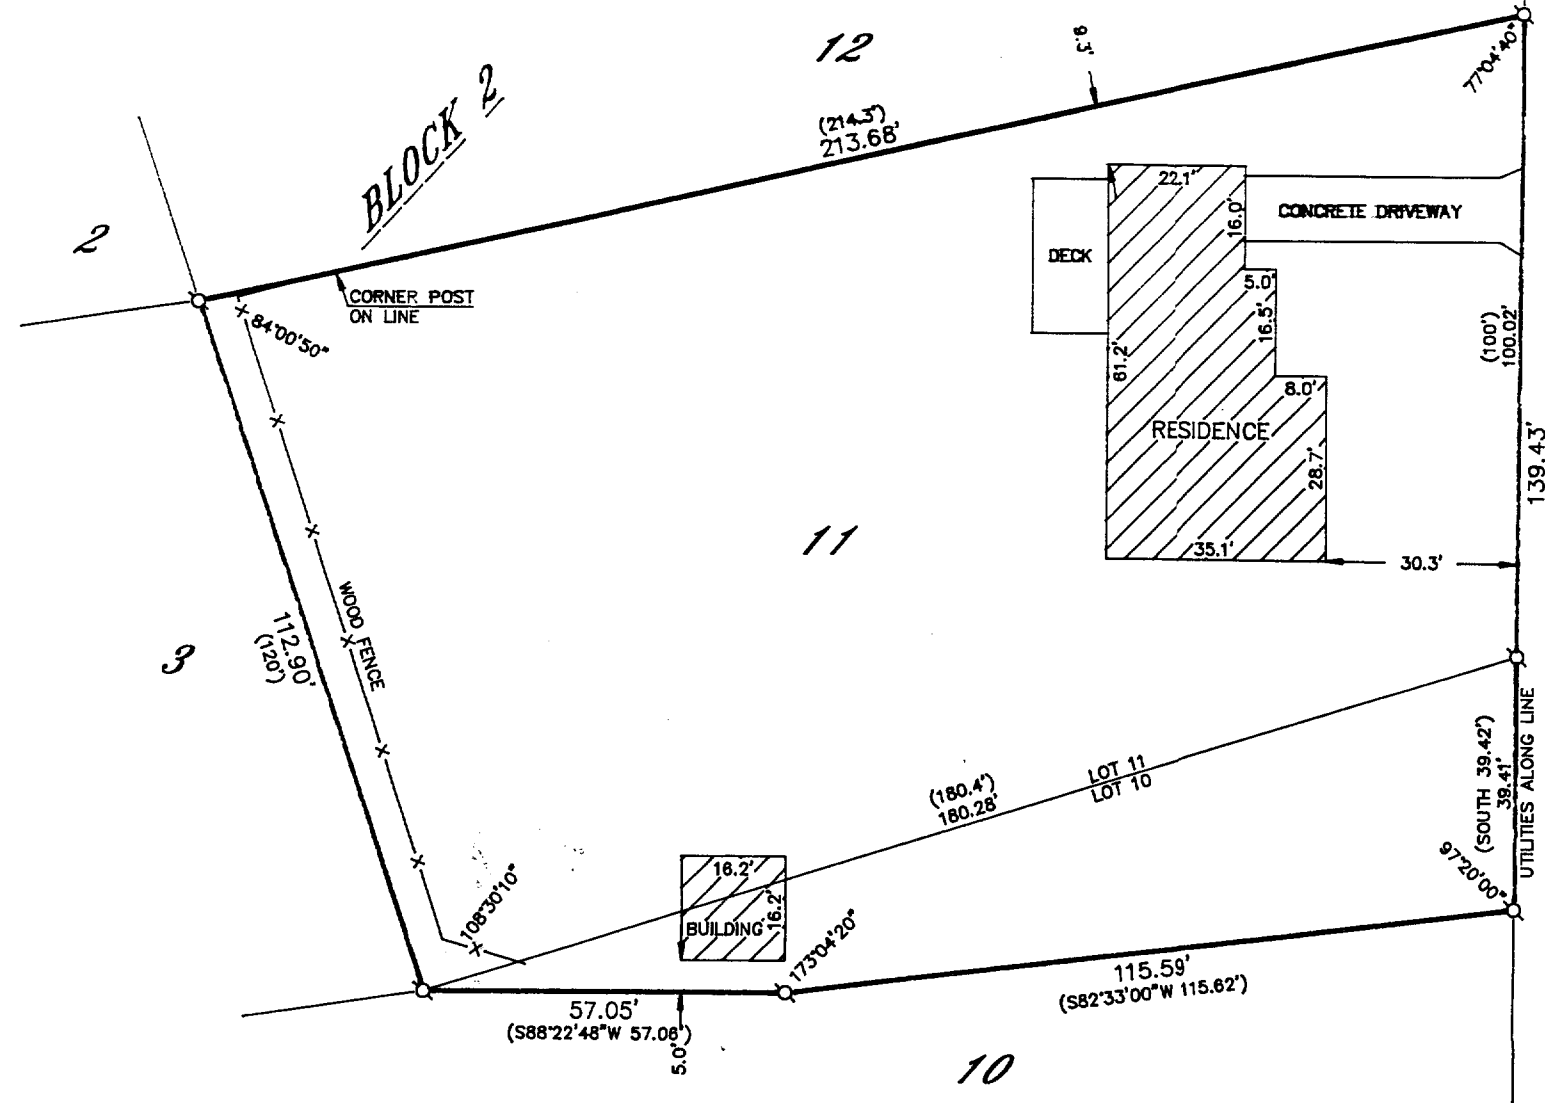

PLAT OF SURVEY OF

LOT 11 IN BLOCK 2 OF UNIVERSITY HEIGHTS AND THAT PART OF LOT 10, IN SAID BLOCK 2 OF UNIVERSITY HEIGHTS DESCRIBED AS FOLLOWS: BEGINNING AT THE NORTHEAST CORNER OF SAID LOT 10, THENCE SOUTH ALONG THE EAST LINE OF SAID LOT 10, 39.42 FEET; THENCE S82°33'00"W 115.62 FEET; THENCE S88°22'48"W 57.06 FEET TO THE SOUTHWEST CORNER OF LOT 11 OF SAID BLOCK 2; THENCE NORTHEASTERLY ALONG THE SOUTH LINE OF SAID LOT 11, 180.30 FEET TO THE PLACE OF BEGINNING, ALL IN THE VILLAGE OF WILLIAMS BAY, WALWORTH COUNTY, WISCONSIN.

ORDERED BY: COLDWELL BANKER
GENEVA LAKES AREA REALTORS
838 MAIN STREET
LAKE GENEVA, WISCONSIN
53147

STAM STREET

I HEREBY CERTIFY THAT I HAVE SURVEYED THE ABOVE DESCRIBED PROPERTY AND THAT THE ABOVE MAP IS A TRUE REPRESENTATION THEREOF AND SHOWS THE SIZE AND LOCATION OF THE PROPERTY, ITS EXTERIOR BOUNDARIES, THE LOCATION OF ALL VISIBLE STRUCTURES AND DIMENSIONS OF ALL PRINCIPAL BUILDINGS THEREON, BOUNDARY FENCES, APPARENT EASEMENTS, ROADWAYS AND VISIBLE ENCROACHMENTS, IF ANY, TO THE BEST OF MY KNOWLEDGE AND BELIEF.

THIS SURVEY IS MADE FOR THE USE OF THE PRESENT OWNERS OF THE PROPERTY AND ALSO THOSE WHO PURCHASE, MORTGAGE OR GUARANTEE THE TITLE THERETO WITHIN ONE (1) YEAR FROM DATE HEREOF.

Robert M. Baerenwald
ROBERT M. BAERENWALD
WISCONSIN REGISTERED LAND SURVEYOR, S-1508

DATE: *June 21, 1994*
JOB NO. 4286

NOTE: THIS IS NOT A CERTIFIED COPY UNLESS SEALED.

WU14-13

41-1085