


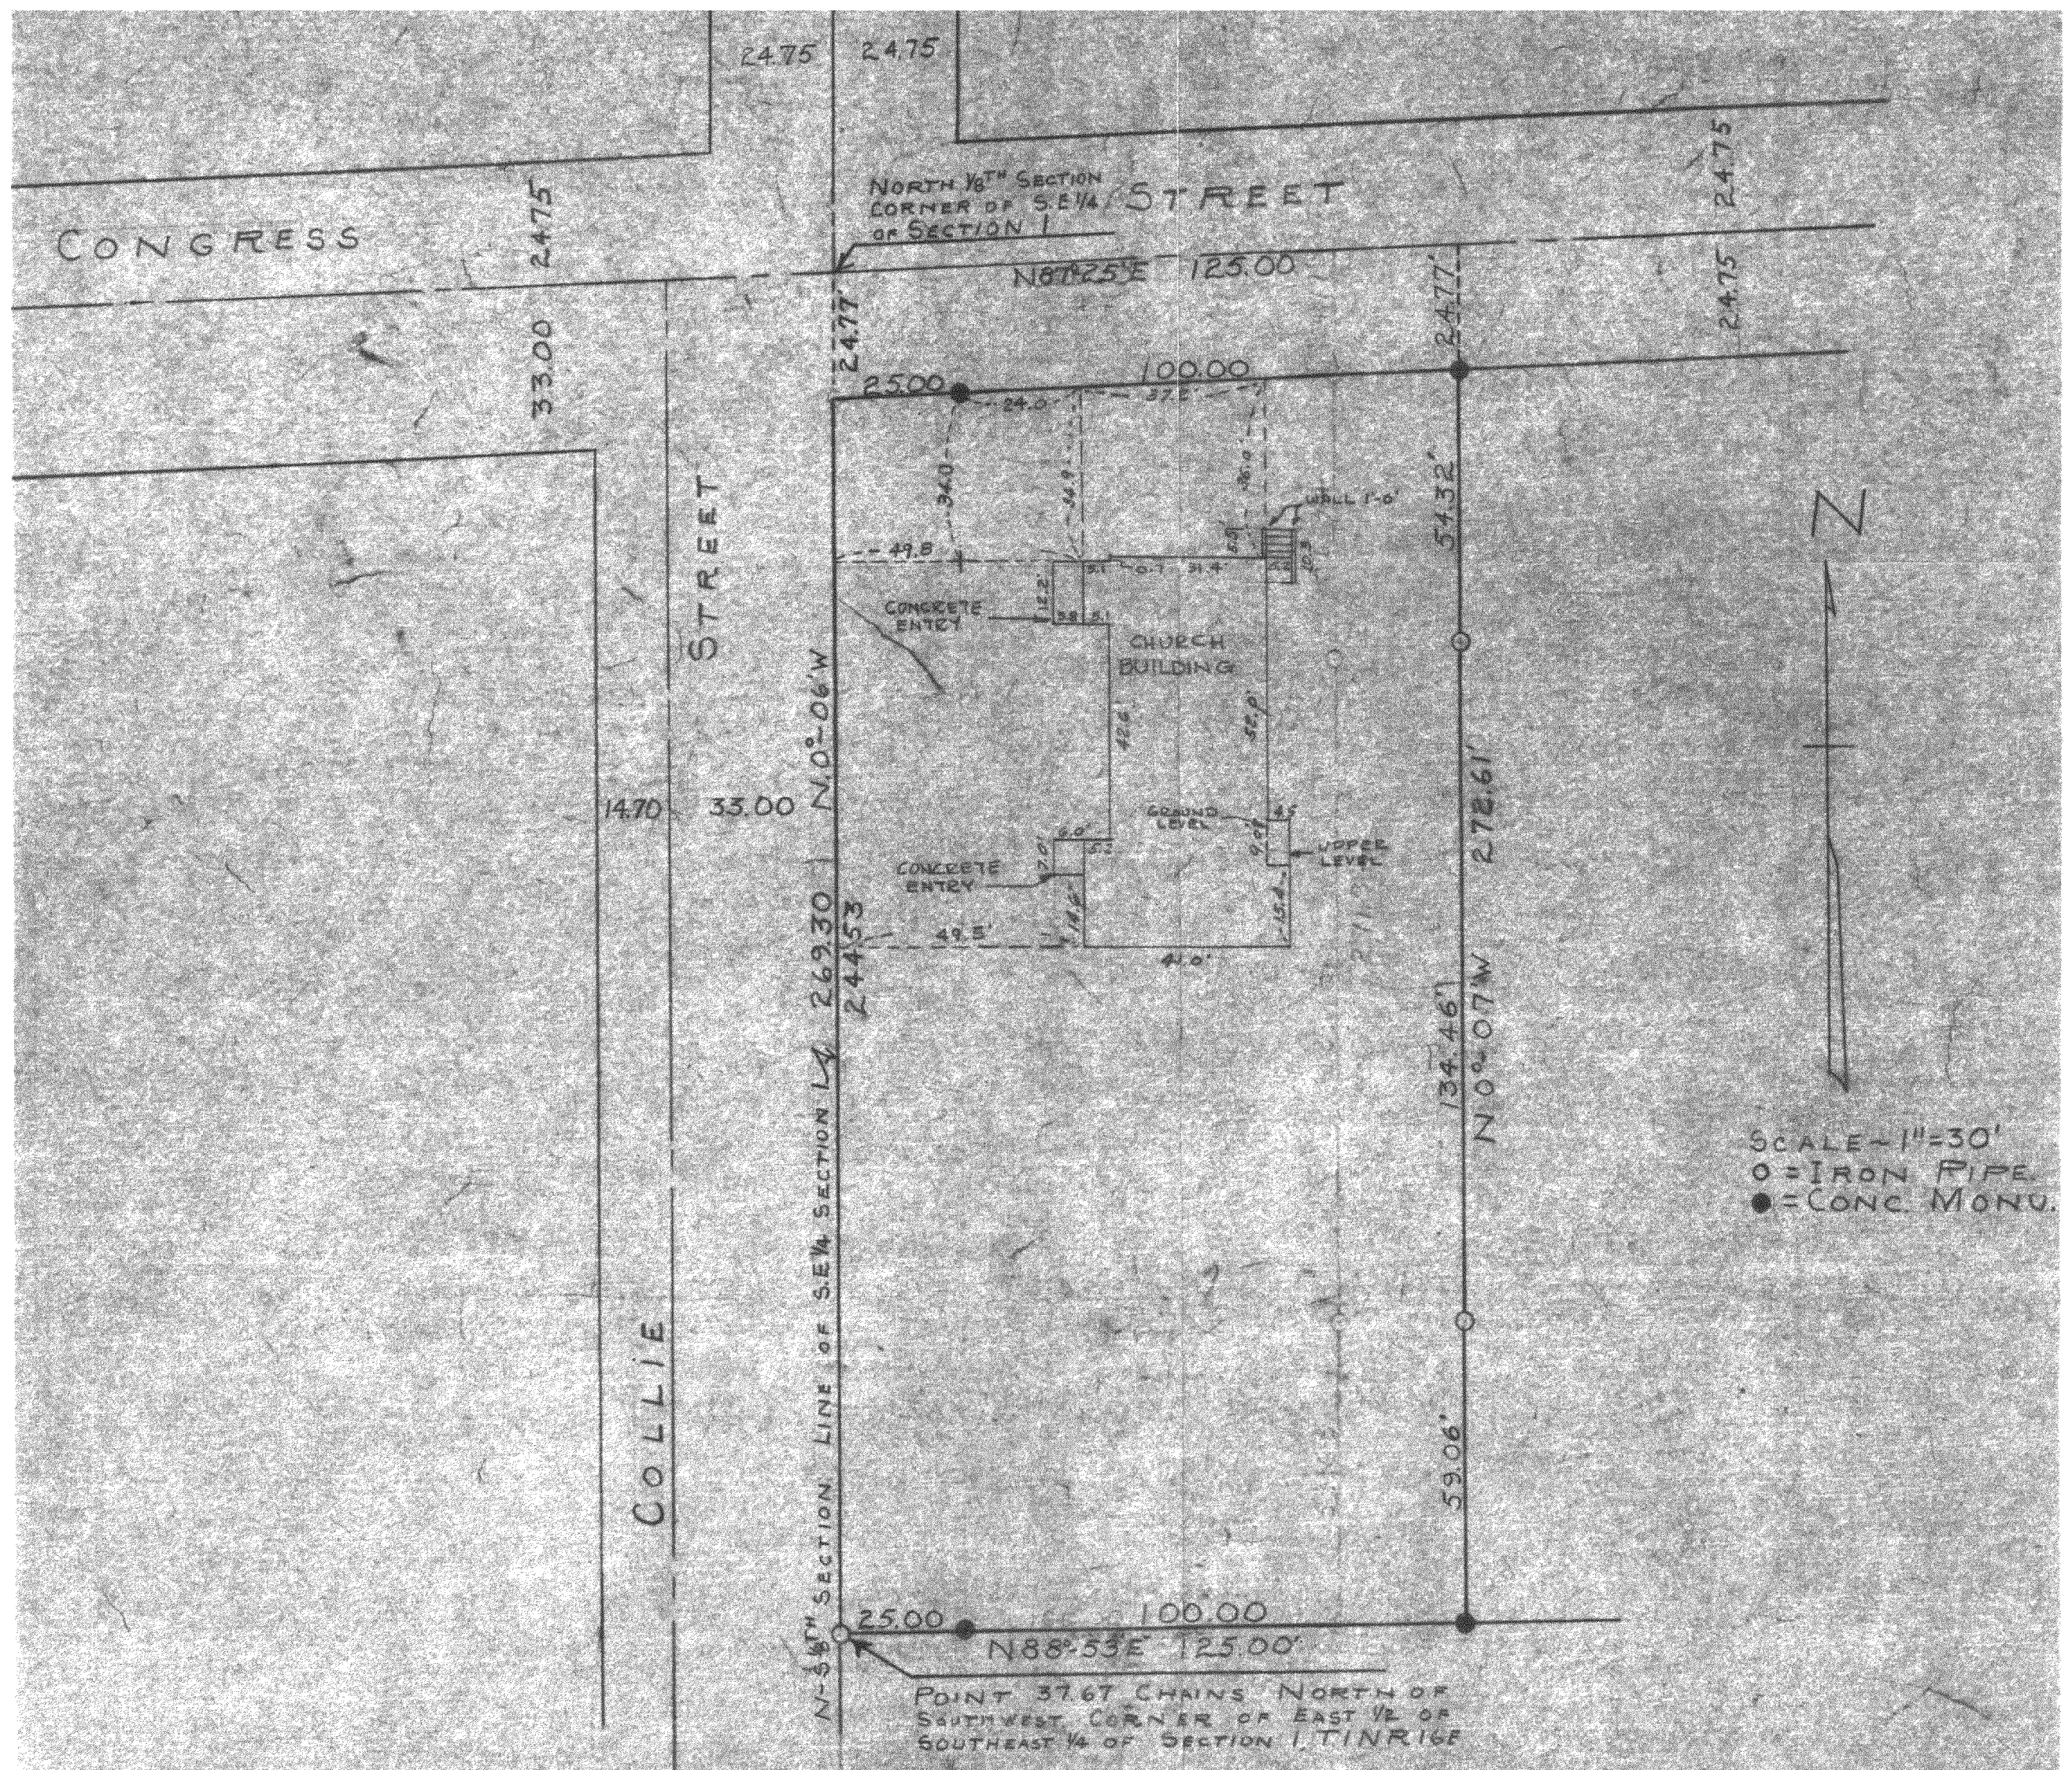

PLAT OF SURVEY OF LAND LOCATED IN THE NE 1/4
OF THE SE 1/4 OF SECTION 1, T1N R16S VILLAGE OF
WILLIAMS BAY, WALWORTH COUNTY, WISCONSIN
DEC. 1951

Lloyd L. Jensen
COUNTY SURVEYOR

I HEREDY CERTIFY THAT I HAVE SURVEYED THE LAND SHOWN HEREIN THAT IS
OWNED BY THE WILLIAMS BAY LUTHERAN CHURCH AND CORRECTLY LOCATED THE
CHURCH BUILDING THERE ON

Lloyd L. Jensen
COUNTY SURVEYOR