


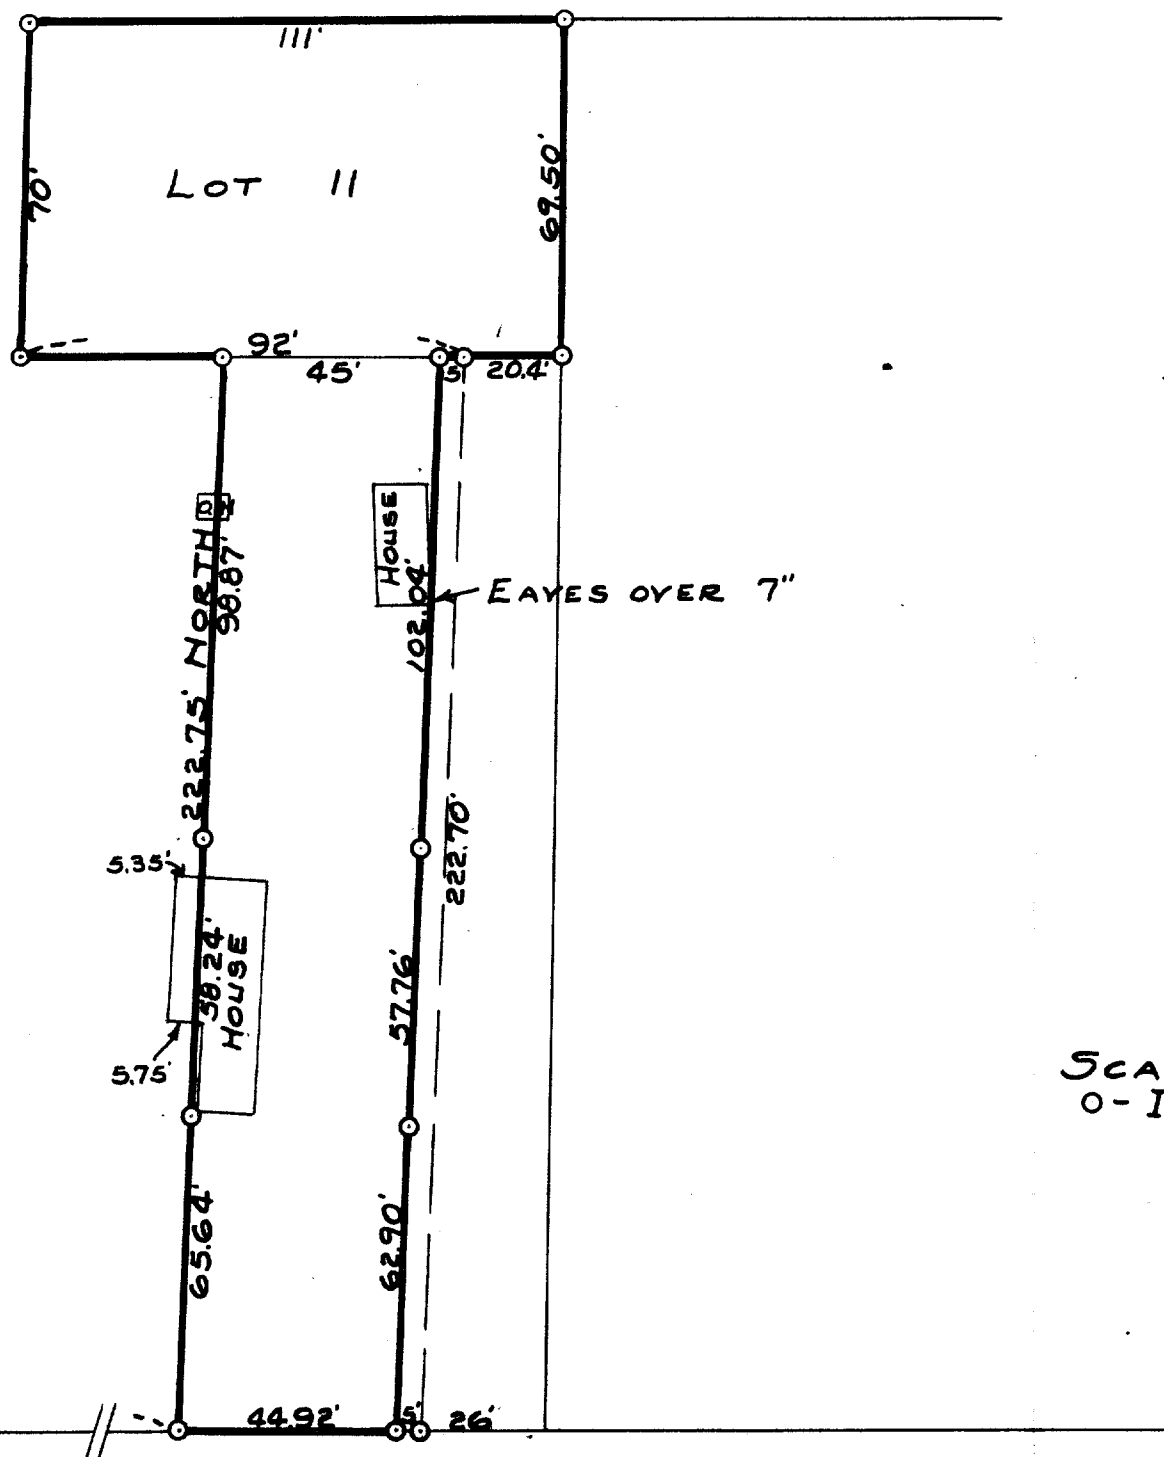

SCALE 1" = 40'
0- IRON PIPE

CONGRESS STREET

49.5' WIDE

SW COR. OF E $\frac{1}{2}$ OF NE $\frac{1}{4}$ OF
FRACTIONAL SECTION 1, T1N R16E

PLAT OF SURVEY OF PART OF LOT 11 OF JOHNSON'S ADDITION
TO THE VILLAGE OF WILLIAMS BAY WISCONSIN, AND UNPLATTED
LAND ADJOINING.

AUG. 1943

Floyd L. Jensen
COUNTY SURVEYOR