

BOUNDARY & TOPOGRAPHIC SURVEY

LOT 19 CEDAR POINT PARK 1st ADDITION

VILLAGE OF WILLIAMS BAY



WALWORTH COUNTY, WISCONSIN

NOTE: COPIES OF THIS MAP TO WHICH THE FOLLOWING CERTIFICATE WILL APPLY ARE BLUE LINE PRINTS SHOWING SURVEYOR'S ORIGINAL SEAL AND SIGNATURE IN BLACK INK. COPIES BY ANY OTHER MEANS MAY HAVE ALTERATIONS WHICH DO NOT REPRESENT THE SURVEYOR'S WORK PRODUCT.


I HEREBY CERTIFY THAT THE ABOVE DESCRIBED PROPERTY HAS BEEN SURVEYED UNDER MY DIRECTION AND THAT THE ABOVE MAP IS A TRUE REPRESENTATION THEREOF AND SHOWS THE SIZE AND LOCATION OF THE PROPERTY AND ITS EXTERIOR BOUNDARIES. THIS SURVEY IS MADE FOR THE USE OF THE PRESENT OWNERS OF THE PROPERTY, AND ALSO THOSE WHO PURCHASE, MORTGAGE, OR GUARANTEE THE TITLE THERETO WITHIN ONE YEAR FROM THE DATE HEREOF.

DATED: 9-5-95

Peter S. Gordon
PETER S. GORDON R.L.S. 2101

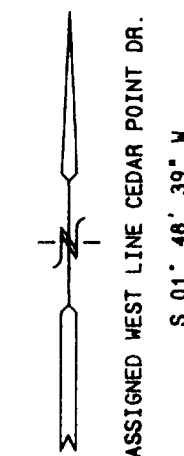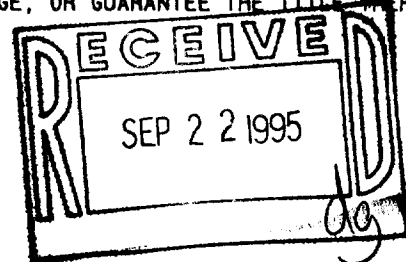

BENCH MARK
TOP OF CONCRETE MONUMENT
FOUND EL. ASSIGNED = 100.00'

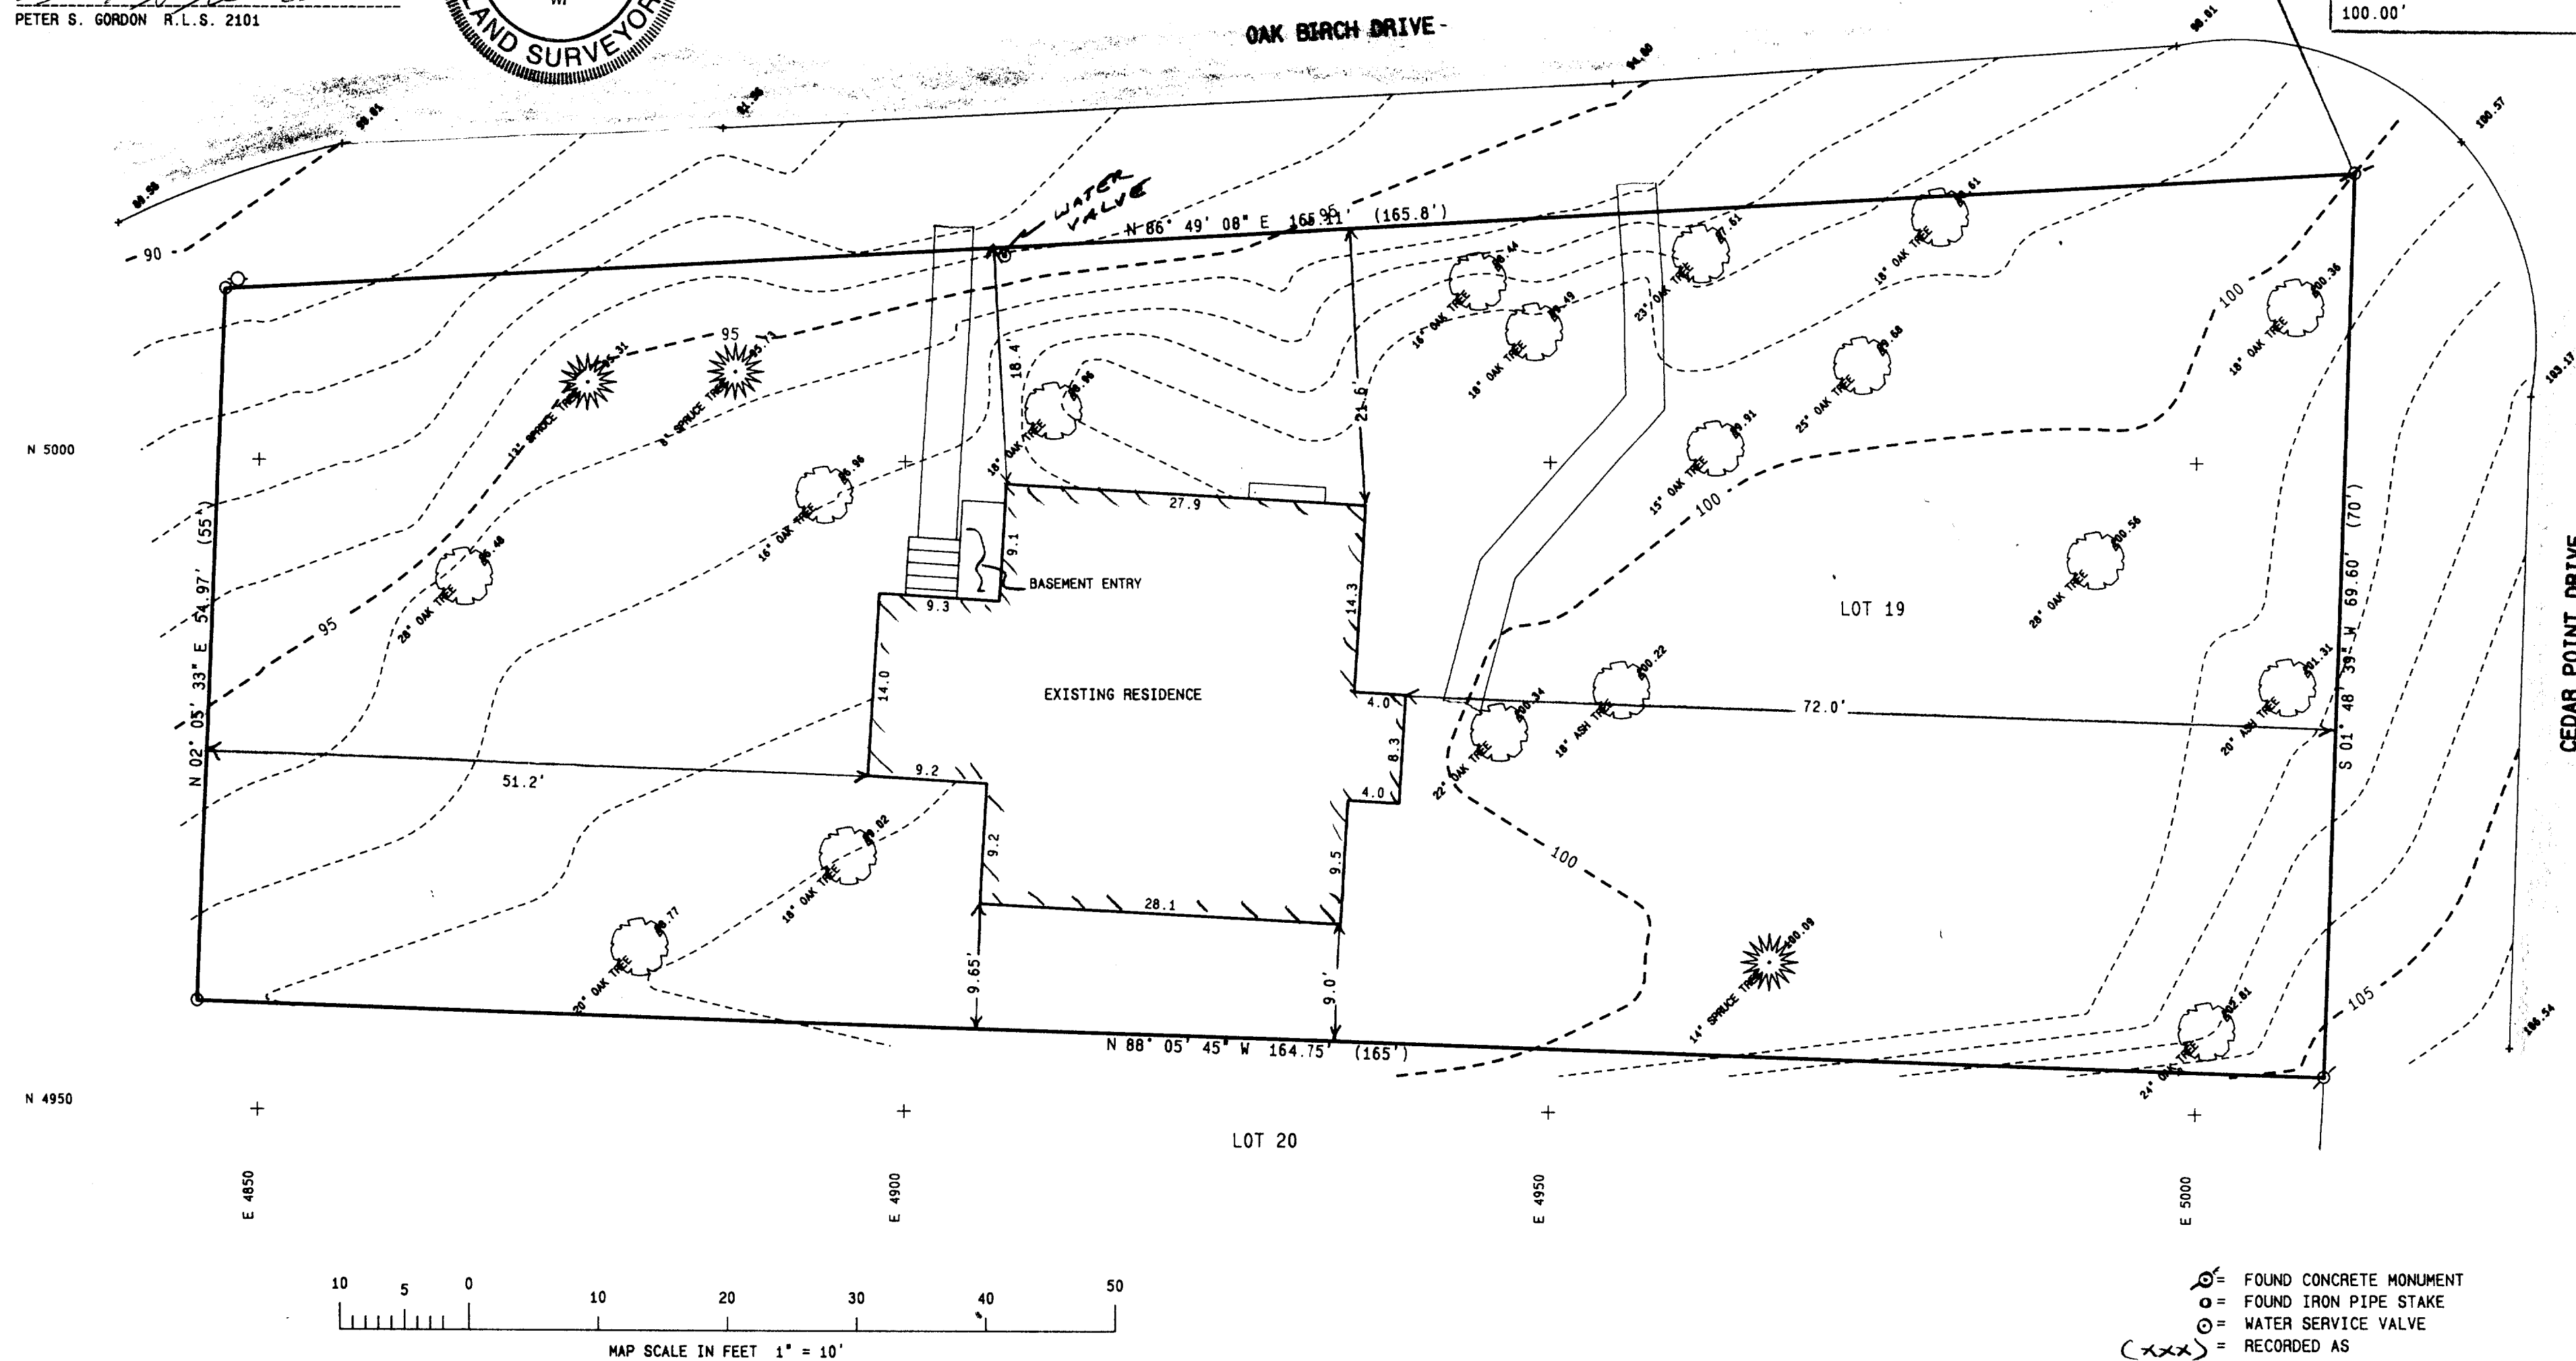

- ⊙ = FOUND CONCRETE MONUMENT
- = FOUND IRON PIPE STAKE
- ⊕ = WATER SERVICE VALVE
- (xxx) = RECORDED AS

WORK ORDERED BY: ROBERT MITCHELL
34 CEDAR POINT DRIVE
WILLIAMS BAY, WISCONSIN

FARRIS, HANSEN & ASSOCIATES, INC.
Engineering, Architecture, Surveying
7 Ridgeway Court, P.O. Box 437
ELKHORN, WISCONSIN 53121
Office: (414) 723-2098
Fax: (414) 723-5886

REVISIONS

PROJECT NO.
4365

DATE
09/05/95

SHEET NO.
1 OF 1

WCP1-17

011-1120