


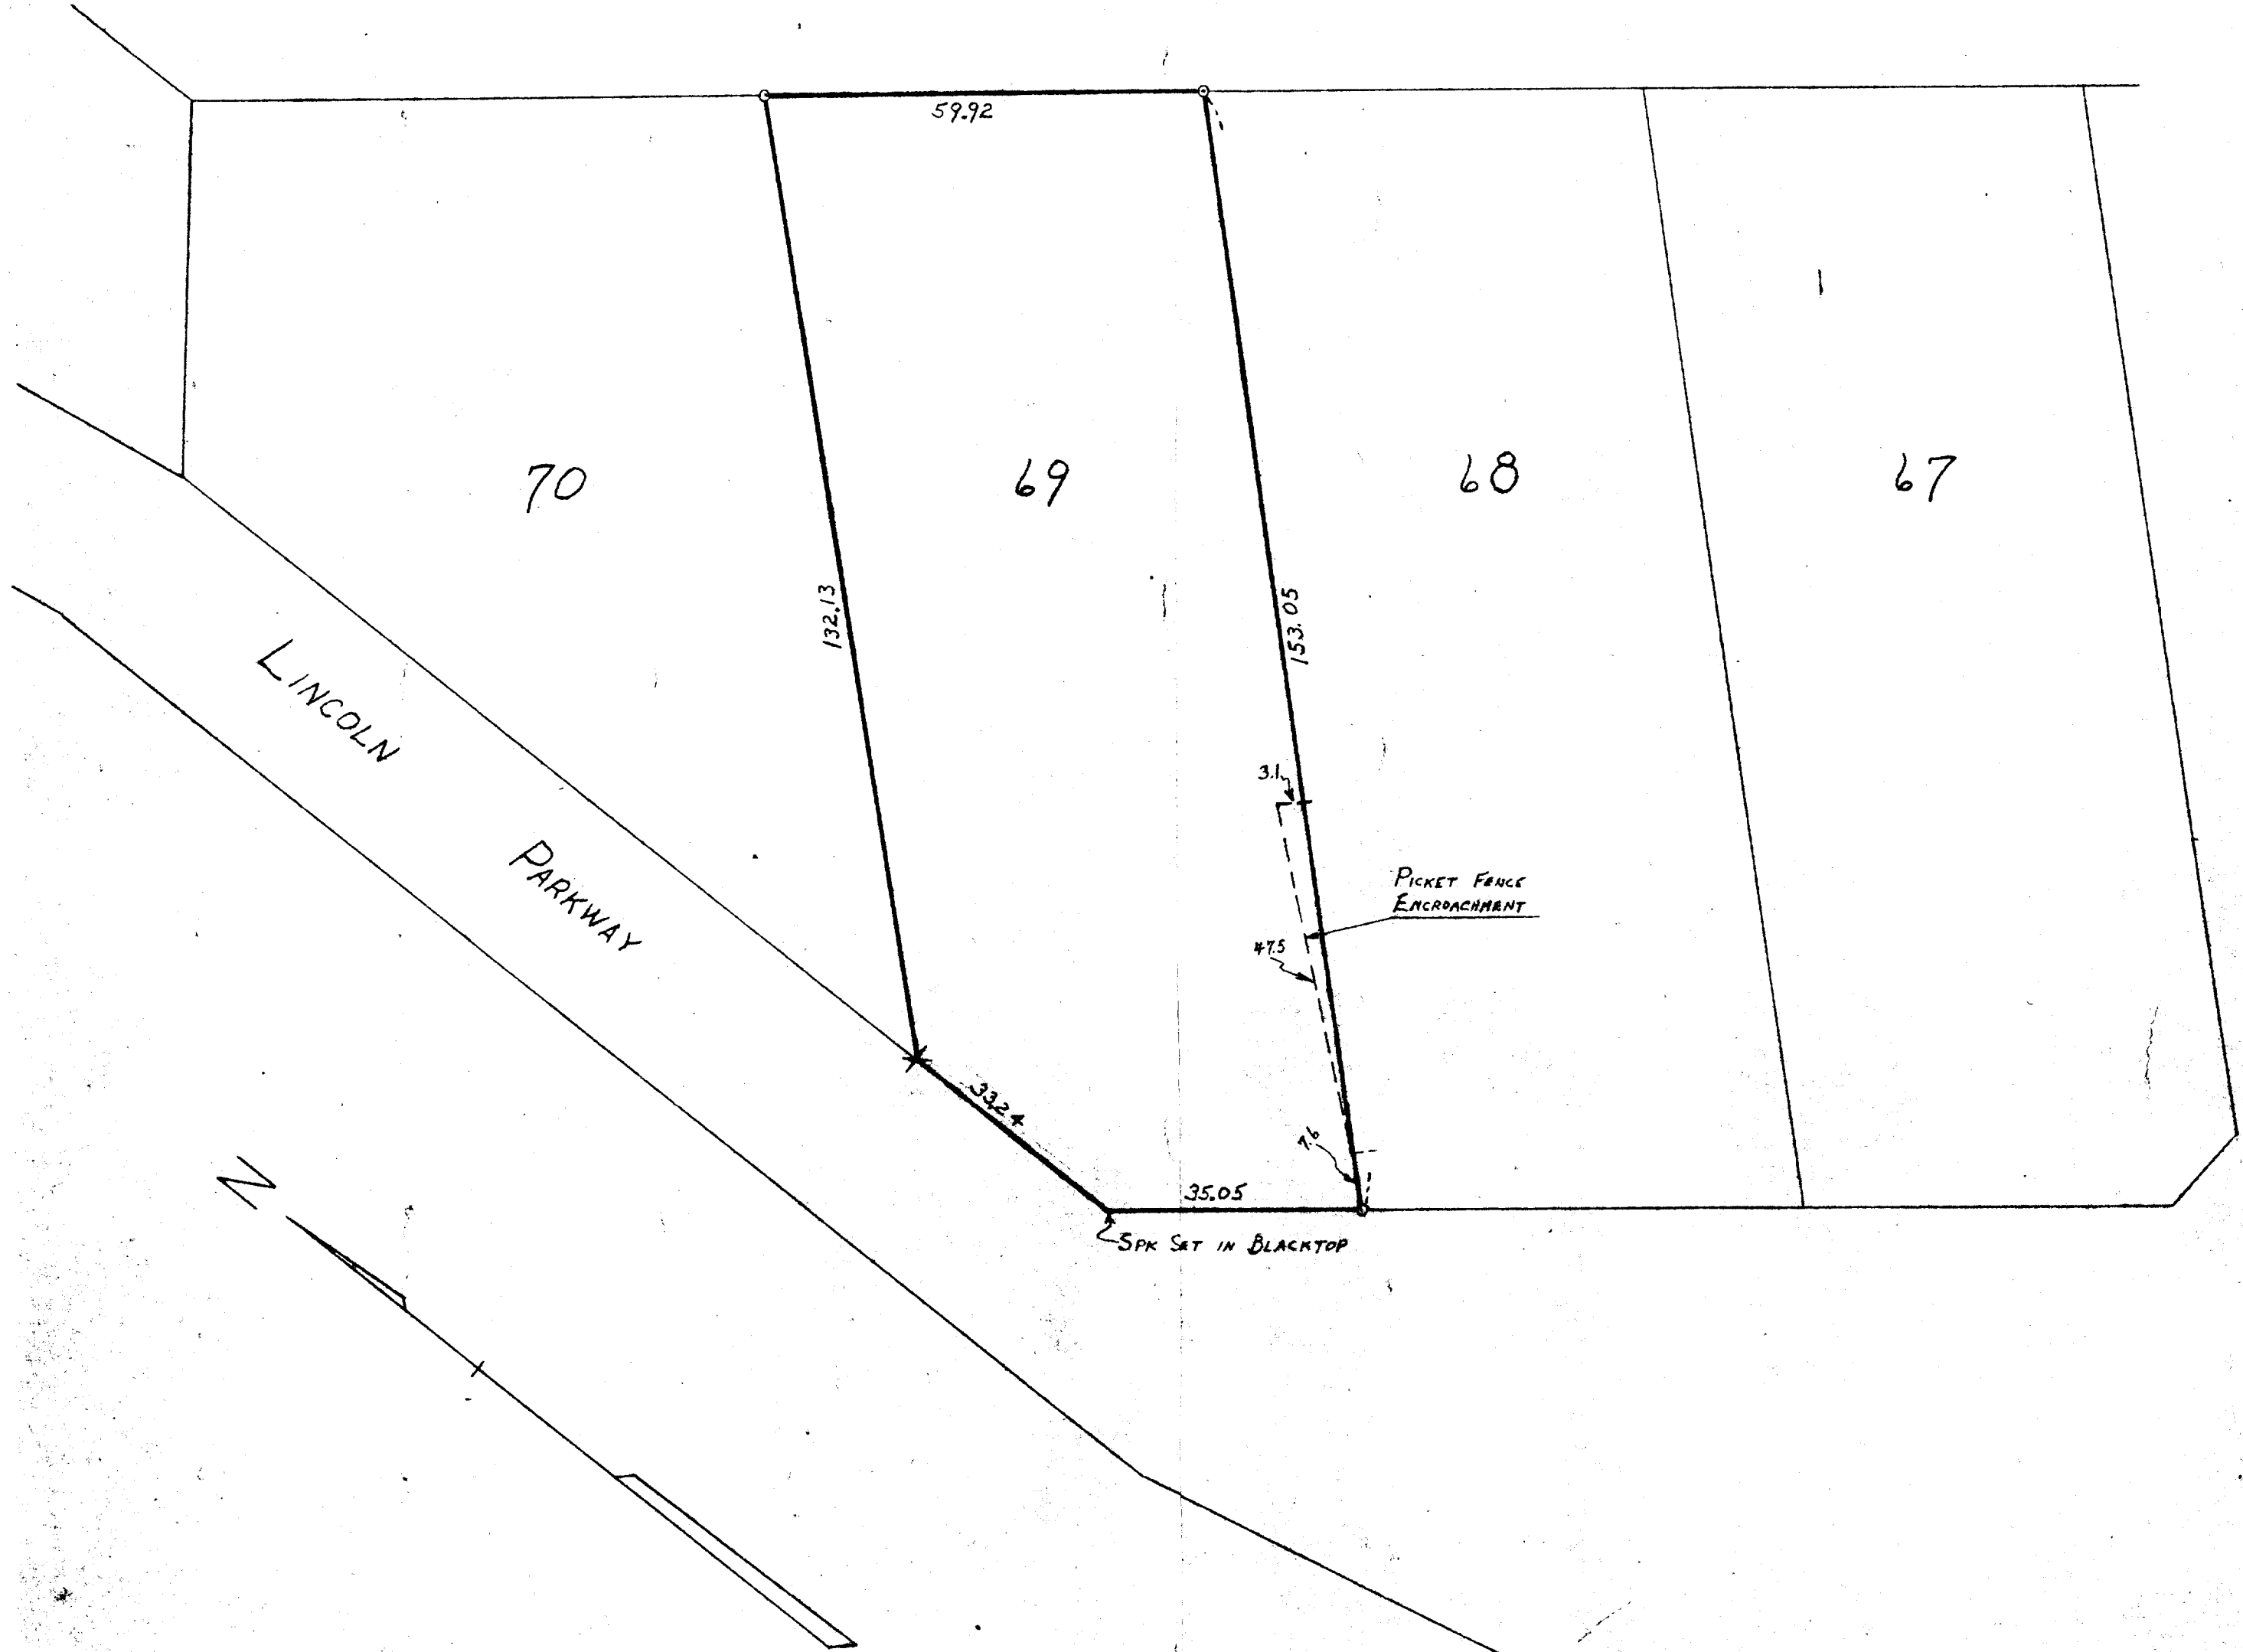

- o - IRON PIPE
- x - CROSS IN CONCRETE

PLAT OF SURVEY

LOT 69

OF
CEDAR POINT PARK ORIGINAL IN THE
VILLAGE OF WILLIAMS BAY, WALWORTH
COUNTY, WISCONSIN

[Signature]

11-114 J

SCALE 1" = 20'

DATE OCT. 5, 1953