

TEL. 414-723-2098

MAP SCALE IN FEET

MAP LEGEND


- - IRON PIPE STAKE FOUND
- IRON PIPE STAKE SET
- - IRON ROD STAKE FOUND
- IRON ROD STAKE SET
- CONCRETE MONUMENT FOUND
-) - RECORD DIMENSION

(XXXXX) = RECORD DIMENSION

WORK ORDERED BY: GENE SIMONS
RE-MAX LAKE GENEVA
101 BROAD STREET
LAKE GENEVA, WI.



S. LINE LOT 40 ASSIGNED THE BEARING N 89°25'W AS RECORDED AS THE BASIS FOR BEARINGS ON THIS PLAT

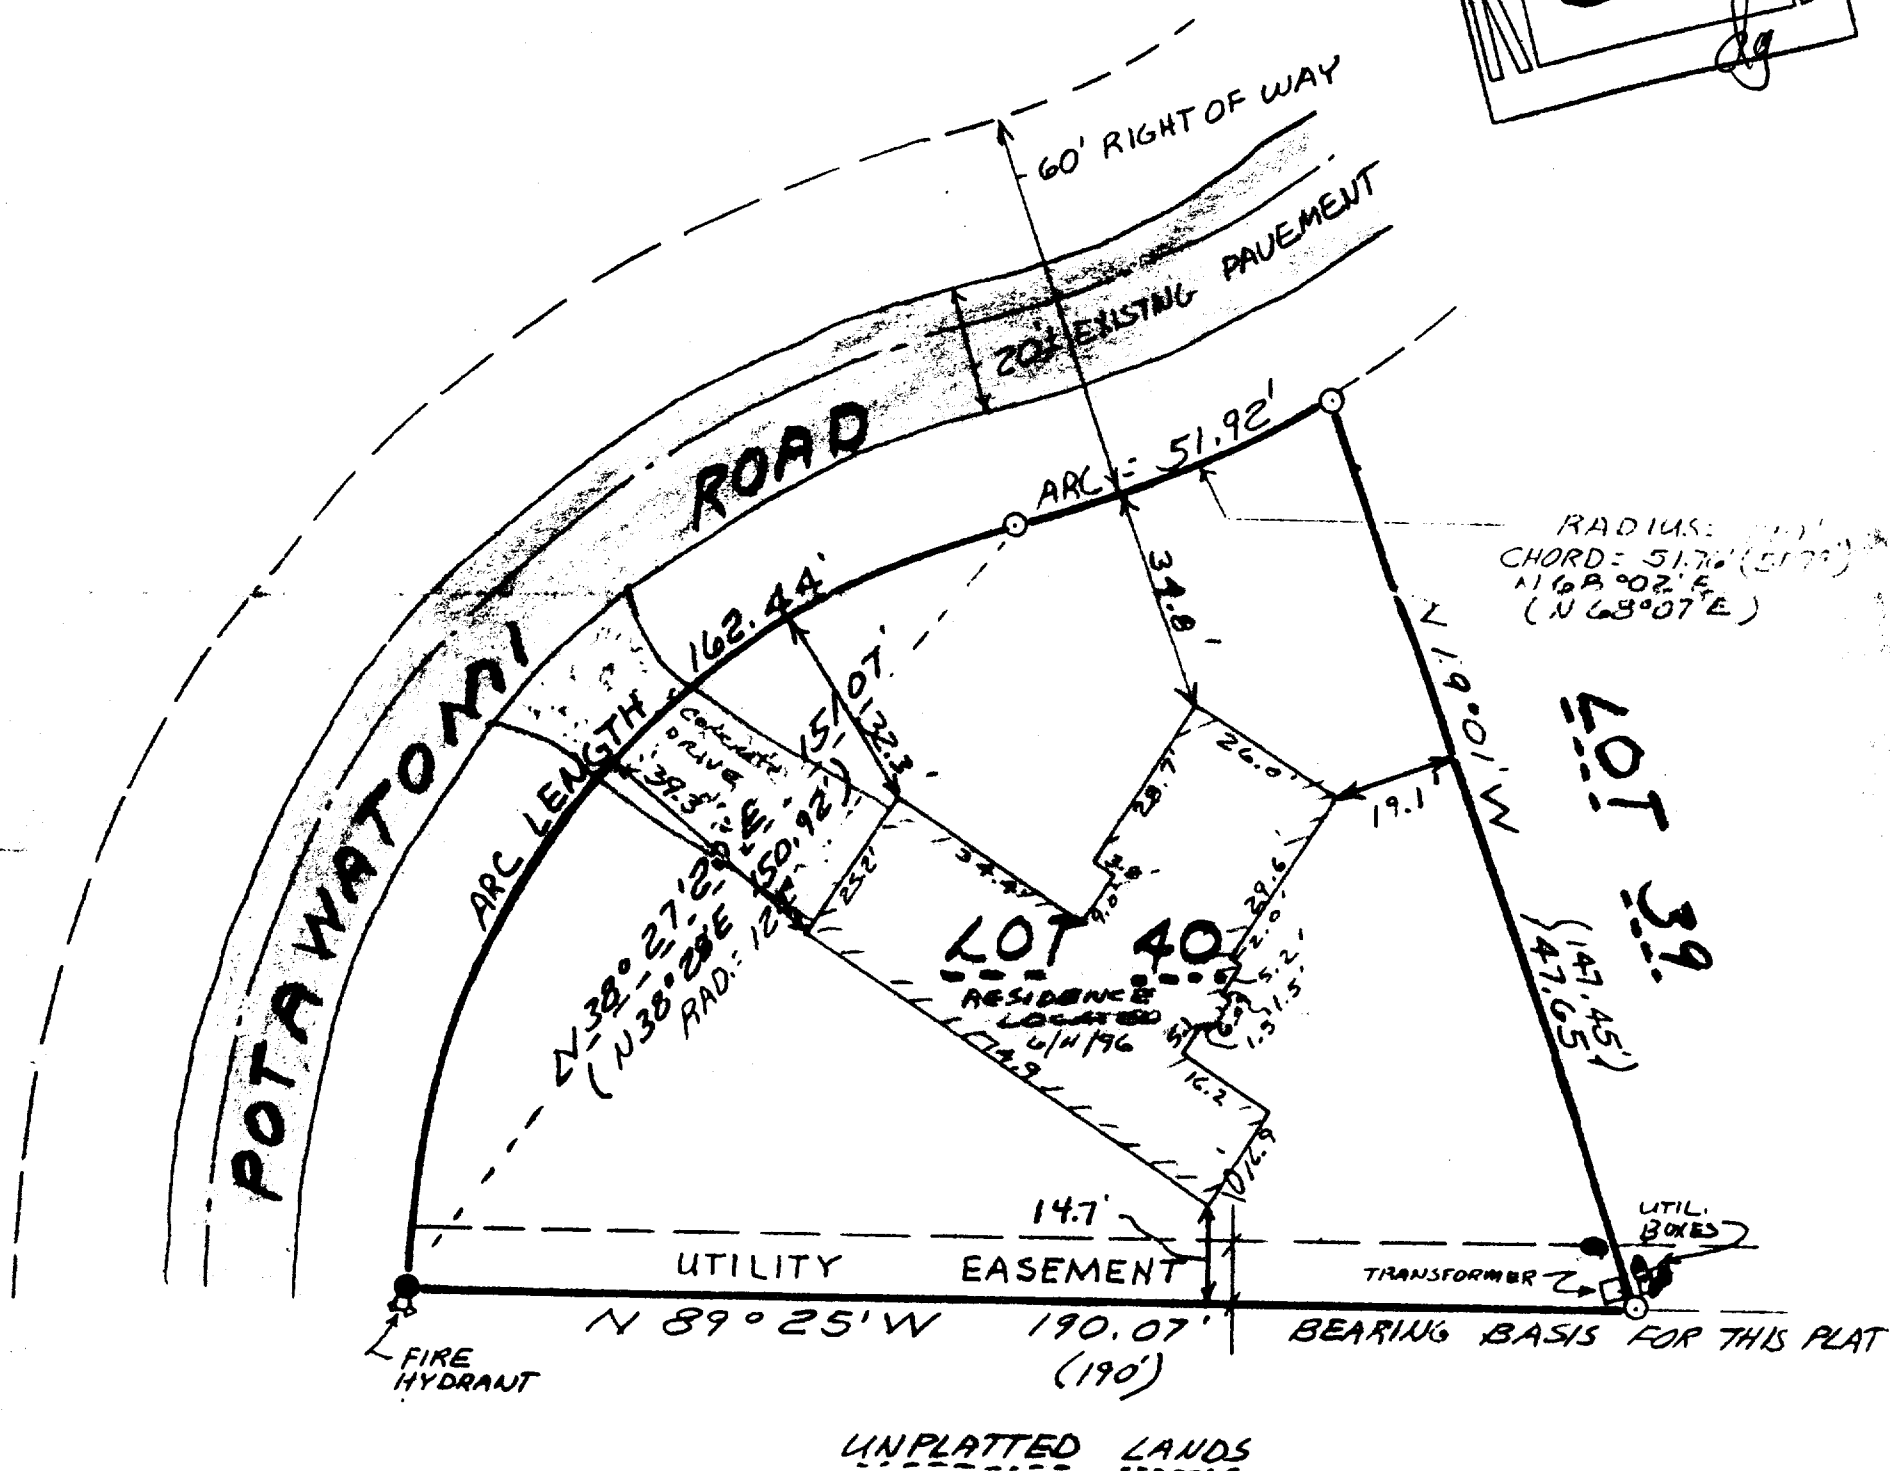

I HEREBY CERTIFY THAT THE ABOVE DESCRIBED PROPERTY HAS BEEN SURVEYED UNDER MY DIRECTION AND THAT THE ABOVE MAP IS A TRUE REPRESENTATION THEREOF AND SHOWS THE SIZE AND LOCATION OF THE PROPERTY AND ITS EXTERIOR BOUNDARIES. THIS SURVEY IS MADE FOR THE USE OF THE PRESENT OWNERS OF THE PROPERTY, AND ALSO THOSE WHO PURCHASE, MORTGAGE, OR GUARANTEE THE TITLE THERETO WITHIN ONE YEAR FROM THE DATE HEREOF.

W4W-240

DATED: 4/22/1996

REVISED 06/12/1996 ADD INTERIOR DETAIL



PROJECT NO. 3004

~~XXXXXXXXXXXXXXXXXXXX~~

11-1152