

FARRIS, HANSEN & ASSOCIATES, INC.

7 RIDGEMAY COURT, P.O. BOX 487, ELKHORN, WISCONSIN

TEL. 414-723-2098

LOCATION: LOT 40 OF WILLABAY WOODS IN SEC. 6-1-17
VILLAGE OF WILLIAMS BAY, WALNORTH CO., WI.

WORK ORDERED BY: ~~GLORIA DUNBAR~~




MAP SCALE IN FEET



MAP LEGEND

- = IRON PIPE STAKE FOUND
- = IRON PIPE STAKE SET
- = IRON ROD STAKE FOUND
- = IRON ROD STAKE SET
- = CONCRETE MONUMENT FOUND
- (XXXXX) = RECORD DIMENSION

WORK ORDERED BY: GENE SIMONS
RE-MAX LAKE GENEVA
101 BROAD STREET
LAKE GENEVA, WI

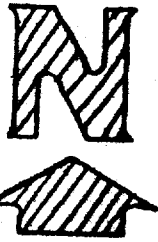

S. LINE LOT 40 ASSIGNED THE BEARING N 89°25'W AS RECORDED AS THE BASIS FOR BEARINGS ON THIS PLAT

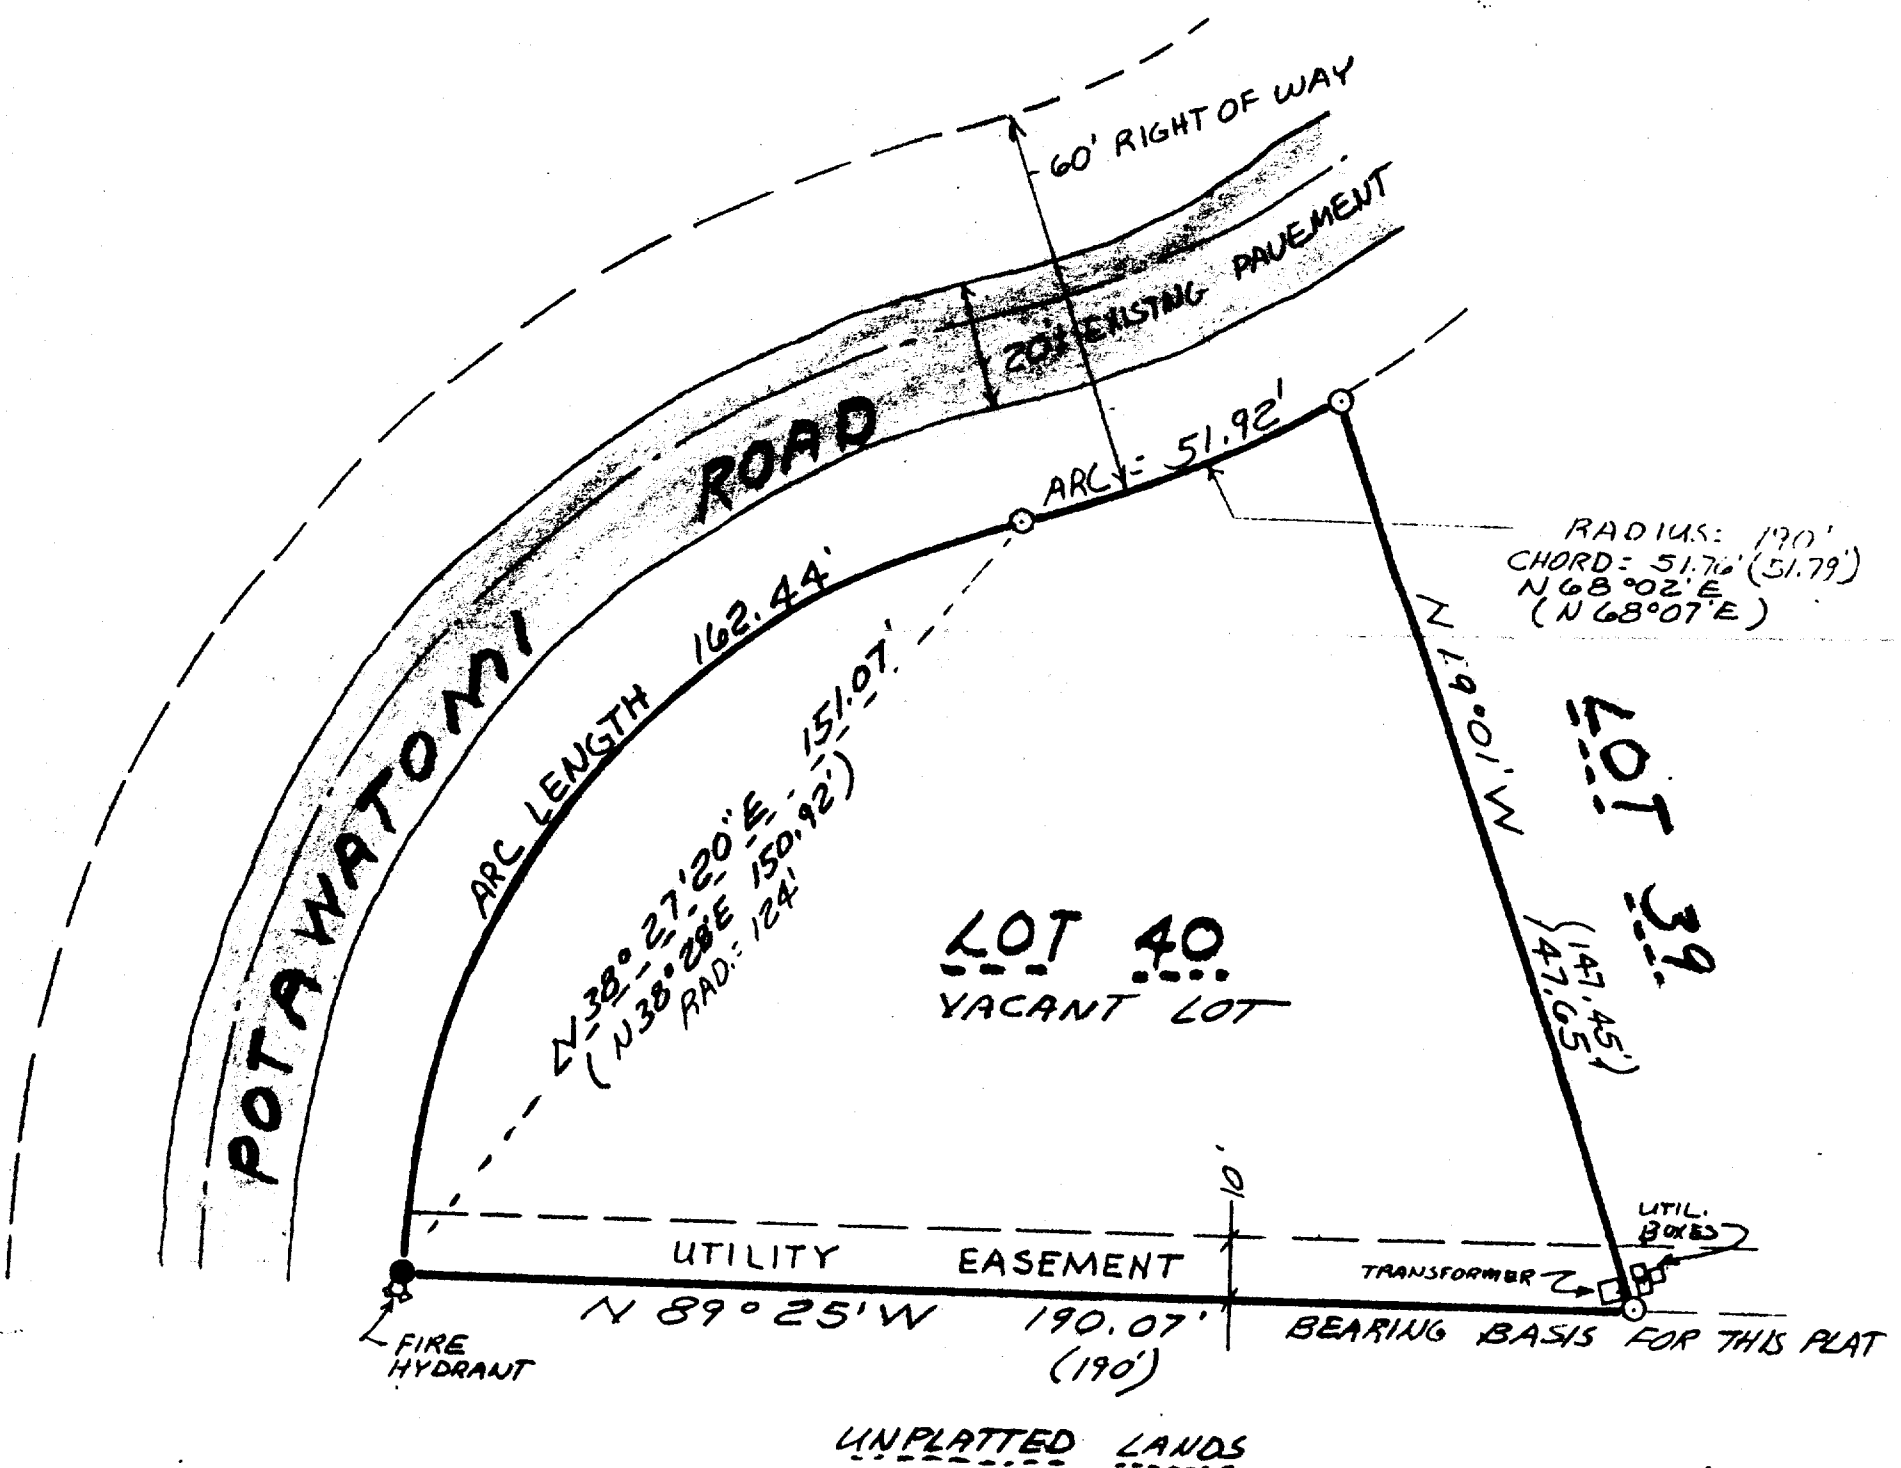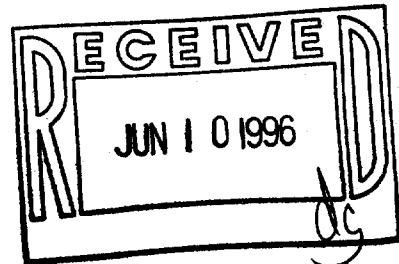

NOTE: COPIES OF THIS MAP TO WHICH THE FOLLOWING CERTIFICATE WILL APPLY ARE BLUE LINE PRINTS SHOWING SURVEYOR'S ORIGINAL SEAL AND SIGNATURE IN BLACK INK. COPIES BY ANY OTHER MEANS MAY HAVE ALTERATIONS WHICH DO NOT REPRESENT THE SURVEYOR'S WORK PRODUCT.

I HEREBY CERTIFY THAT THE ABOVE DESCRIBED PROPERTY HAS BEEN SURVEYED UNDER MY DIRECTION AND THAT THE ABOVE MAP IS A TRUE REPRESENTATION THEREOF AND SHOWS THE SIZE AND LOCATION OF THE PROPERTY AND ITS EXTERIOR BOUNDARIES. THIS SURVEY IS MADE FOR THE USE OF THE PRESENT OWNERS OF THE PROPERTY, AND ALSO THOSE WHO PURCHASE, MORTGAGE, OR GUARANTEE THE TITLE THERETO WITHIN ONE YEAR FROM THE DATE HEREOF.

DATED: 4/22/1996

[Signature]



PROJECT NO. 3004

WUW-40
11-1161