



FARRIS, HANSEN & ASSOC., INC.
7 RIDGEWAY COURT
ELTHORN, WI.

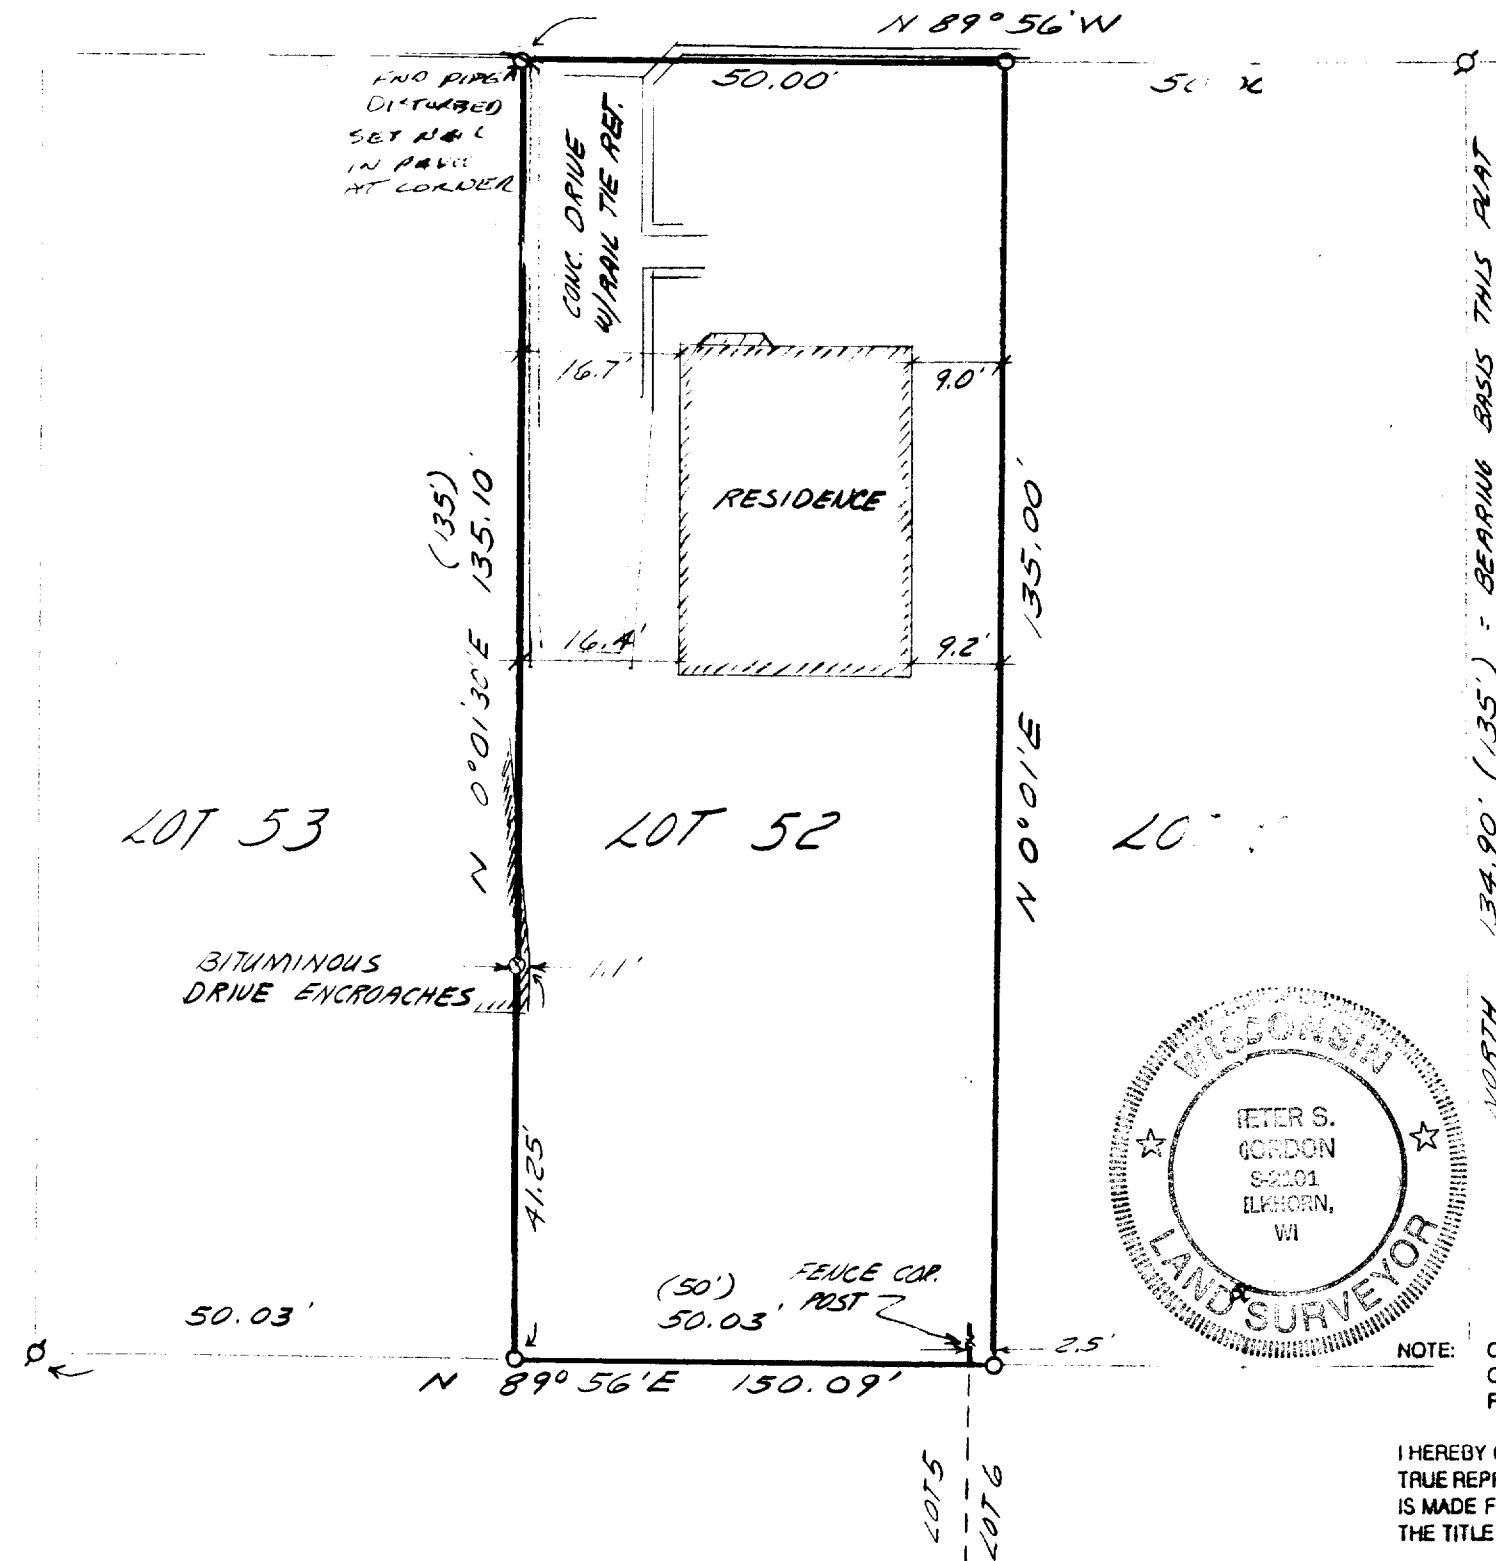


- = IRON PIPE SURVEY STAKE FOUND
- = IRON PIPE STAKE SET
- ⊗ = CONCRETE NAIL (PK) SET IN PAVEMENT
- (xxxx) = ORIGINAL SUBDIVISION PLAT DIMENSION WORK ORDERED BY SUSAN ACKLEY

PLAT OF SURVEY OF LOT 52 OF
SUMMER HAVEN LOCATED IN SE 1/4 SECTION 1,
TOWN 1 NORTH, RANGE 16 EAST, VILLAGE OF
WILLIAMS BAY, WALWORTH COUNTY, WISCONSIN

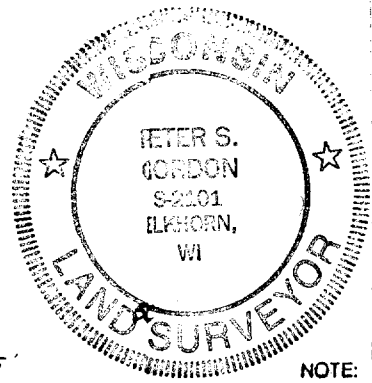

NOTE: COPIES OF THIS MAP TO WHICH THE FOLLOWING CERTIFICATE WILL APPLY ARE BLUE LINE PRINTS SHOWING SURVEYOR'S ORIGINAL SEAL AND SIGNATURE IN BLACK INK. COPIES BY ANY OTHER MEANS MAY HAVE ALTERATIONS WHICH DO NOT REPRESENT THE SURVEYOR'S WORK PRODUCT.

I HEREBY CERTIFY THAT THE ABOVE DESCRIBED PROPERTY HAS BEEN SURVEYED UNDER MY DIRECTION AND THAT THE ABOVE MAP IS A TRUE REPRESENTATION THEREOF AND SHOWS THE SIZE AND LOCATION OF THE PROPERTY AND ITS EXTERIOR BOUNDARIES. THIS SURVEY IS MADE FOR THE USE OF THE PRESENT OWNERS OF THE PROPERTY, AND ALSO THOSE WHO PURCHASE, MORTGAGE, OR GUARANTEE THE TITLE THERETO WITHIN ONE YEAR FROM THE DATE HEREOF.

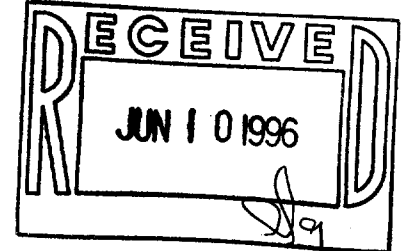

WSU-44

11-1162

JEWELL'S 3413

DATED: 4/10/1996 *Peter S. Gordon* PROJECT NO. 2413