


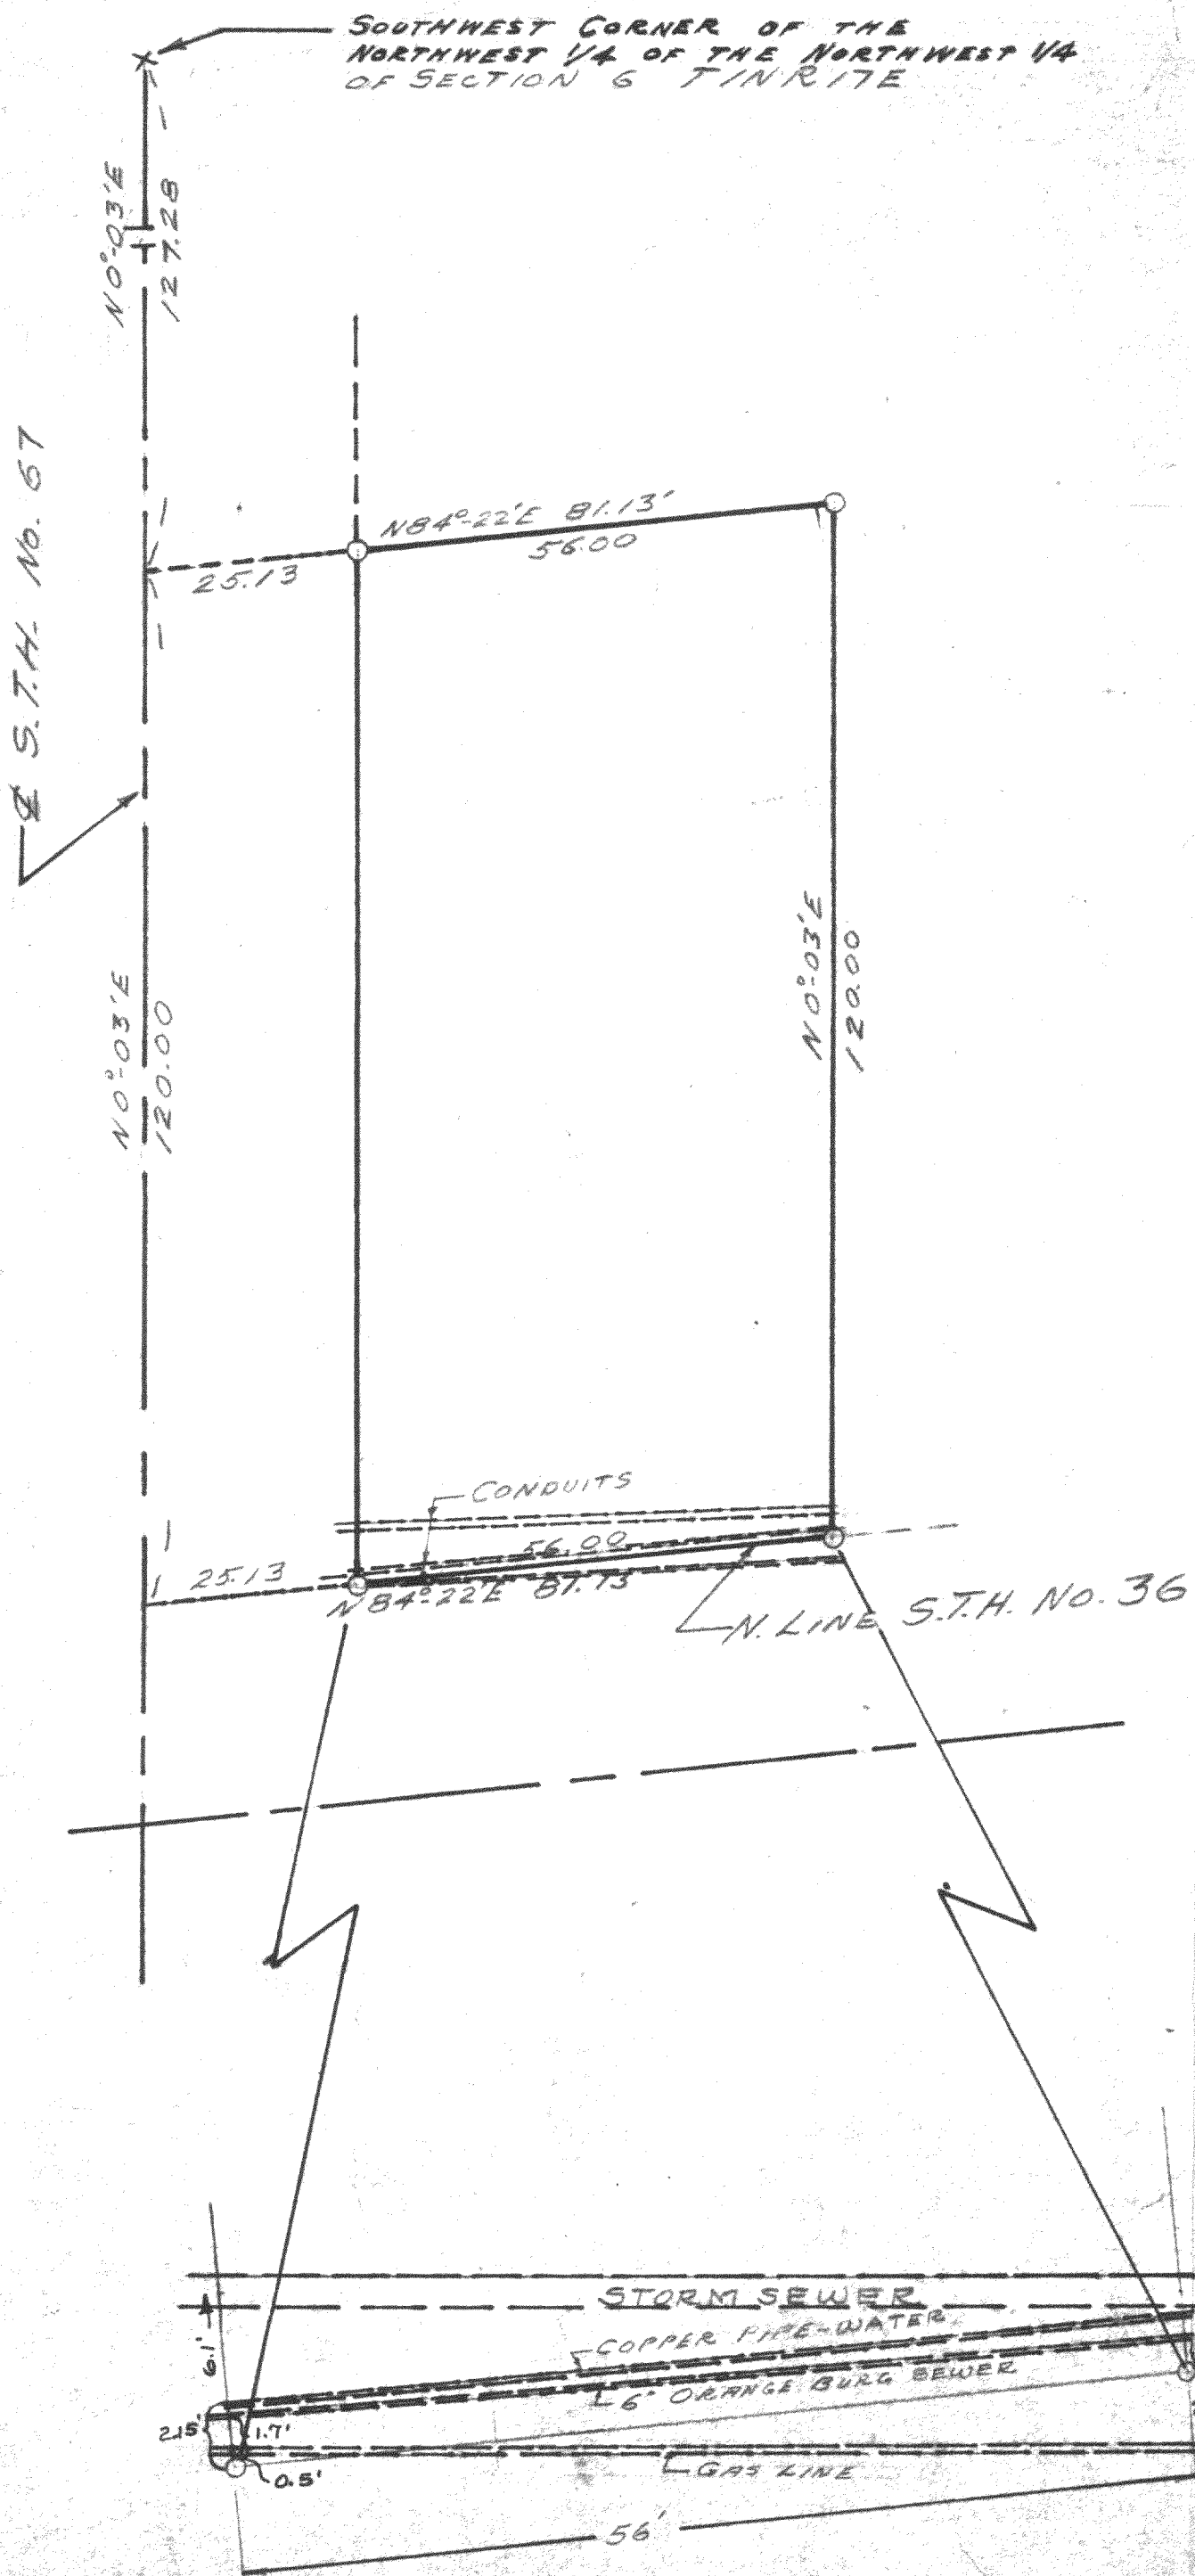

PLAT OF SURVEY
OF
LAND
LOCATED IN THE SOUTHWEST
1/4 OF THE NORTHWEST 1/4 OF
SECTION 6 T17N R17E
WALWORTH CO., WISCONSIN

Lloyd L. Jensen
SURVEYOR

SCALE 1" = 20'

DATE AUG. 23, 1939

11-116 J