

ABERNATHY and ASSOCIATES

Kenneth B. Abernathy Jr.

Wisconsin Registered Land Surveyor S-1594

Rt. 3, Box 273
Elkhorn, Wisconsin 53121
Phone: (414) 723-4260 (office)
(414) 723-7209 (FAX)



PLAT OF SURVEY

Lot 94 of Baywood Heights Addition No. 2 in the Village of Williams Bay, Walworth County, Wisconsin according to the plat thereof recorded in the Walworth County, Register of Deeds in Cabinet B of Plats on Slide 97 as Document No. 197248.

LOT 95


Ordered by: Preferred Homes
2903 Borg Road
Delavan, Wi. 53115

Client: Joel and Kristi Collins

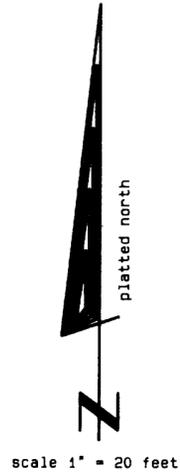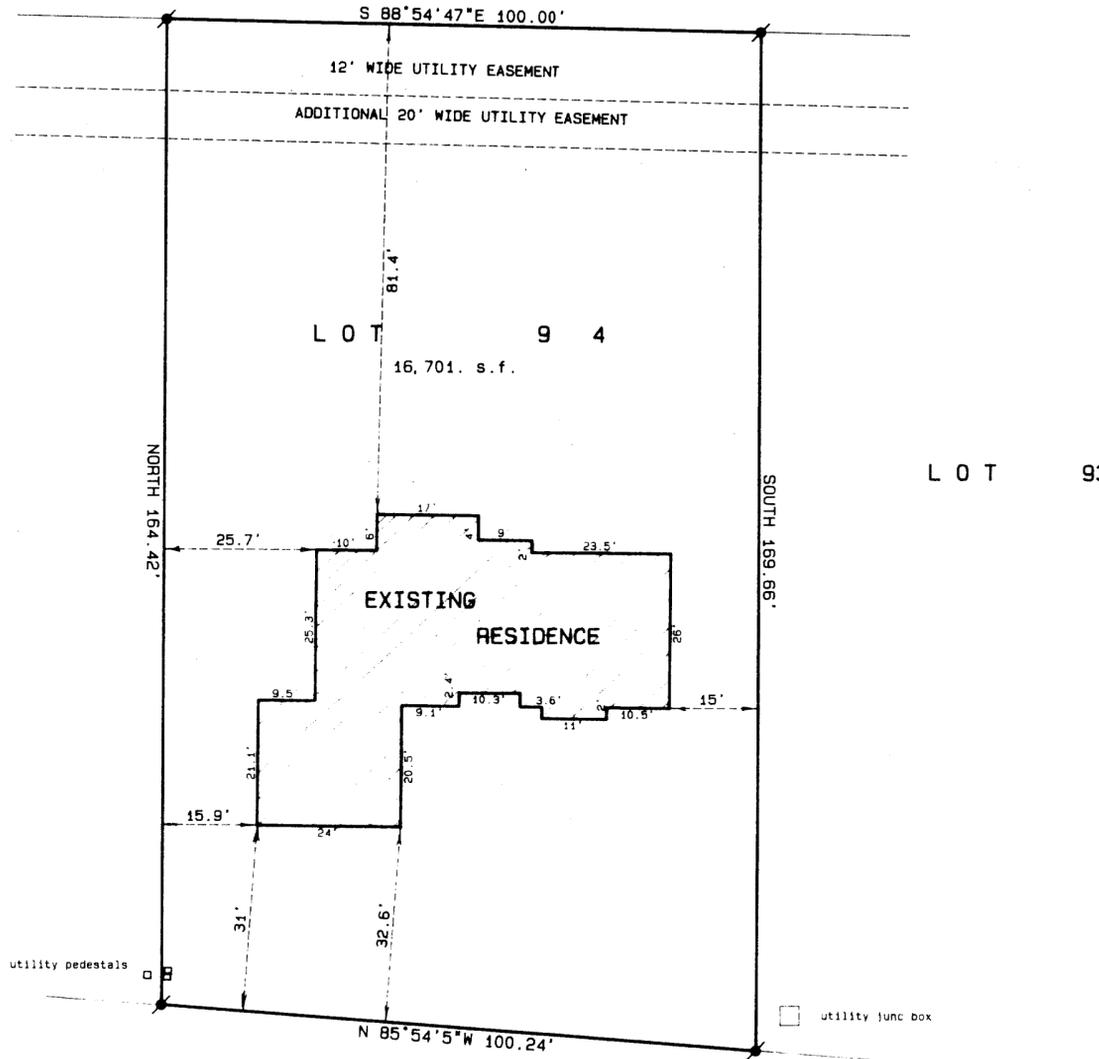

Legend

- FOUND IRON PIPE
- FOUND IRON ROD
- FOUND BRASS CAPPED MONUMENT
- ✱ FOUND CONCRETE MONUMENT
- ✱ CHISEL CUT IN CONCRETE
- SET IRON ROD, 24\"/>

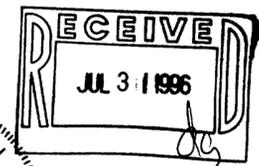

SCALE: 1" = 20 FEET

"I hereby certify that the above described property has been surveyed by me or under my direction and that the above map is a true representation thereof and shows the size and location of the property, its exterior boundaries, the location of all visible structures and dimensions of all principal buildings thereon, boundary fences, apparent easements, roadways and visible encroachments, if any."

"This survey is made for the use of the present owners of the property and also those who purchase, mortgage, or guarantee the title thereto within one year from date hereof."

Kenneth B. Abernathy, Jr.
 KENNETH B. ABERNATHY, JR.
 WISCONSIN REGISTERED LAND SURVEYOR,
 S-1594

Date: 6/25/96 Job No. 96.324

AS BUILT RESIDENCE REVISION DATED 6/25/96.

10BW2-45
11-1172

DESIGN PRODUCTS