


Services Offered

Commercial Site Development
Subdivision Design and Platting
Planning and Plan Review
Streets and Highway Design
Drainage Studies
Water Distribution Systems
Sewer Collection Systems
Construction Surveying and Stake-out Services
GPS Surveying
Certified Soil Testing

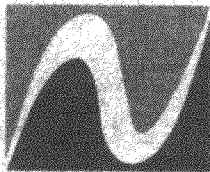

Nienow Engineering Assoc.
Consulting Engineers and Surveyors
229 E. Main Street
Waterford, WI 53185
(414) 534-9190 Fax (414) 534-9192

962849
962849S1.DWG


PLAT OF SURVEY

LOT 4 OF BLOCK 1, LAKEWOOD TRAILS SUBDIVISION,
LOCATED IN THE NORTHEAST 1/4 AND THE NORTHWEST 1/4 OF THE NORTHWEST 1/4 OF
SECTION 1, TOWN 1 NORTH, RANGE 16 EAST,
VILLAGE OF WILLIAMS BAY, WALWORTH COUNTY, WISCONSIN

LAKEWOOD DRIVE
(66' WIDE)

BENCHMARK
TOP OF IRON ROD
ELEV: 1026.60


SURVEY PREPARED FOR:
D.B.I. HOME BUILDERS
BOX 5360 RFD
LONGROVE, IL 60047

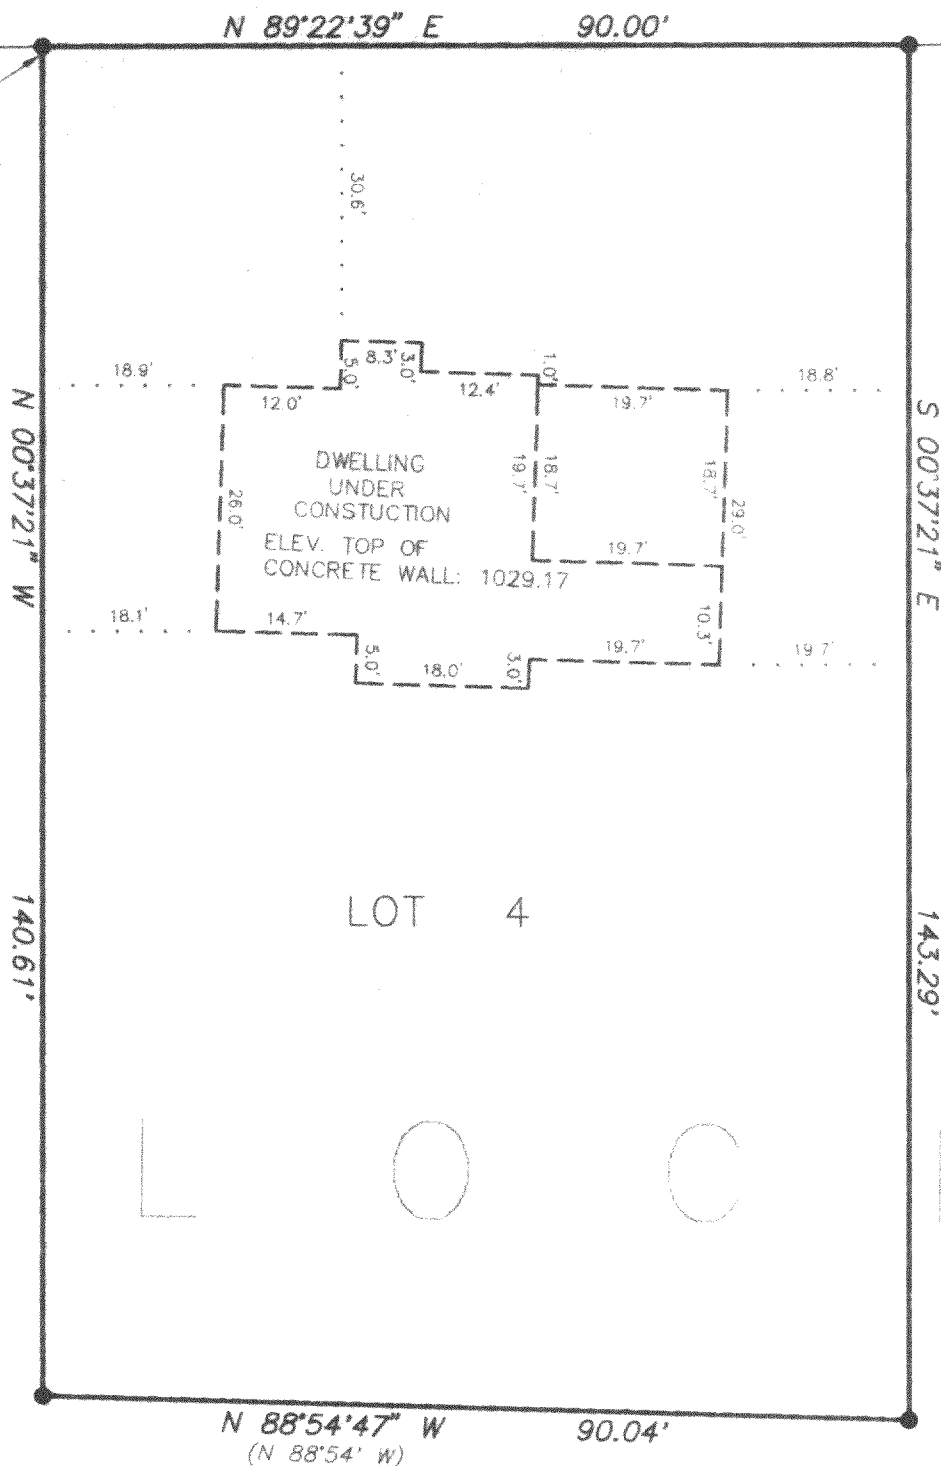

LEGEND


- - FOUND IRON ROD
- () - RECORDED AS

BEARINGS BASED ON
NORTH LINE OF LOT 4, BLOCK 1
LAKEWOOD TRAILS SUBDIVISION
RECORDED BEARING: N 89°22'39" E

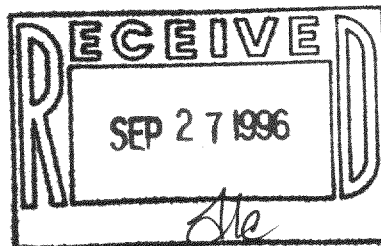

STATE OF WISCONSIN)
RACINE COUNTY)

SCALE: 1" = 20'

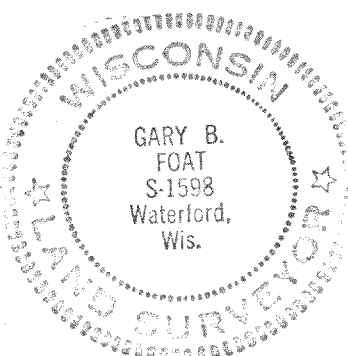

I HEREBY CERTIFY THAT I HAVE SURVEYED THE ABOVE DESCRIBED PROPERTY AND THE ABOVE MAP IS A TRUE REPRESENTATION THEREOF AND SHOWS THE SIZE AND LOCATION OF THE PROPERTY, THE LOCATION OF ALL VISIBLE STRUCTURES AND DIMENSIONS OF ALL PRINCIPAL BUILDINGS THEREON, BOUNDARY FENCES, APPARENT EASEMENTS, ROADWAY AND VISIBLE ENCROACHMENTS, IF ANY.

THIS SURVEY IS MADE FOR THE PRESENT OWNERS OF THE PROPERTY, AND ALSO THOSE WHO PURCHASE, OR GUARANTEE THE TITLE THERETO WITHIN (1) YEAR FROM THE DATE HEREOF.

DATED AT WATERFORD THIS 26TH DAY OF AUGUST 19 96

RECERTIFIED 8-26-96 Jay B. Foat

WLAK-4

11-1178