



**PLAT OF SURVEY**  
 LOT I AND THE WEST 5 FEET OF LOT H IN  
 LOCH VISTA CLUB SUBDIVISION NO. 2  
 AND THE SOUTH 1/3 OF LOT 25  
 IN LOCH VISTA CLUB SUBDIVISION NO. 1  
 VILLAGE OF WILLIAMS BAY, WALWORTH COUNTY, WISCONSIN

NOTE: COPIES OF THIS MAP TO WHICH THE FOLLOWING CERTIFICATE WILL APPLY ARE BLUE LINE PRINTS SHOWING SURVEYOR'S ORIGINAL SEAL AND SIGNATURE IN BLACK INK. COPIES BY ANY OTHER MEANS MAY HAVE ALTERATIONS WHICH DO NOT REPRESENT THE SURVEYOR'S WORK PRODUCT.


I HEREBY CERTIFY THAT THE ABOVE DESCRIBED PROPERTY HAS BEEN SURVEYED UNDER MY DIRECTION AND THAT THE ABOVE MAP IS A TRUE REPRESENTATION THEREOF AND SHOWS THE SIZE AND LOCATION OF THE PROPERTY AND ITS EXTERIOR BOUNDARIES. THIS SURVEY IS MADE FOR THE USE OF THE PRESENT OWNERS OF THE PROPERTY, AND ALSO THOSE WHO PURCHASE, MORTGAGE, OR GUARANTEE THE TITLE THERETO WITHIN ONE YEAR FROM THE DATE HEREOF.

DATED: 8-30-96

*Peter S. Gordon*  
 PETER S. GORDON R.L.S. 2101



- = FOUND IRON PIPE STAKE
- = FOUND IRON REBAR STAKE
- ▲ = SET IRON REBAR STAKE
- ▲ = SET NAIL IN PAVEMENT
- (x) = RECORDED AS

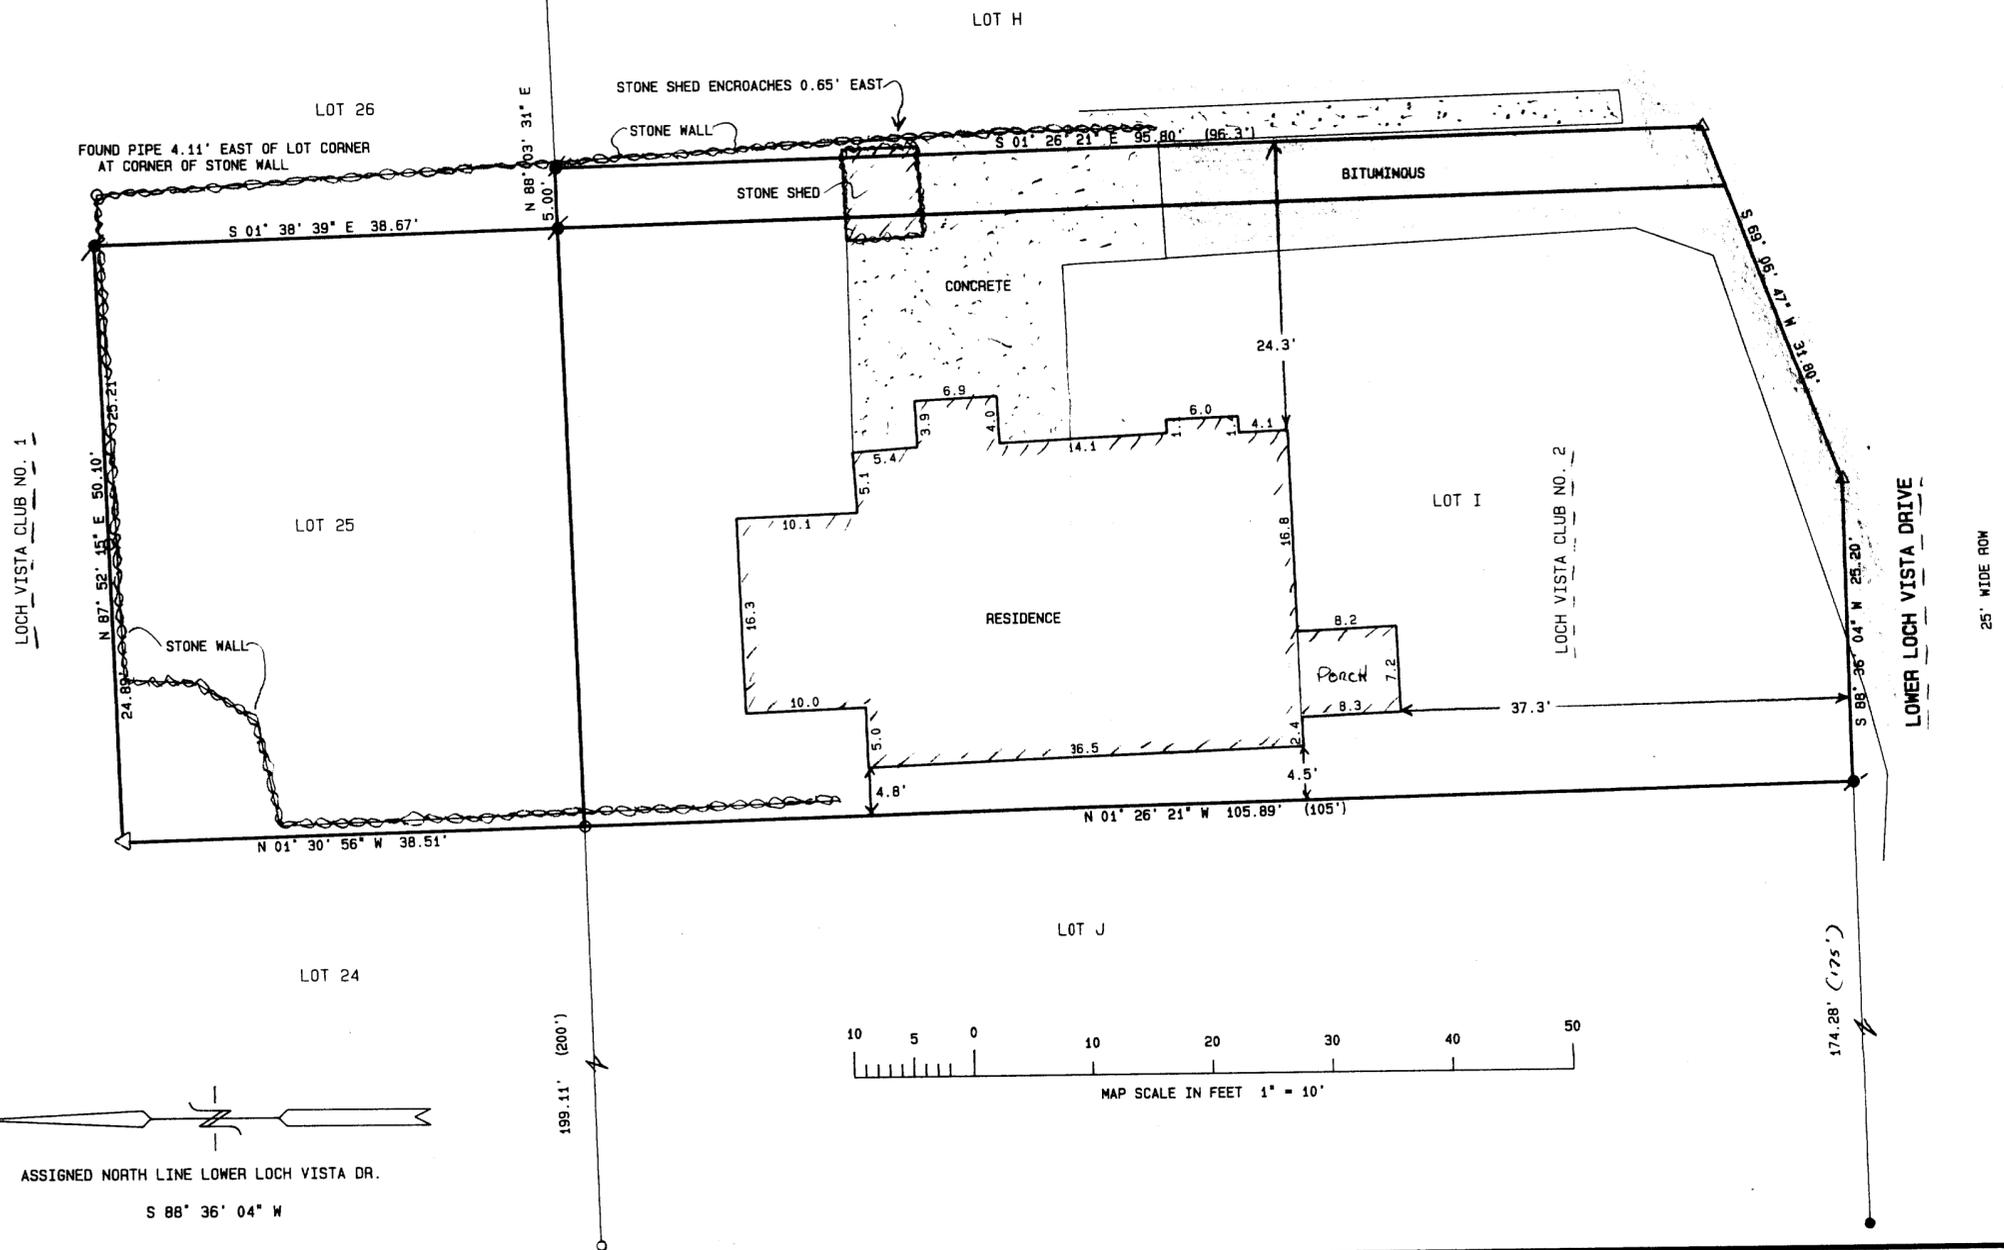

WORK ORDERED BY: PATRICK M. HOURIGAN  
 78 LOWER LOCH VISTA  
 WILLIAMS BAY, WISCONSIN 53191

**FARRIS, HANSEN & ASSOCIATES, INC.**  
 Engineering, Architecture, Surveying  
 7 Ridgway Court, P.O. Box 437  
 ELKHORN, WISCONSIN 53121  
 Office: (414) 723-2098  
 Fax: (414) 723-5886

REVISIONS

PROJECT NO. 4611  
 DATE 08/29/96  
 SHEET NO. 1 OF 1

WLV-19  
 WLV2-8  
 11-1185

