

Plat of Survey


of

Elevations taken on the Lake Geneva Campus of the George Williams Educational Centers, located in the Northwest 1/4 of Section 12, Town 1 North, Range 16 East, Village of Williams Bay, Walworth County, Wisconsin.

Ordered by: **Dr. Bill Duncan**

**Concrete at South End
of door #1.**

Elevation = 951.69

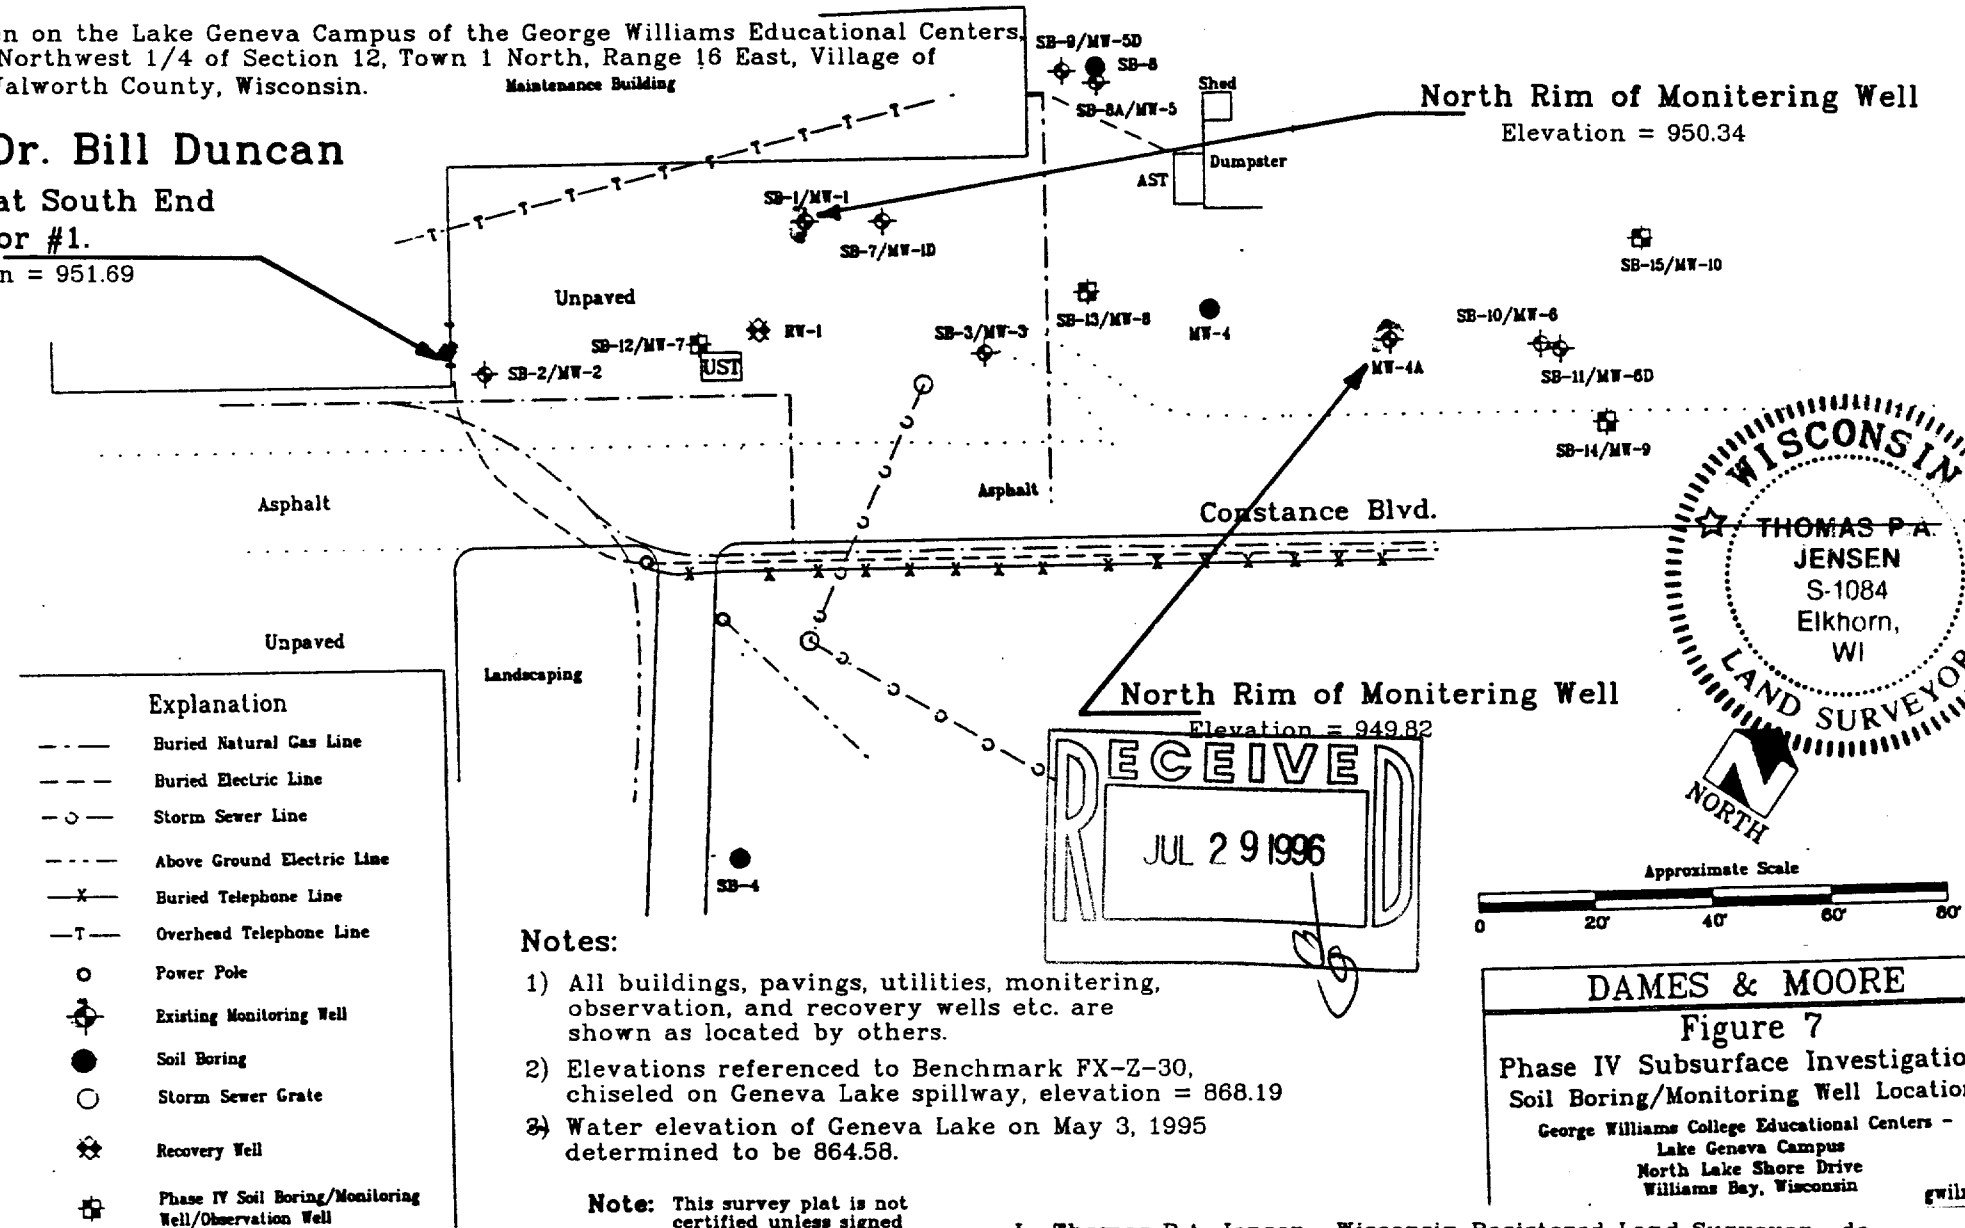

Explanation

- Buried Natural Gas Line
- Buried Electric Line
- o- Storm Sewer Line
- Above Ground Electric Line
- x- Buried Telephone Line
- T- Overhead Telephone Line
- o Power Pole
- Existing Monitoring Well
- Soil Boring
- o Storm Sewer Grate
- Recovery Well
- Phase IV Soil Boring/Monitoring Well/Observation Well

Notes:

- 1) All buildings, pavings, utilities, monitoring, observation, and recovery wells etc. are shown as located by others.
- 2) Elevations referenced to Benchmark FX-Z-30, chiseled on Geneva Lake spillway, elevation = 868.19
- 3) Water elevation of Geneva Lake on May 3, 1995 determined to be 864.58.

Note: This survey plat is not certified unless signed and sealed in red ink.

Copyright © 1995 by Jensen Surveying & Mapping S.C.

All rights reserved. No part of this survey plat may be reproduced or transmitted in any form by any means - graphic, electronic, or mechanical, including photocopying, tracing, or information storage and retrieval systems - without permission in writing from Thomas P.A. Jensen, Jensen Surveying & Mapping S.C.

I, Thomas P.A. Jensen, Wisconsin Registered Land Surveyor, do hereby certify that this survey was performed by me, or under my direction in full compliance with the owner's / agent's instructions and Chapter A-E 7 of the Wisconsin Administrative Code "Minimum Standards for Property Surveys"; and that this map is an accurate representation thereof to the best of my knowledge and belief.

Date: _____

Thomas P.A. Jensen
Thomas P.A. Jensen R.L.S. 1084

DAMES & MOORE

Figure 7
Phase IV Subsurface Investigation
Soil Boring/Monitoring Well Location
George Williams College Educational Centers -
Lake Geneva Campus
North Lake Shore Drive
Williams Bay, Wisconsin

Jensen Surveying & Mapping S.C.

45 South Wisconsin Street P.O. Box 322
Elkhorn, Wisconsin. 53121

Telephone & Facsimile (414) 723-3434

Legend

Shown on Map

Mapping Date: May 15, 1995.

Revisions:

Sheet 1 of 1 Sheets

Job Reference No.

1995.035

Scale in feet: 1" =

Shown on Map

WWUP-11

11-1196