

FRANKS





"RECERTIFICATION"

Plat of Survey

Survey For: WOLTER BROS. BUILDERS
Location: 375 Frost Drive

FRFIS

Description: LOT 113 BAYWOOD HEIGHTS ADDITION NO. 2, being a subdivision of part of the N.W. 1/4 of Section 1, Town 1 North, Range 16 East, in the Village of Williams Bay, Walworth County, Wis.

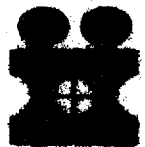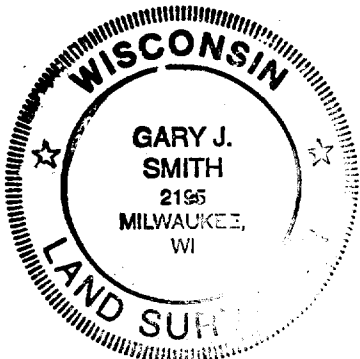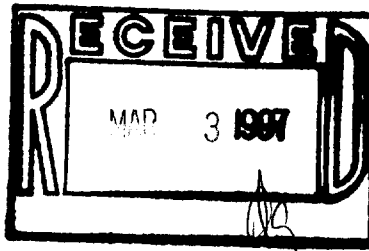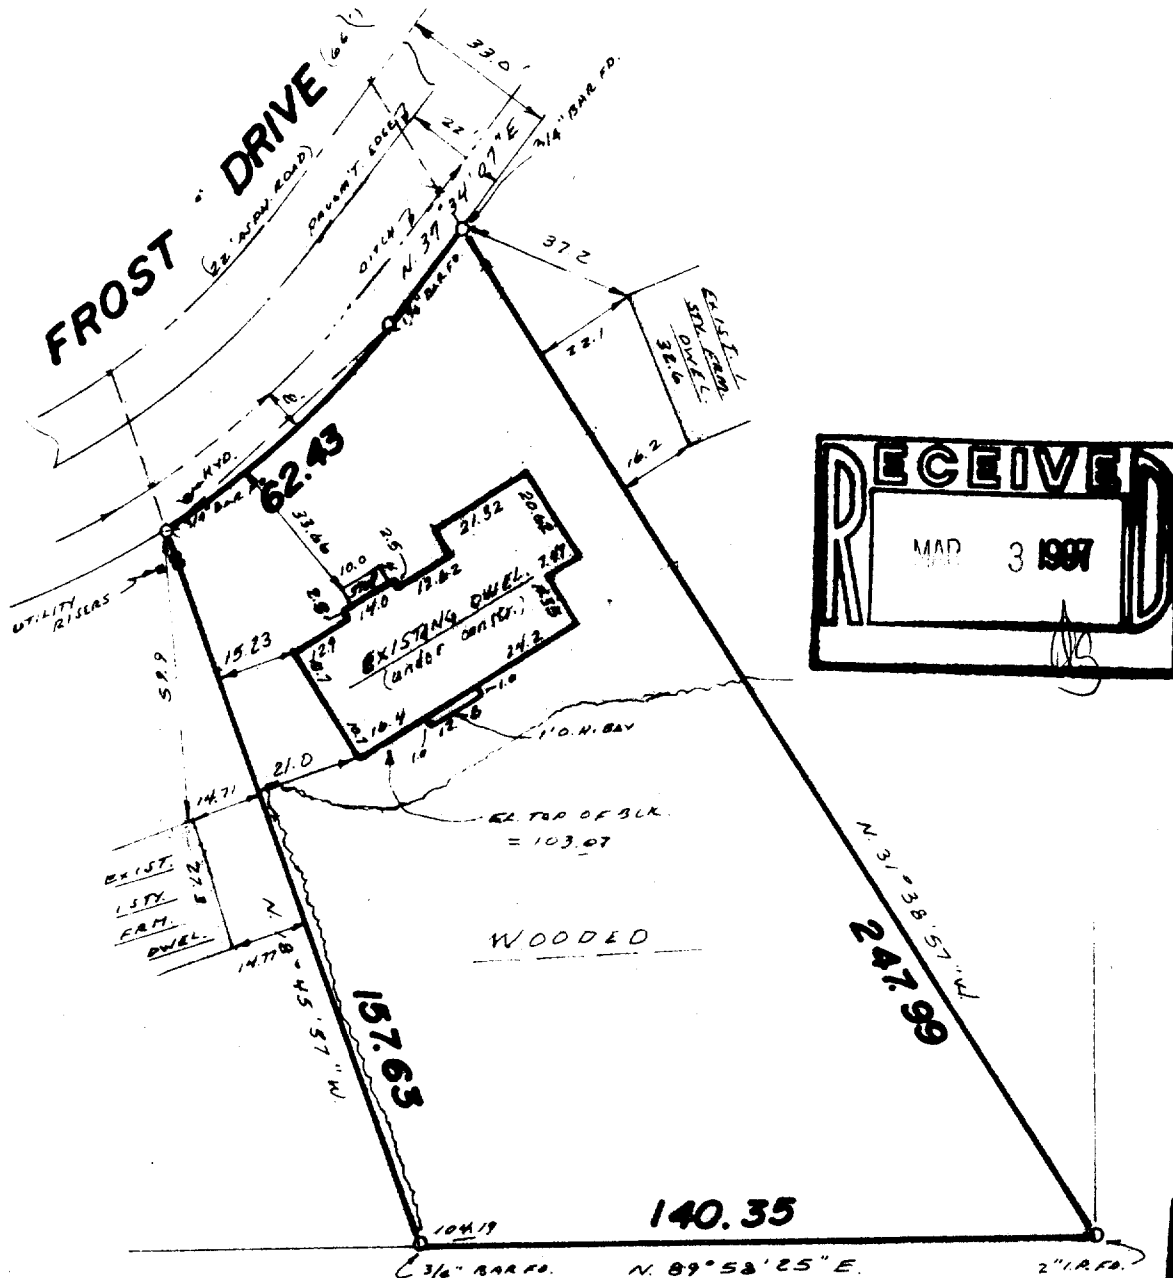

INTERLINE SURVEY
SERVICES, INC.
11221 W. FOREST HILLS AVE
MILWAUKEE, WISCONSIN 53230
PHONE 435-8000

SURVEY CERTIFICATE

CURVE DATA
R.A.O. = 183.00
C.H.P. = 62.13
B.E.G. = N 47°20'31" E

Scale: 1" = 40'

State of Wisconsin) ss
Milwaukee County

We, Interline Survey Services, Inc., certify that we have surveyed the above-described property and the above map is a true representation thereof, and shows the size and location of the property, its exterior boundaries, the location and dimensions of all visible structures thereon, fences, apparent easements and roadways and visible encroachments, if any.

This survey is made for the exclusive use of the present owners of the Property, and also those who purchase, mortgage, or guarantee the title thereto, within one (1) year from date hereof.

Gary J. Smith
Wisconsin Registered Land Surveyor

Date: 10/18/96
Job No.: 24979

WBW-2-64
11-1197