


BIRCH GROVE PARK

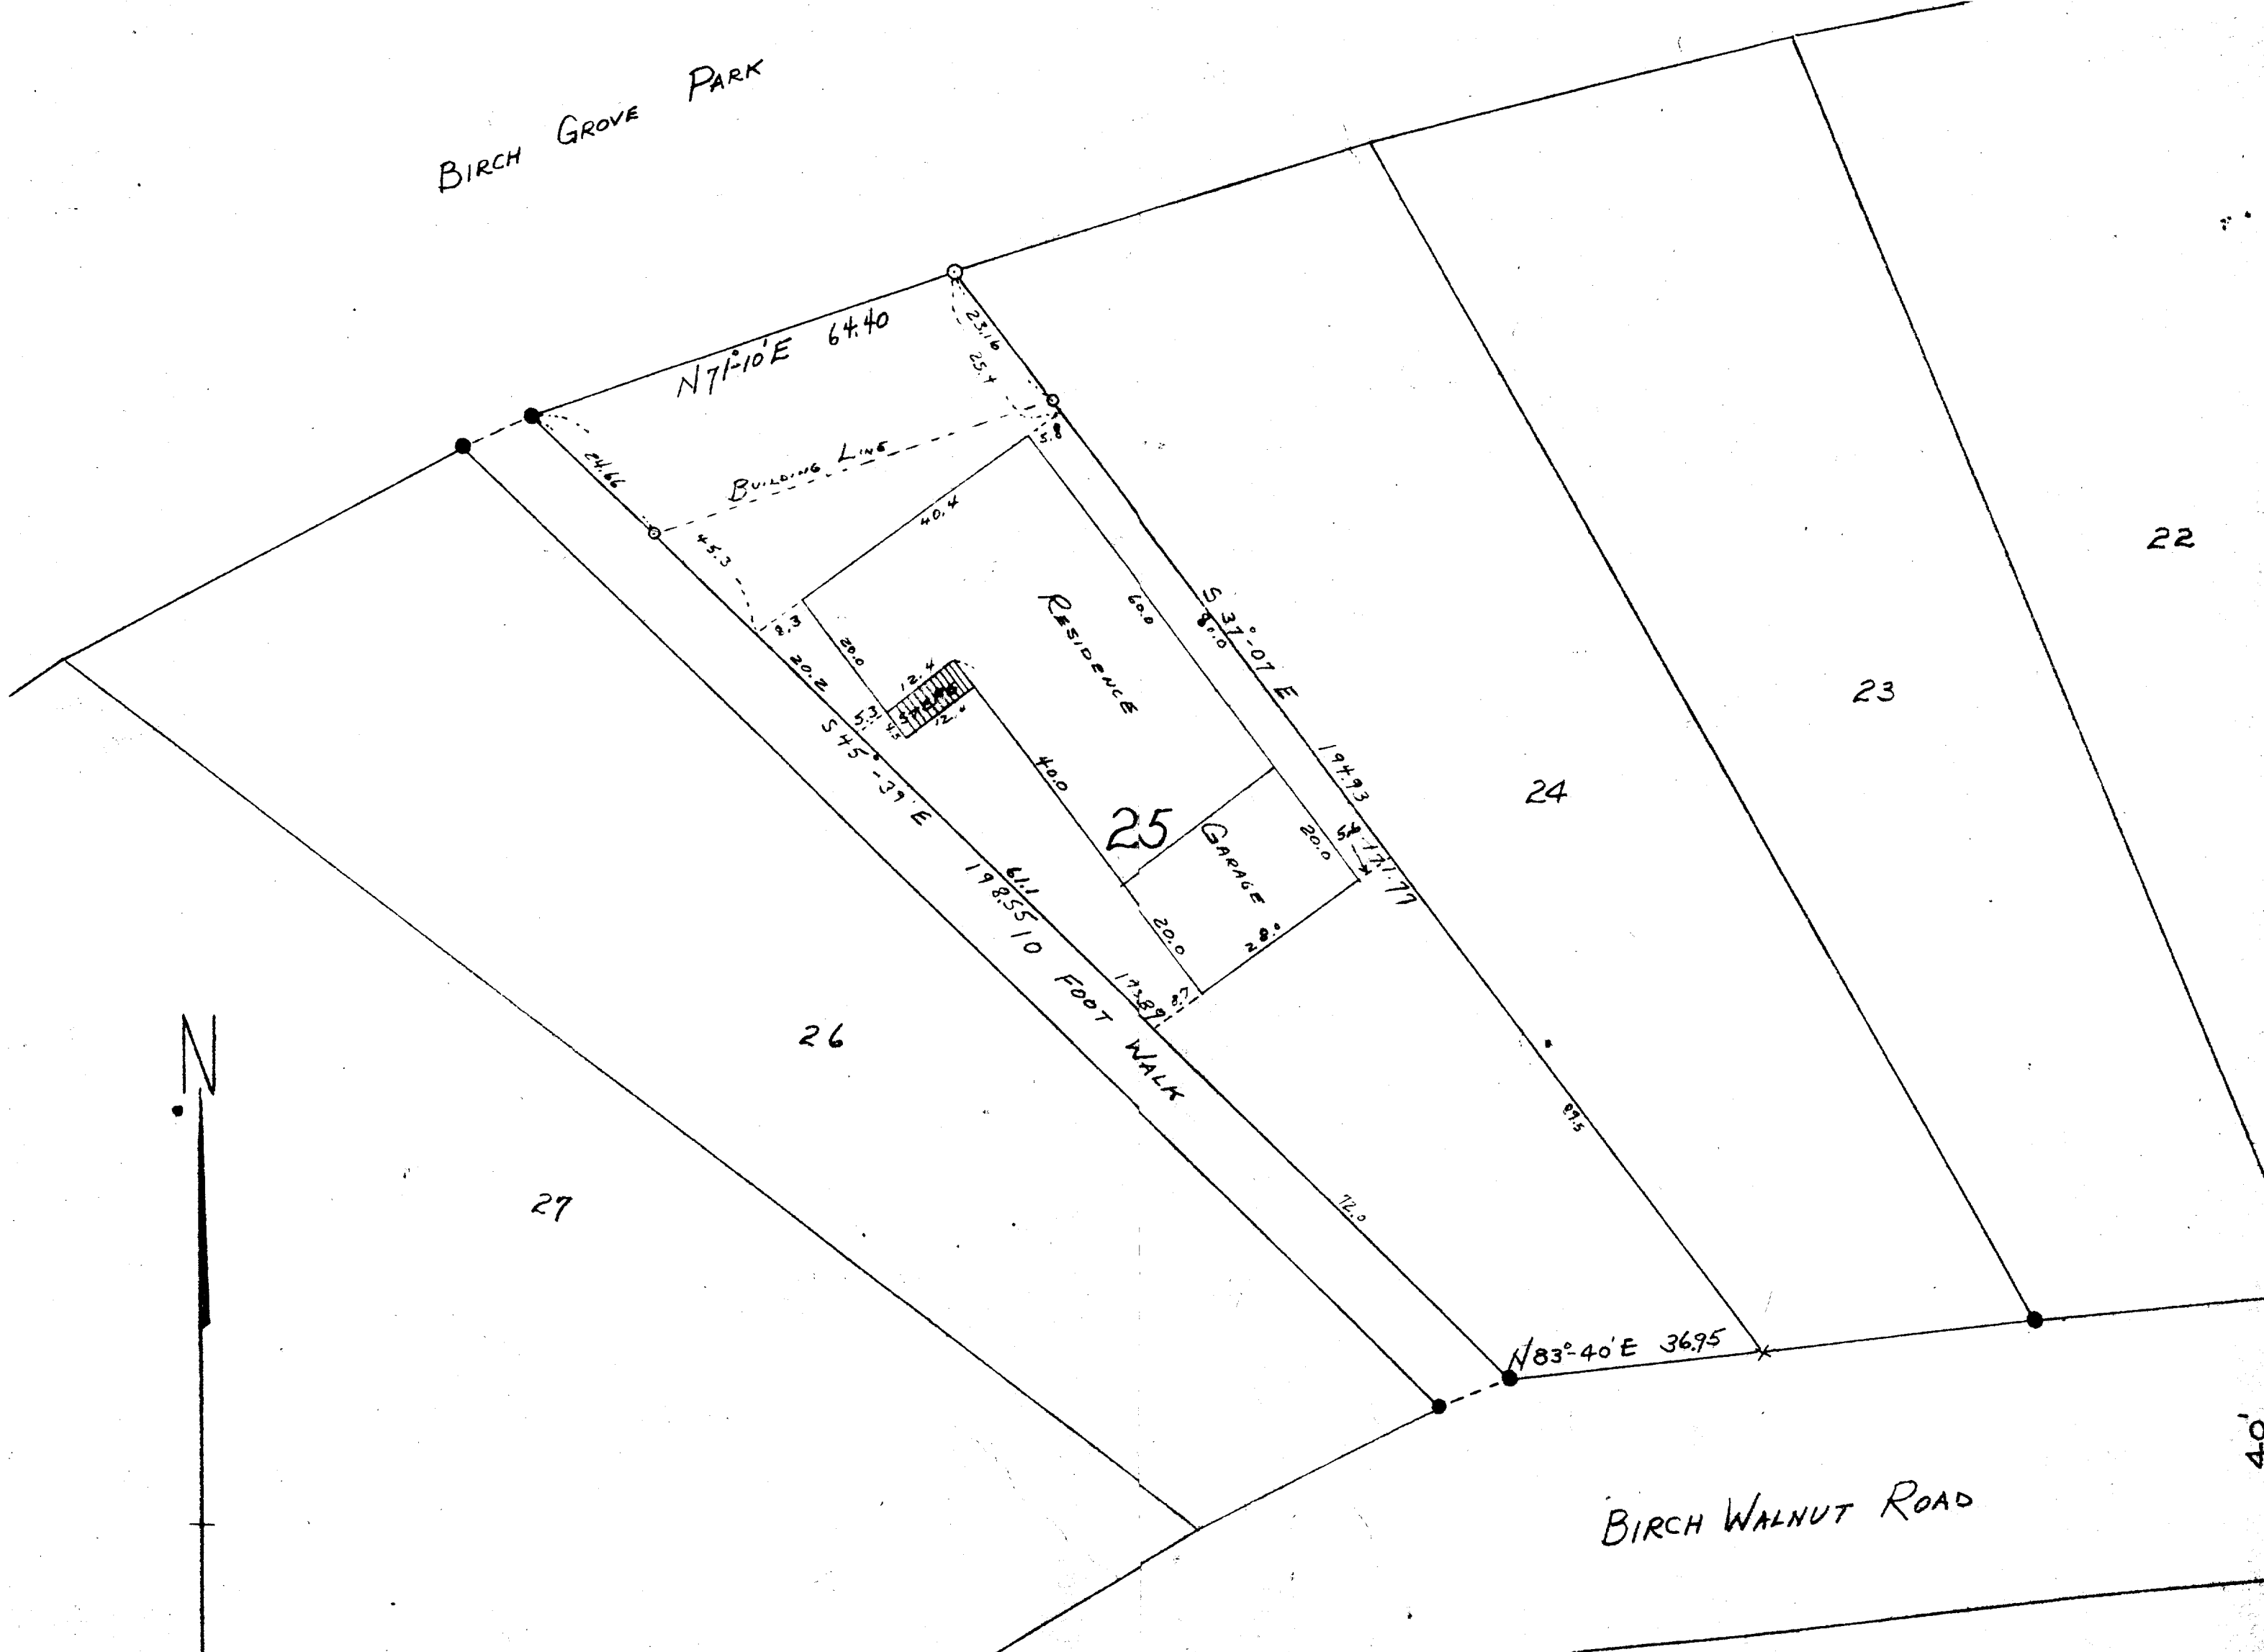

- X - SPIKE IN ROOT OF 20" BLACK OAK
- O - IRON PIPE
- - CONCRETE MONUMENT

STATE OF WISCONSIN }
COUNTY OF WALWORTH }
I, LLOYD L. JENSEN, DO HEREBY CERTIFY THAT I HAVE
SURVEYED THE PROPERTY DESCRIBED HEREON ACCORDING TO THE
OFFICIAL RECORDS AND THAT THE PLAT HEREON IS A CORRECT
REPRESENTATION OF THE LOT LINES AND PRINCIPAL
LINES OF BUILDINGS THEREON.
ELKHORN, WISCONSIN APRIL 7, 1956

PLAT OF SURVEY OF LOT 25

OF THE FIRST ADDITION TO
CEDAR POINT PARK
LOCATED IN THE
VILLAGE OF WILLIAMS BAY
WALWORTH COUNTY, WISCONSIN

Lloyd L. Jensen
Surveyor