


**WALWORTH COUNTY
SURVEYING & MAPPING**


P. O. BOX 1115
LAKE GENEVA, WISCONSIN
414-248-0505

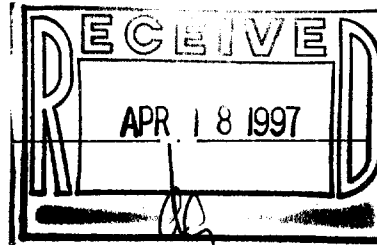

SUNSET BOULEVARD

THEATRE ROAD

FROST DRIVE

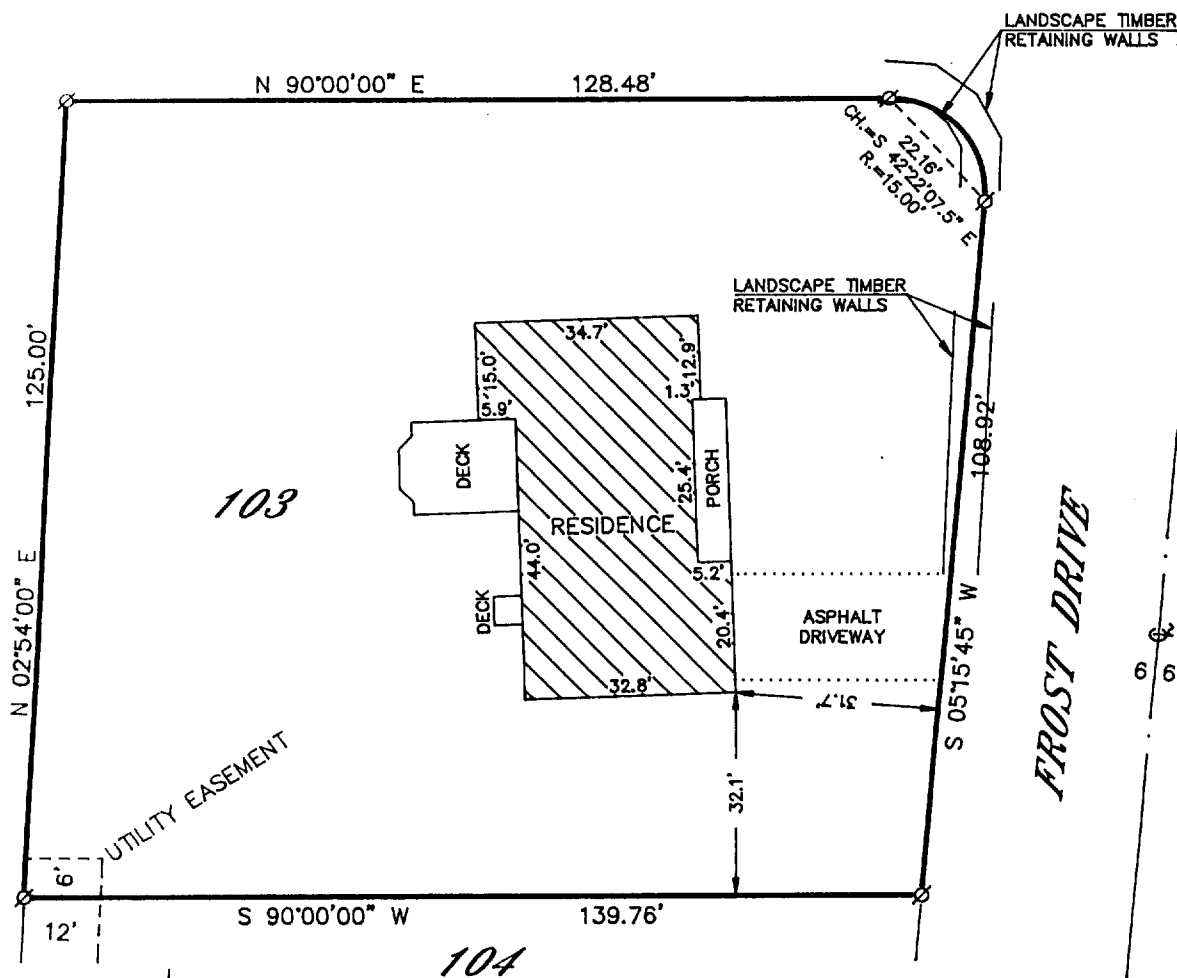

PLAT OF SURVEY OF

LOT 103 OF BAYWOOD HEIGHTS ADDITION NO. 2,
LOCATED IN THE NORTHWEST 1/4 OF SECTION
1, T 1 N, R 16 E, VILLAGE OF WILLIAMS BAY,
WALWORTH COUNTY, WISCONSIN.

ORDERED BY: COLDWELL BANKER
GENEVA LAKES AREA REALTORS
838 MAIN STREET
LAKE GENEVA, WISCONSIN
53147


I HEREBY CERTIFY THAT I HAVE SURVEYED THE ABOVE DESCRIBED
PROPERTY AND THAT THE ABOVE MAP IS A TRUE REPRESENTATION
THEREOF AND SHOWS THE SIZE AND LOCATION OF THE PROPERTY,
ITS EXTERIOR BOUNDARIES, THE LOCATION OF ALL VISIBLE STRUCTURES
AND DIMENSIONS OF ALL PRINCIPAL BUILDINGS THEREON, BOUNDARY
FENCES, APPARENT EASEMENTS, ROADWAYS AND VISIBLE ENCROACH-
MENTS, IF ANY, TO THE BEST OF MY KNOWLEDGE AND BELIEF.

THIS SURVEY IS MADE FOR THE USE OF THE PRESENT OWNERS OF
THE PROPERTY AND ALSO THOSE WHO PURCHASE, MORTGAGE OR
GUARANTEE THE TITLE THERETO WITHIN ONE (1) YEAR FROM DATE
HEREOF.

Robert M. Baerenwald
ROBERT M. BAERENWALD
WISCONSIN REGISTERED LAND SURVEYOR, S-1508

Dec. 18, 1996
DATE ROB NO. 5306

NOTE: THIS IS NOT A CERTIFIED COPY UNLESS SEALED.

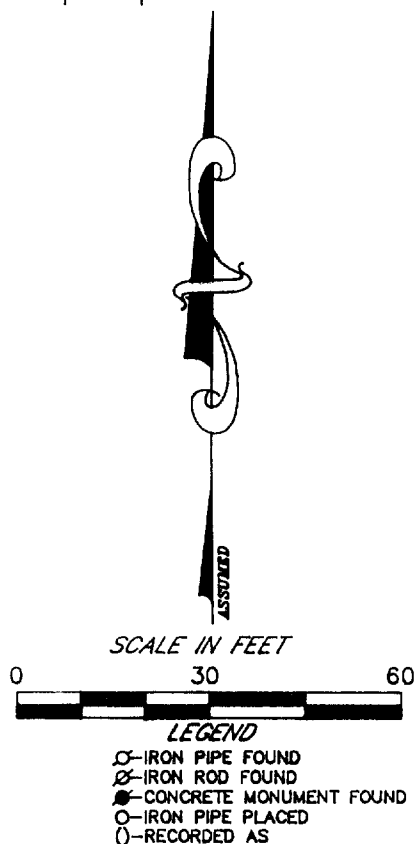

WBW2-54
011-1218