


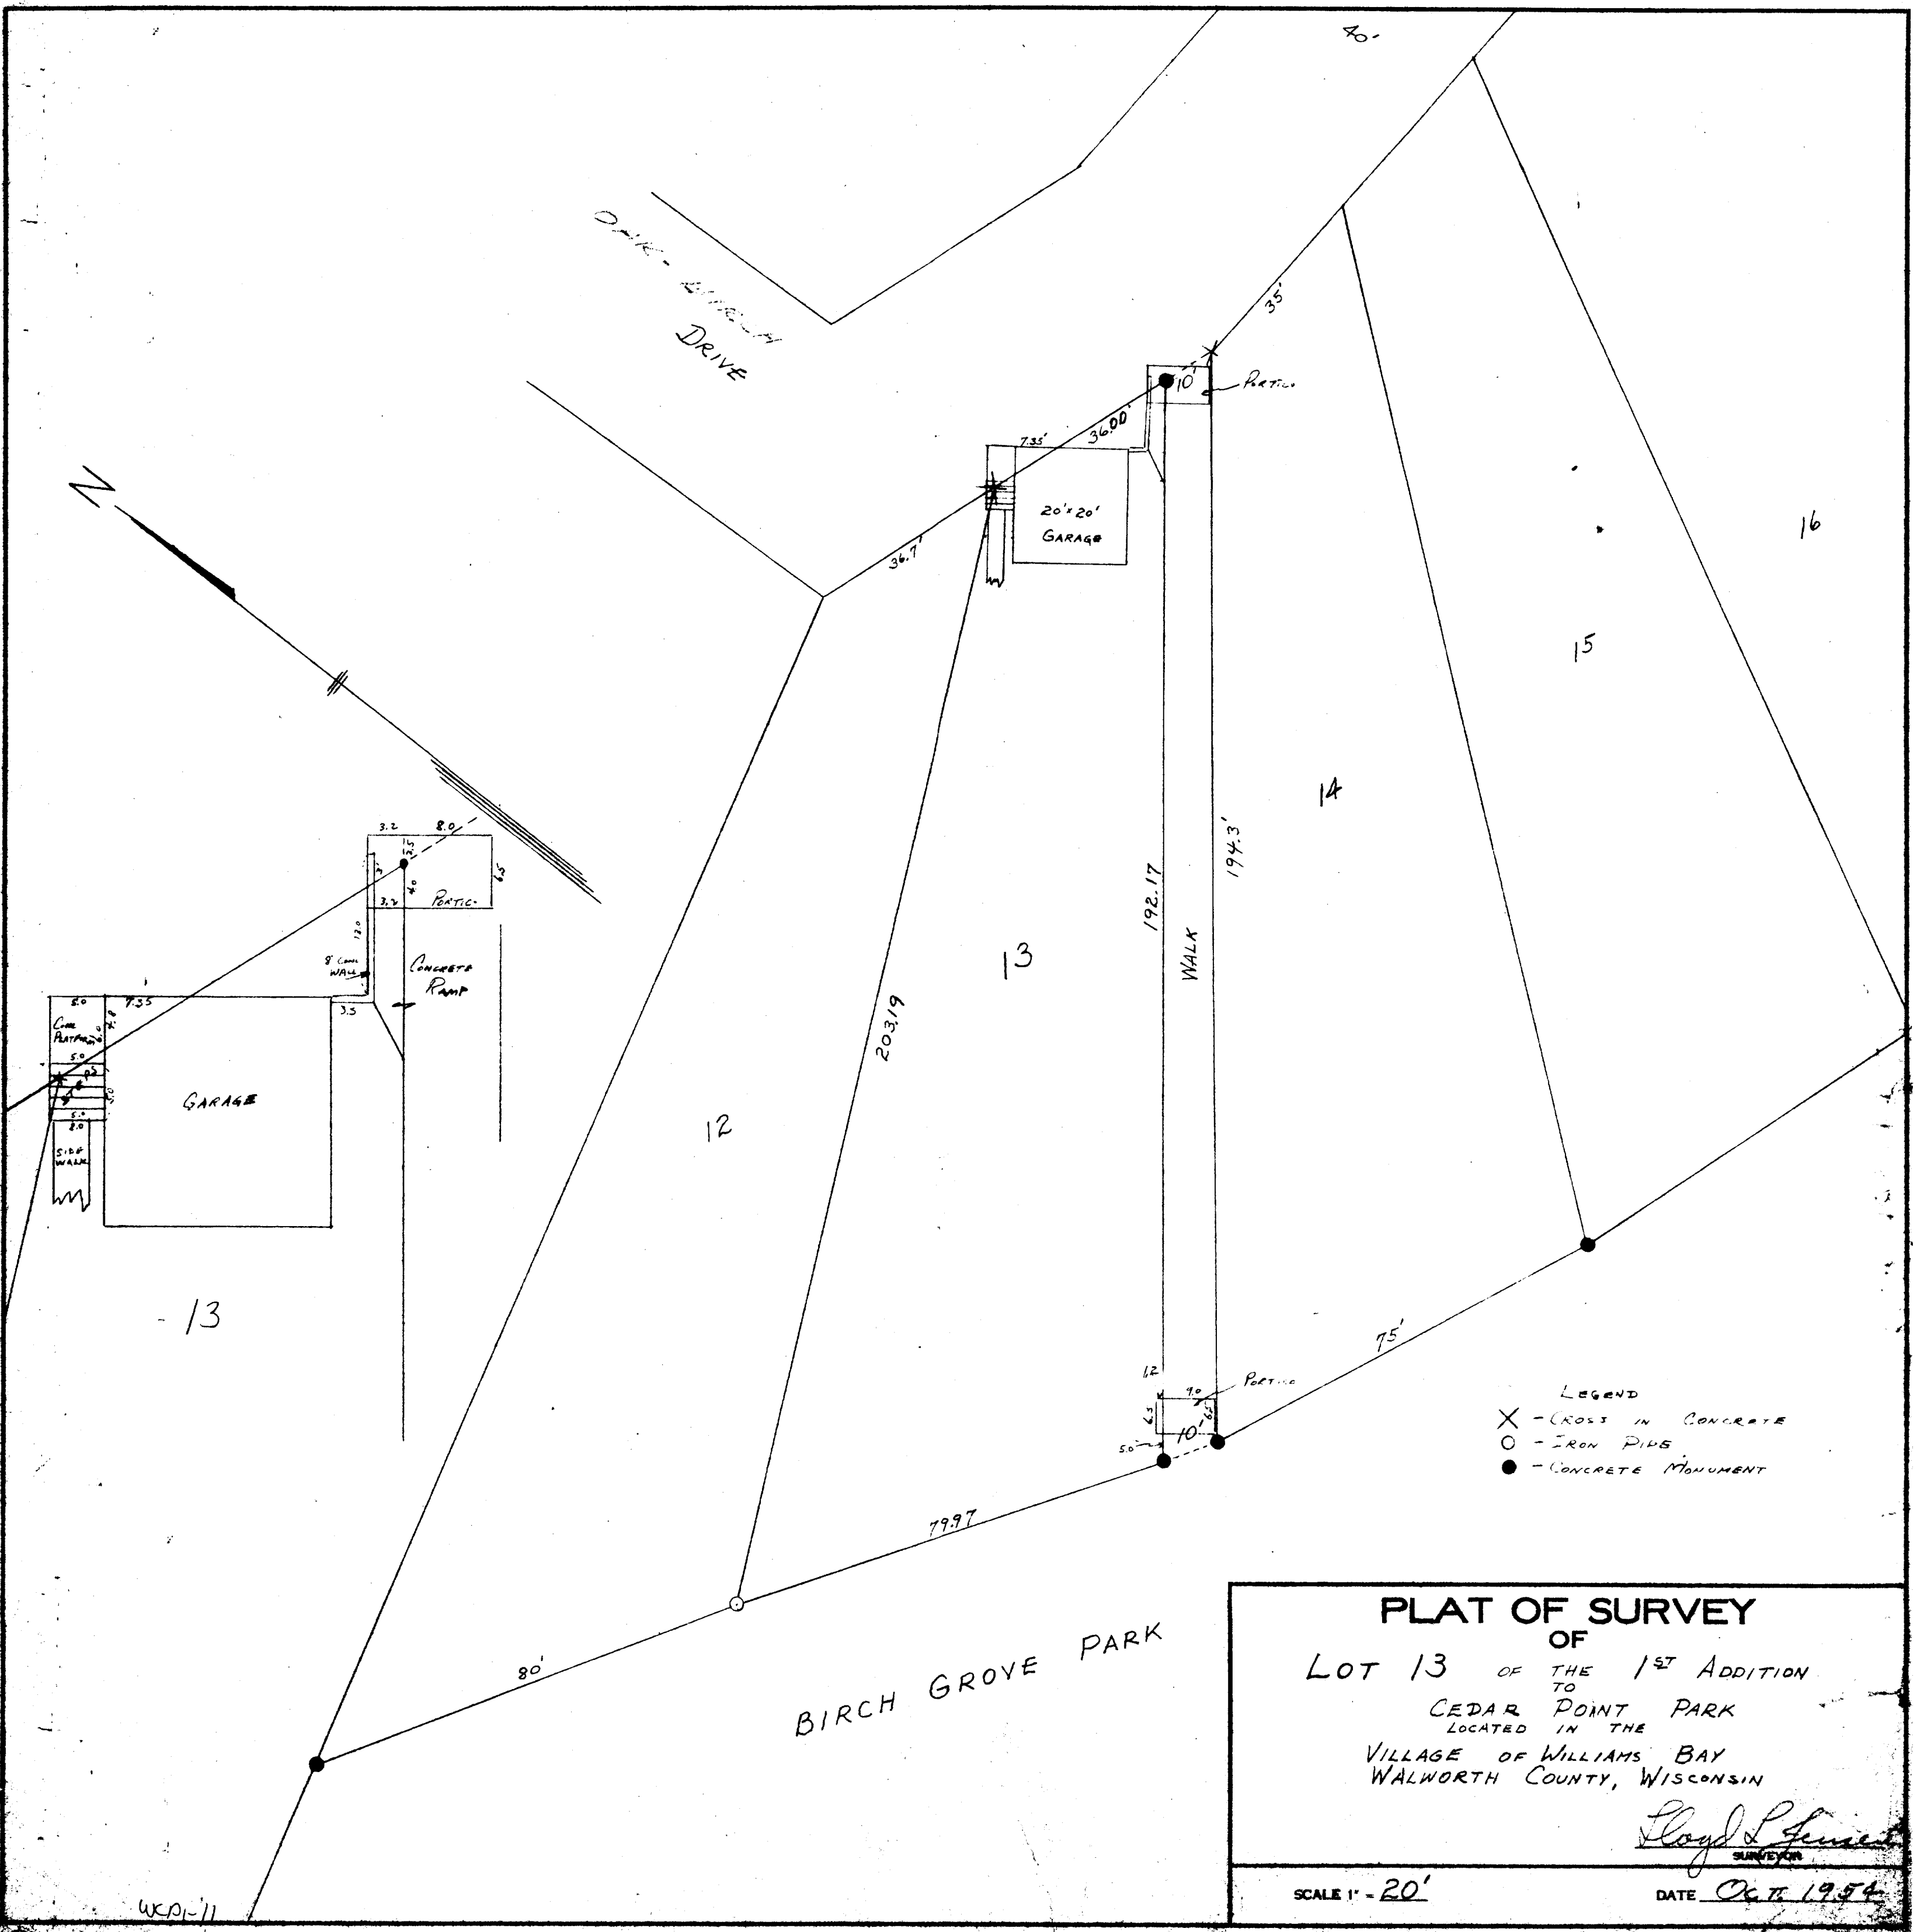

LEGEND
X - CROSS IN CONCRETE
O - IRON PINS
• - CONCRETE MONUMENT

PLAT OF SURVEY
OF
LOT 13 OF THE 1ST ADDITION
TO
CEDAR POINT PARK
LOCATED IN THE
VILLAGE OF WILLIAMS BAY
WALWORTH COUNTY, WISCONSIN

Lloyd L. Jensen
SURVEYOR

SCALE 1" = 20'

DATE Oct. 1954

11-121