


40' HIGHLAND ROAD

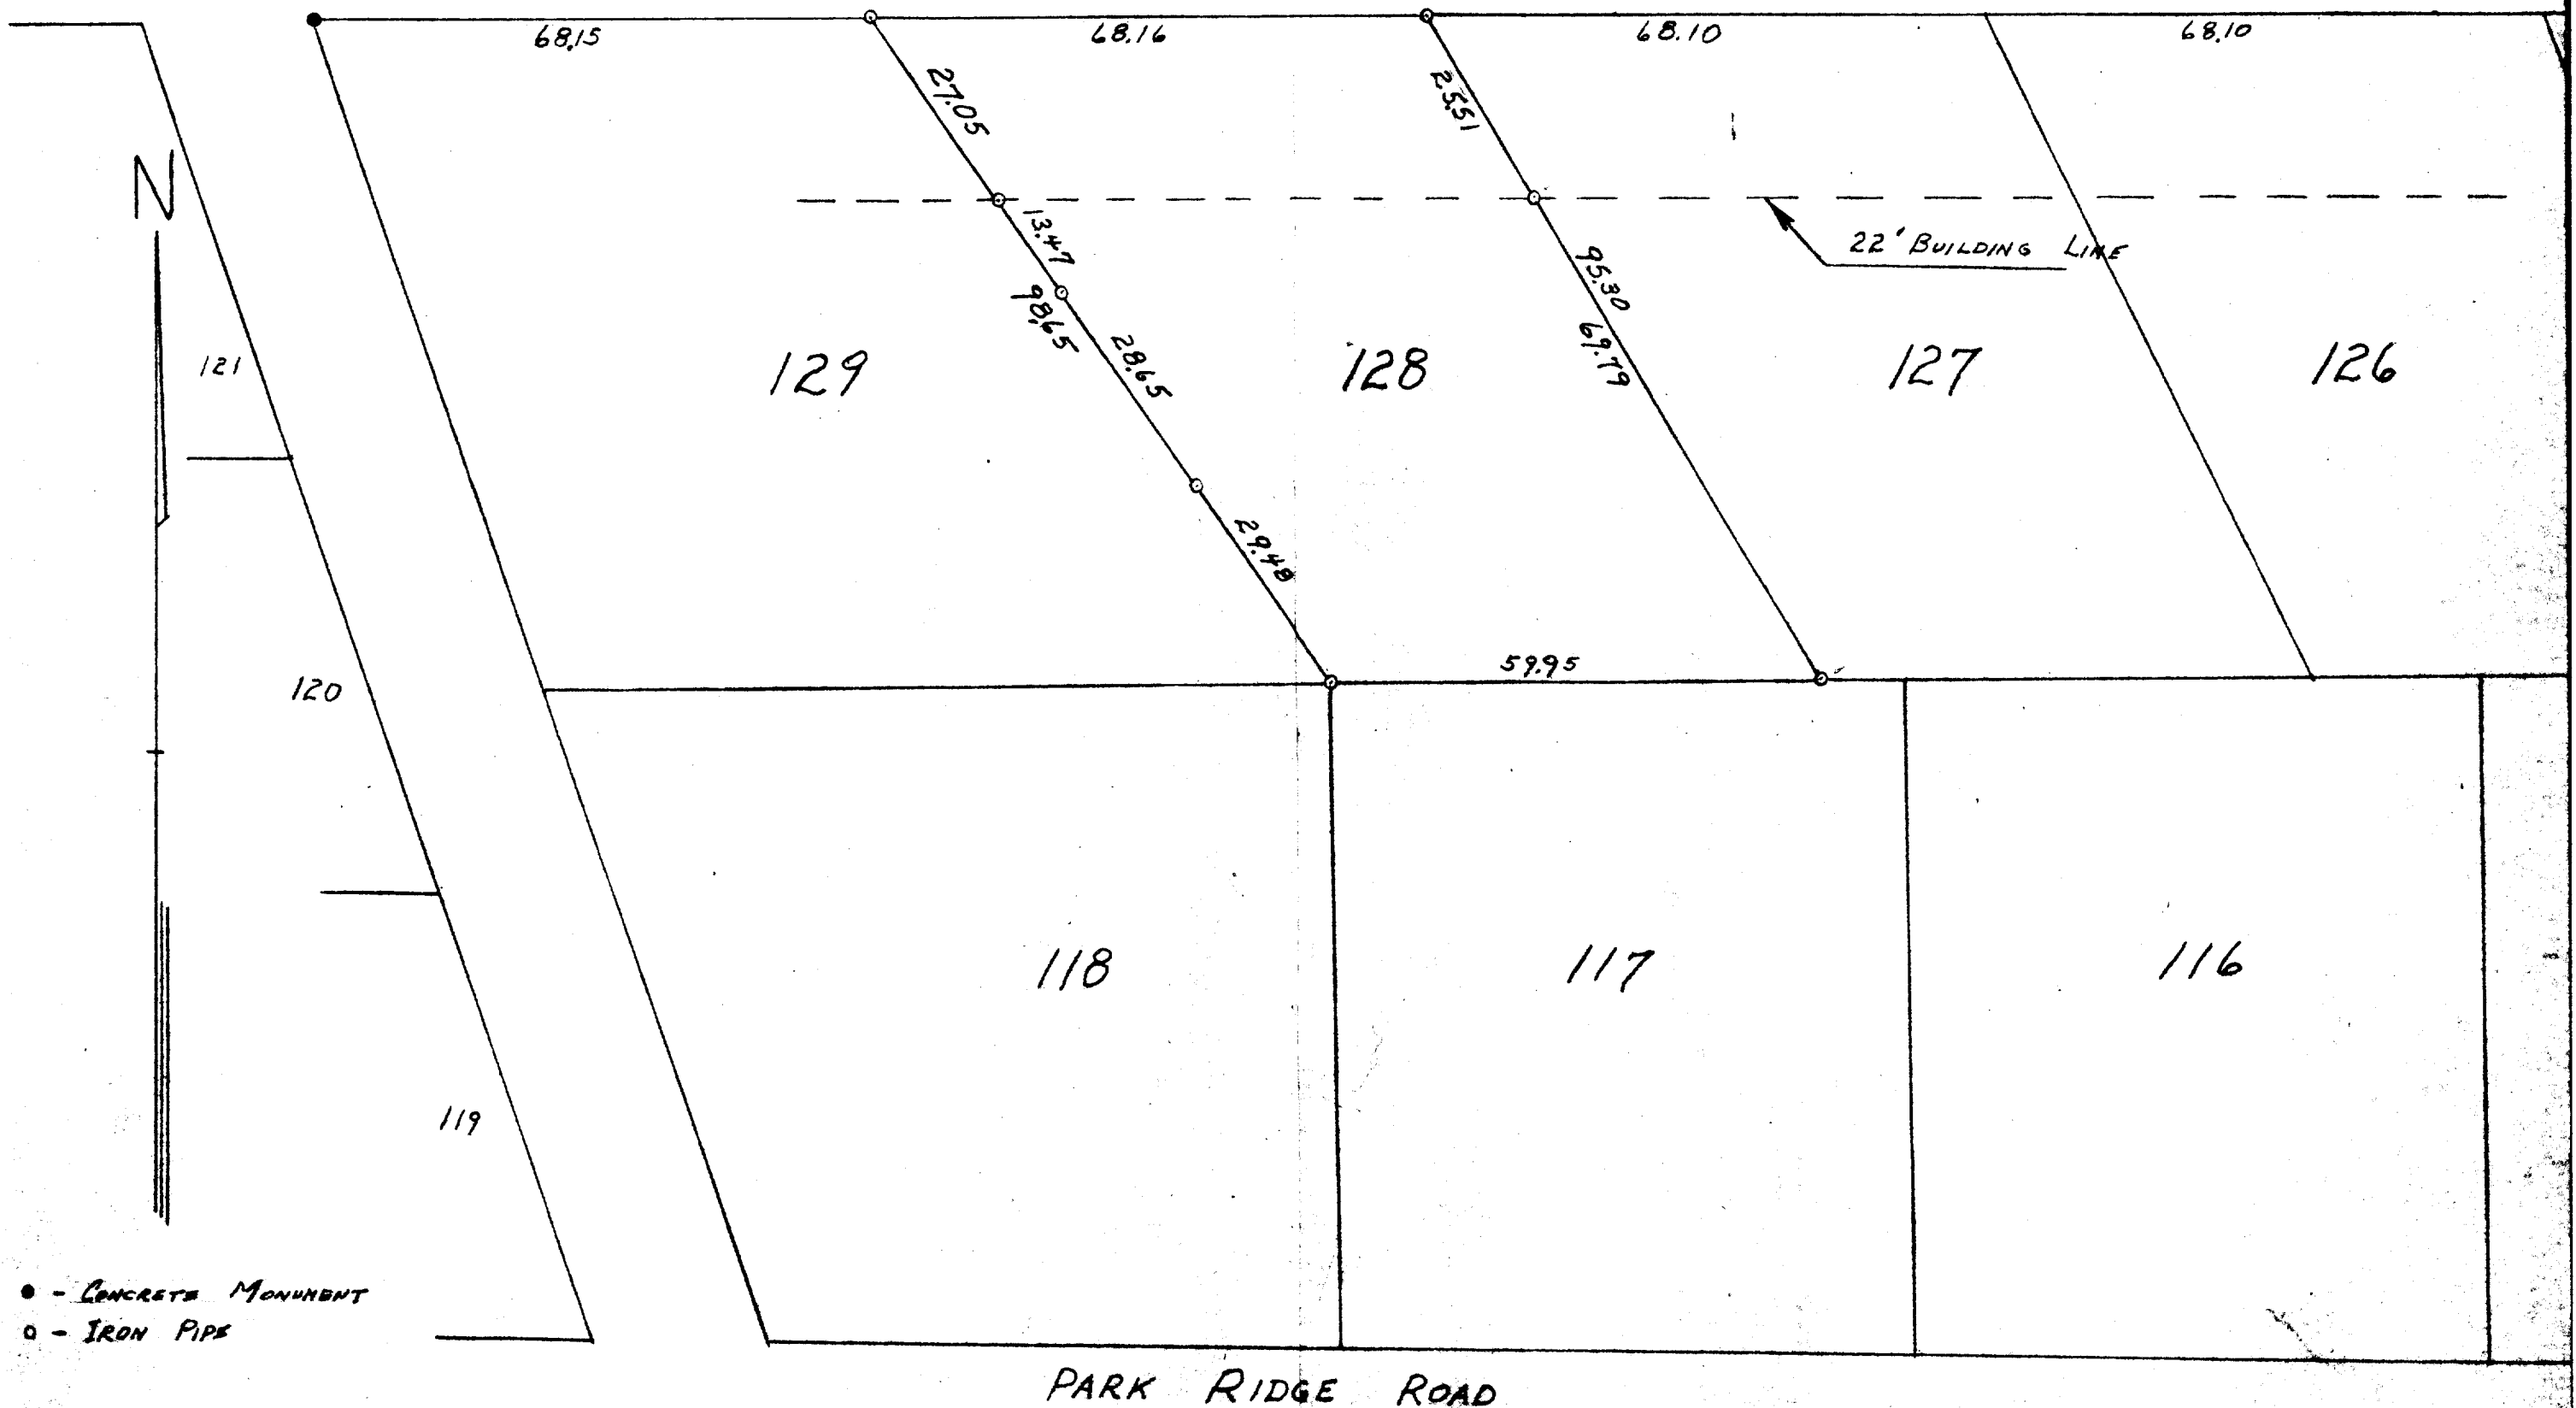

PLAT OF SURVEY
OF

LOT 128

2ND ADDITION OF CEDAR POINT PARK
LOCATED IN THE VILLAGE OF WILLIAMS BAY
WALNORTH COUNTY, WISCONSIN

Roy L. Linsen
SURVEYOR

SCALE 1" = 20'

DATE SEPT. 1954