

FARRIS, HANSEN & ASSOCIATES, INC.

7 RIDGEWAY COURT, P.O. BOX 437
ELKHORN, WISCONSIN 53121

PLAT OF SURVEY



PHONE: (414) 723-2088
FAX: (414) 723-5888

LOCATION: LOTS 16 & 17 BLOCK 6
OF THE ORIGINAL PLAT OF WILLIAMS BAY
WALWORTH COUNTY, WISCONSIN

WORK ORDERED BY: ADOLPH HUEBSCHER
42 SPRING ST. - BOX 715
WILLIAMS BAY, WI.


MAP LEGEND

- = IRON PIPE STAKE FOUND
- = IRON PIPE STAKE SET
- = IRON ROD STAKE FOUND
- = IRON ROD STAKE SET
- = CONCRETE MONUMENT FOUND
- = RECORD DIMENSION

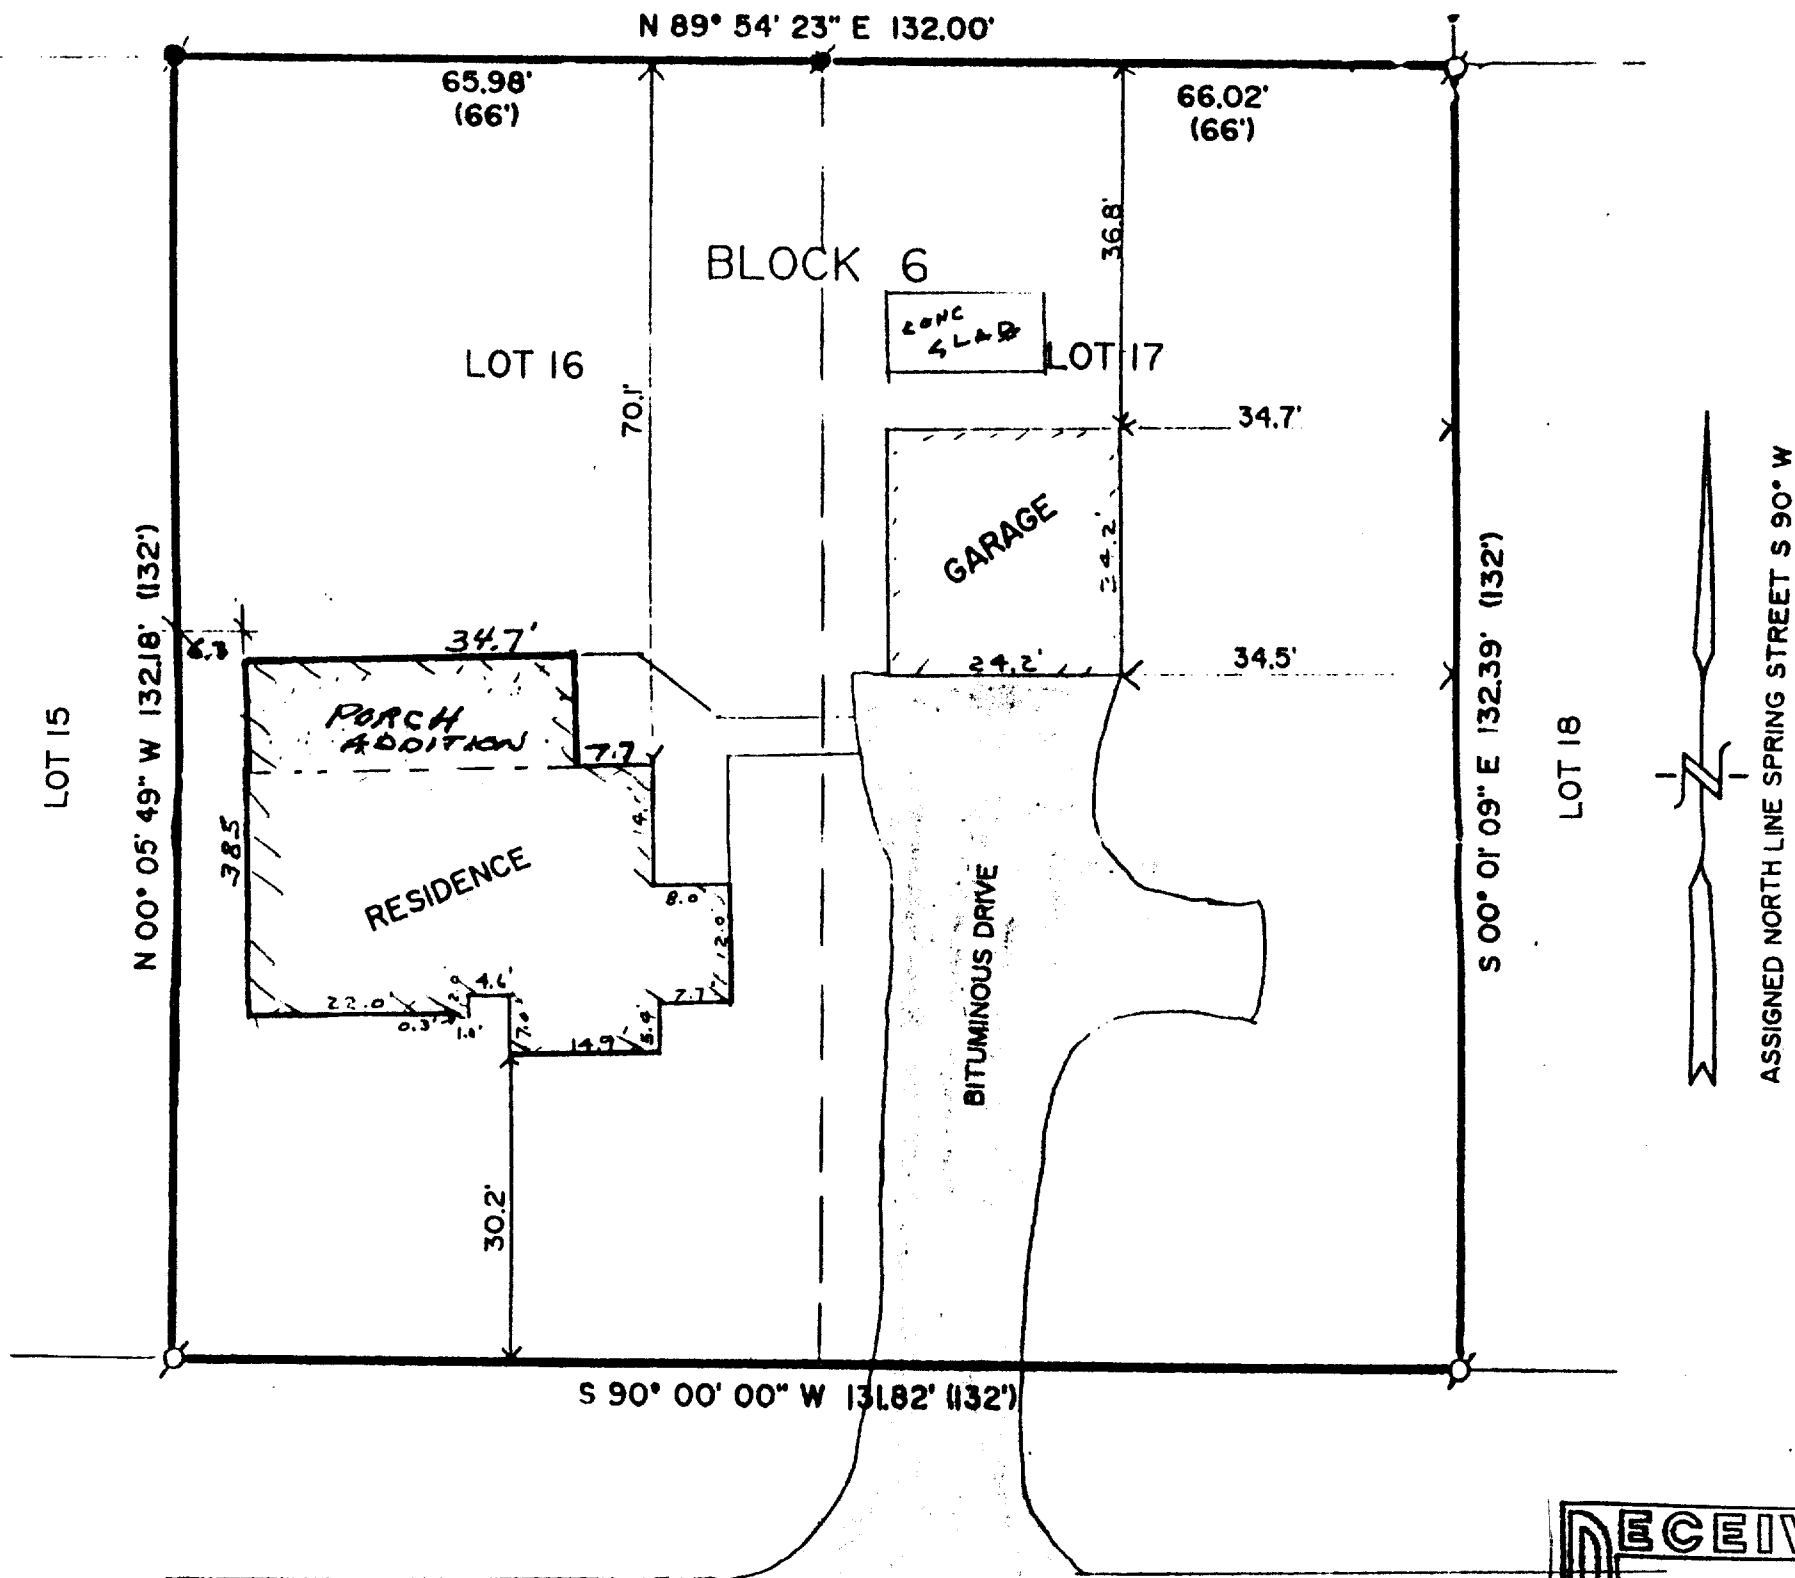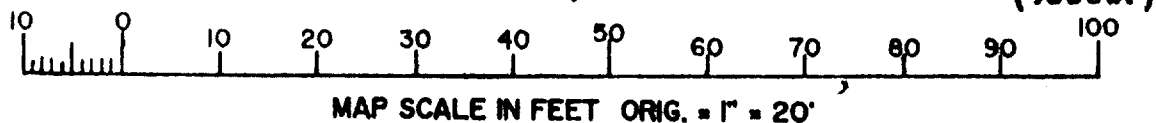

SPRING STREET

27' WIDE BITUMINOUS PAVEMENT
66' WIDE RECORDED RIGHT OF WAY

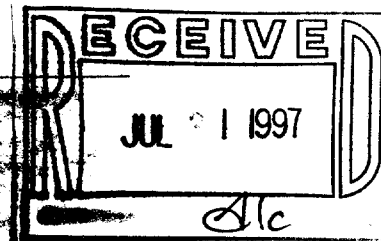

NOTE: COPIES OF THIS MAP TO WHICH THE FOLLOWING CERTIFICATE WILL APPLY ARE BLUE LINE PRINTS SHOWING SURVEYOR'S ORIGINAL SEAL AND SIGNATURE IN BLACK INK. COPIES BY ANY OTHER MEANS MAY HAVE ALTERATIONS WHICH DO NOT REPRESENT THE SURVEYOR'S WORK PRODUCT.

I HEREBY CERTIFY THAT THIS PLAT OF SURVEY IS A TRUE AND ACCURATE REPRESENTATION OF THE BOUNDARY LINES OF THE SUBJECT PARCEL TO THE BEST OF MY KNOWLEDGE AND BELIEF. THIS SURVEY IS MADE FOR THE USE OF THE PRESENT OWNERS OF THE PROPERTY, AND ALSO THOSE WHO PURCHASE, MORTGAGE, OR GUARANTEE THE TITLE THERETO WITHIN ONE YEAR FROM THE DATE HEREOF.



DATED: 7-2-97

Peter S. Gordon
PETER S. GORDON SLS 2101

WOP-83
WOP-84
011-1253

PROJECT NO. 3811