


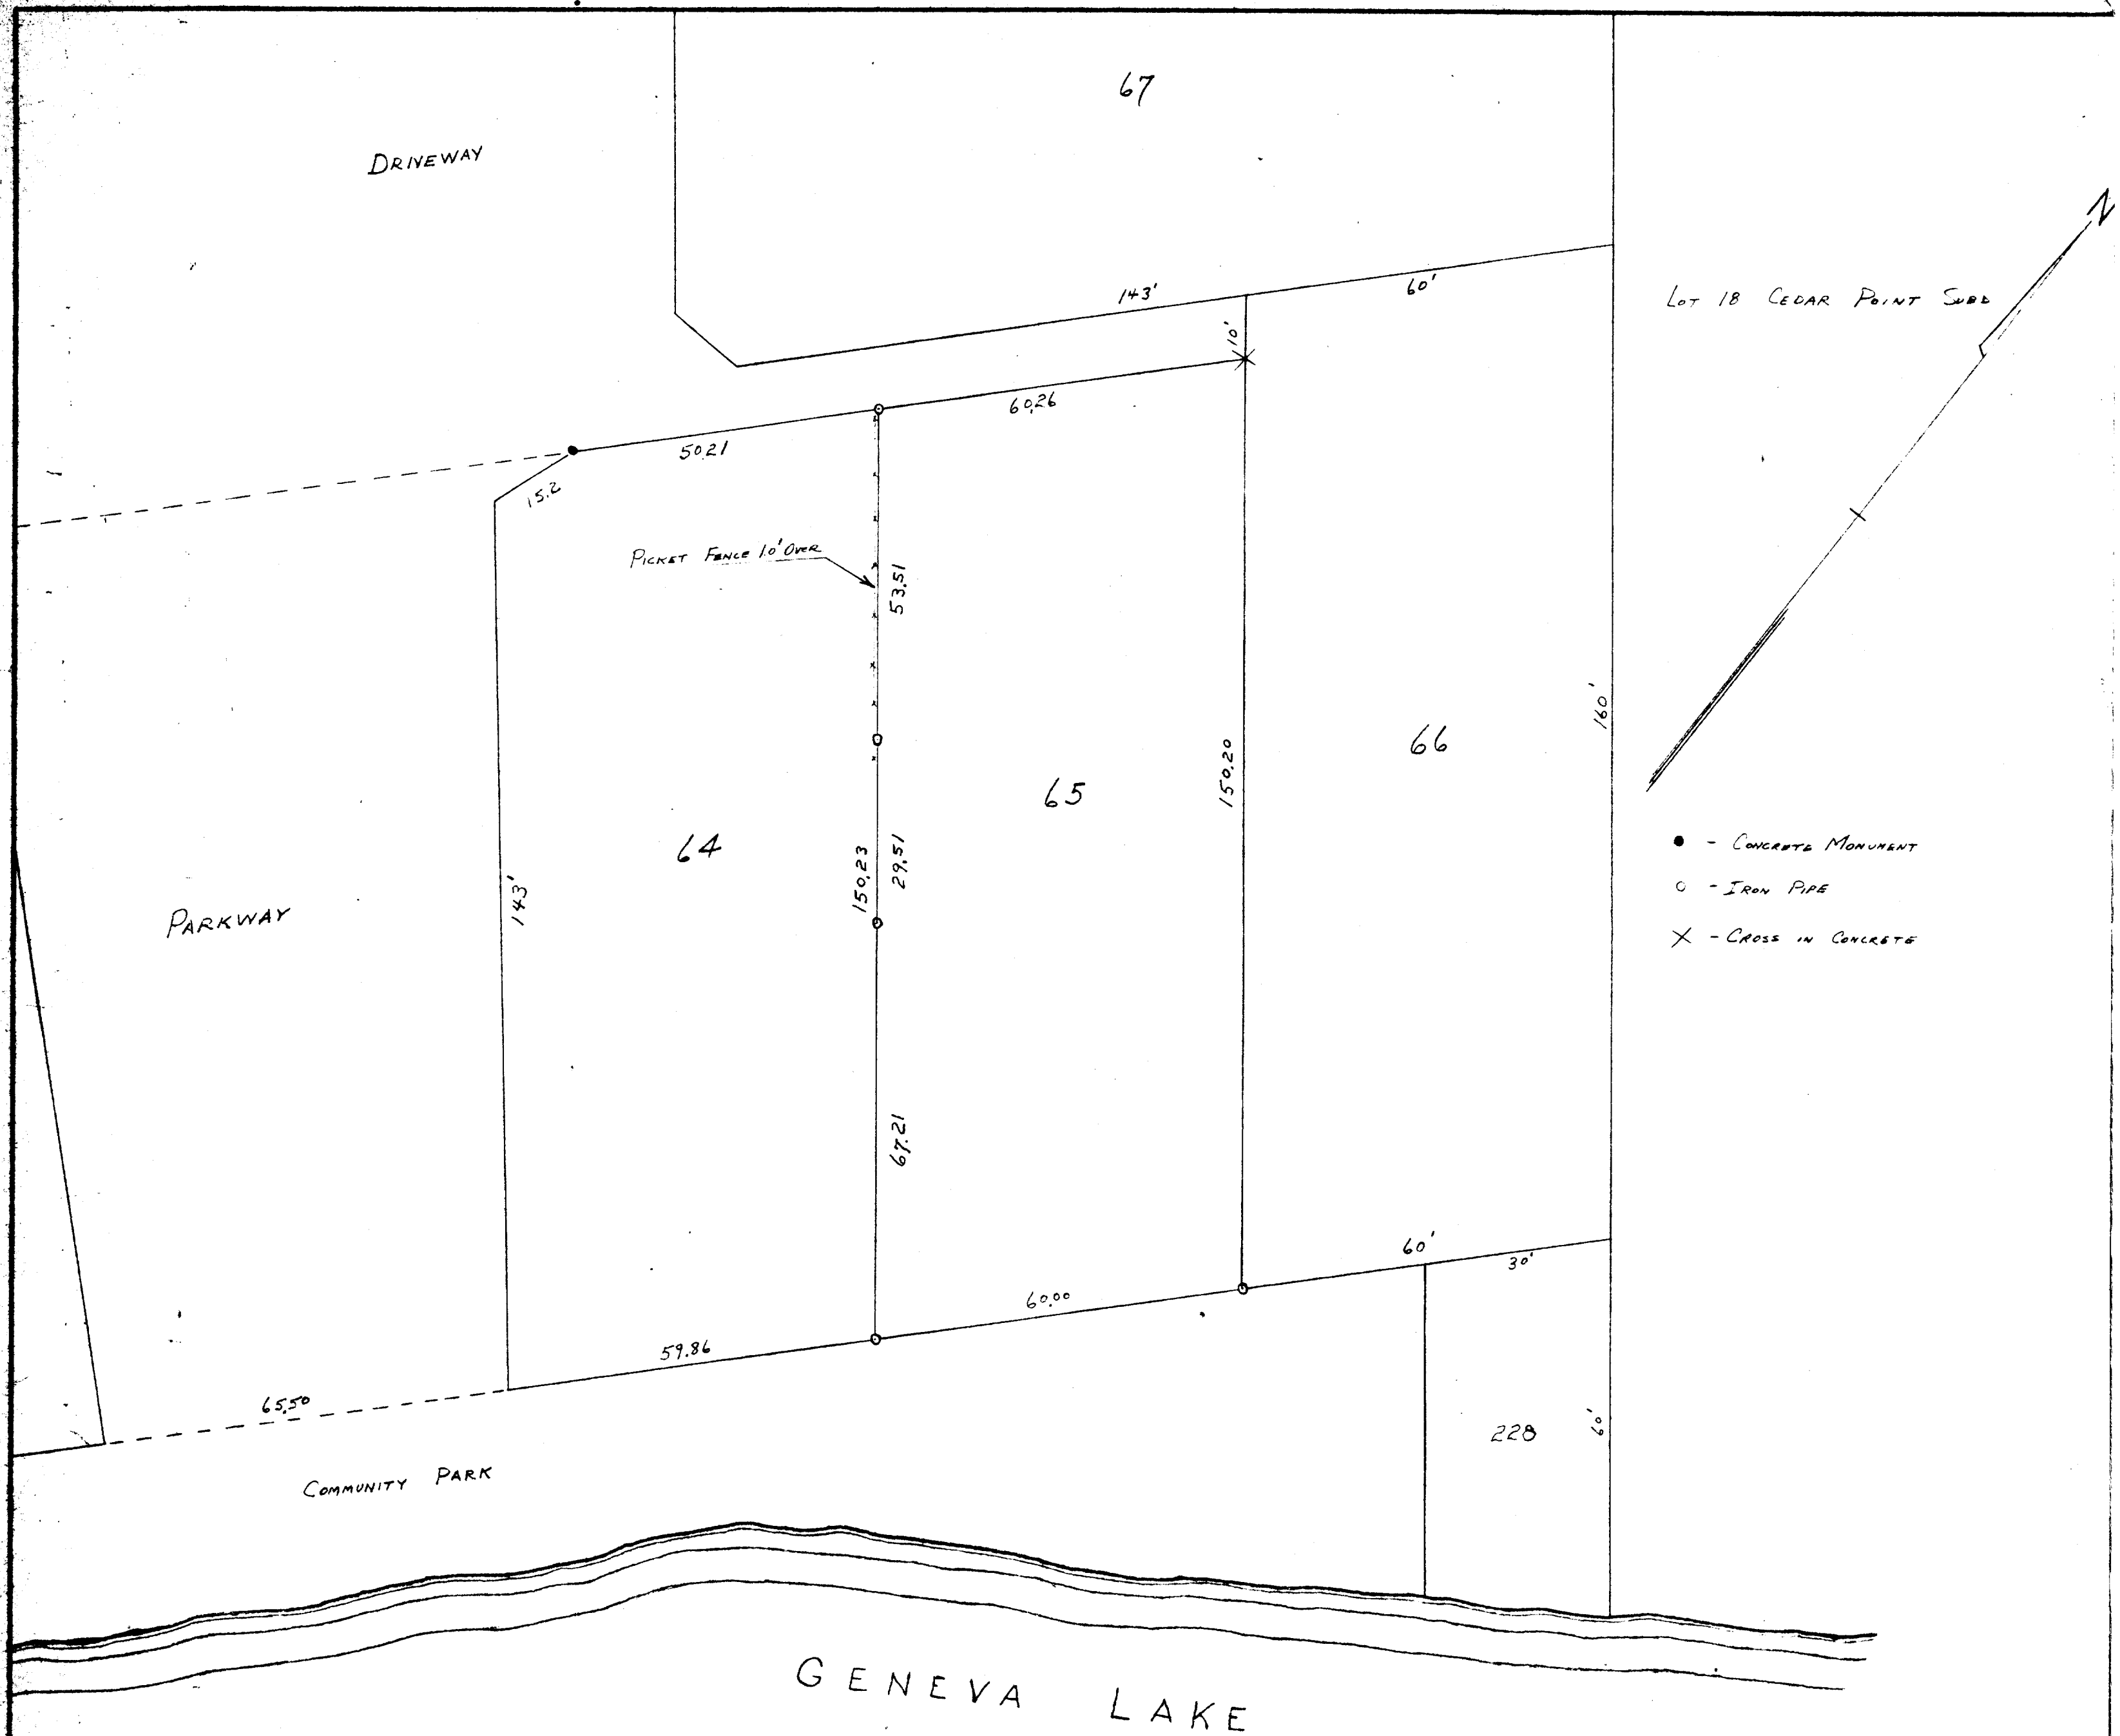

**PLAT OF SURVEY
OF**

LOT 65 OF THE ORIGINAL PLAT OF
CEDAR POINT PARK
LOCATED IN THE
VILLAGE OF WILLIAMS BAY,
WALWORTH COUNTY, WISCONSIN

Lloyd J. Jensen
SURVEYOR

SCALE 1" = 20'

DATE SEPT. 1954