


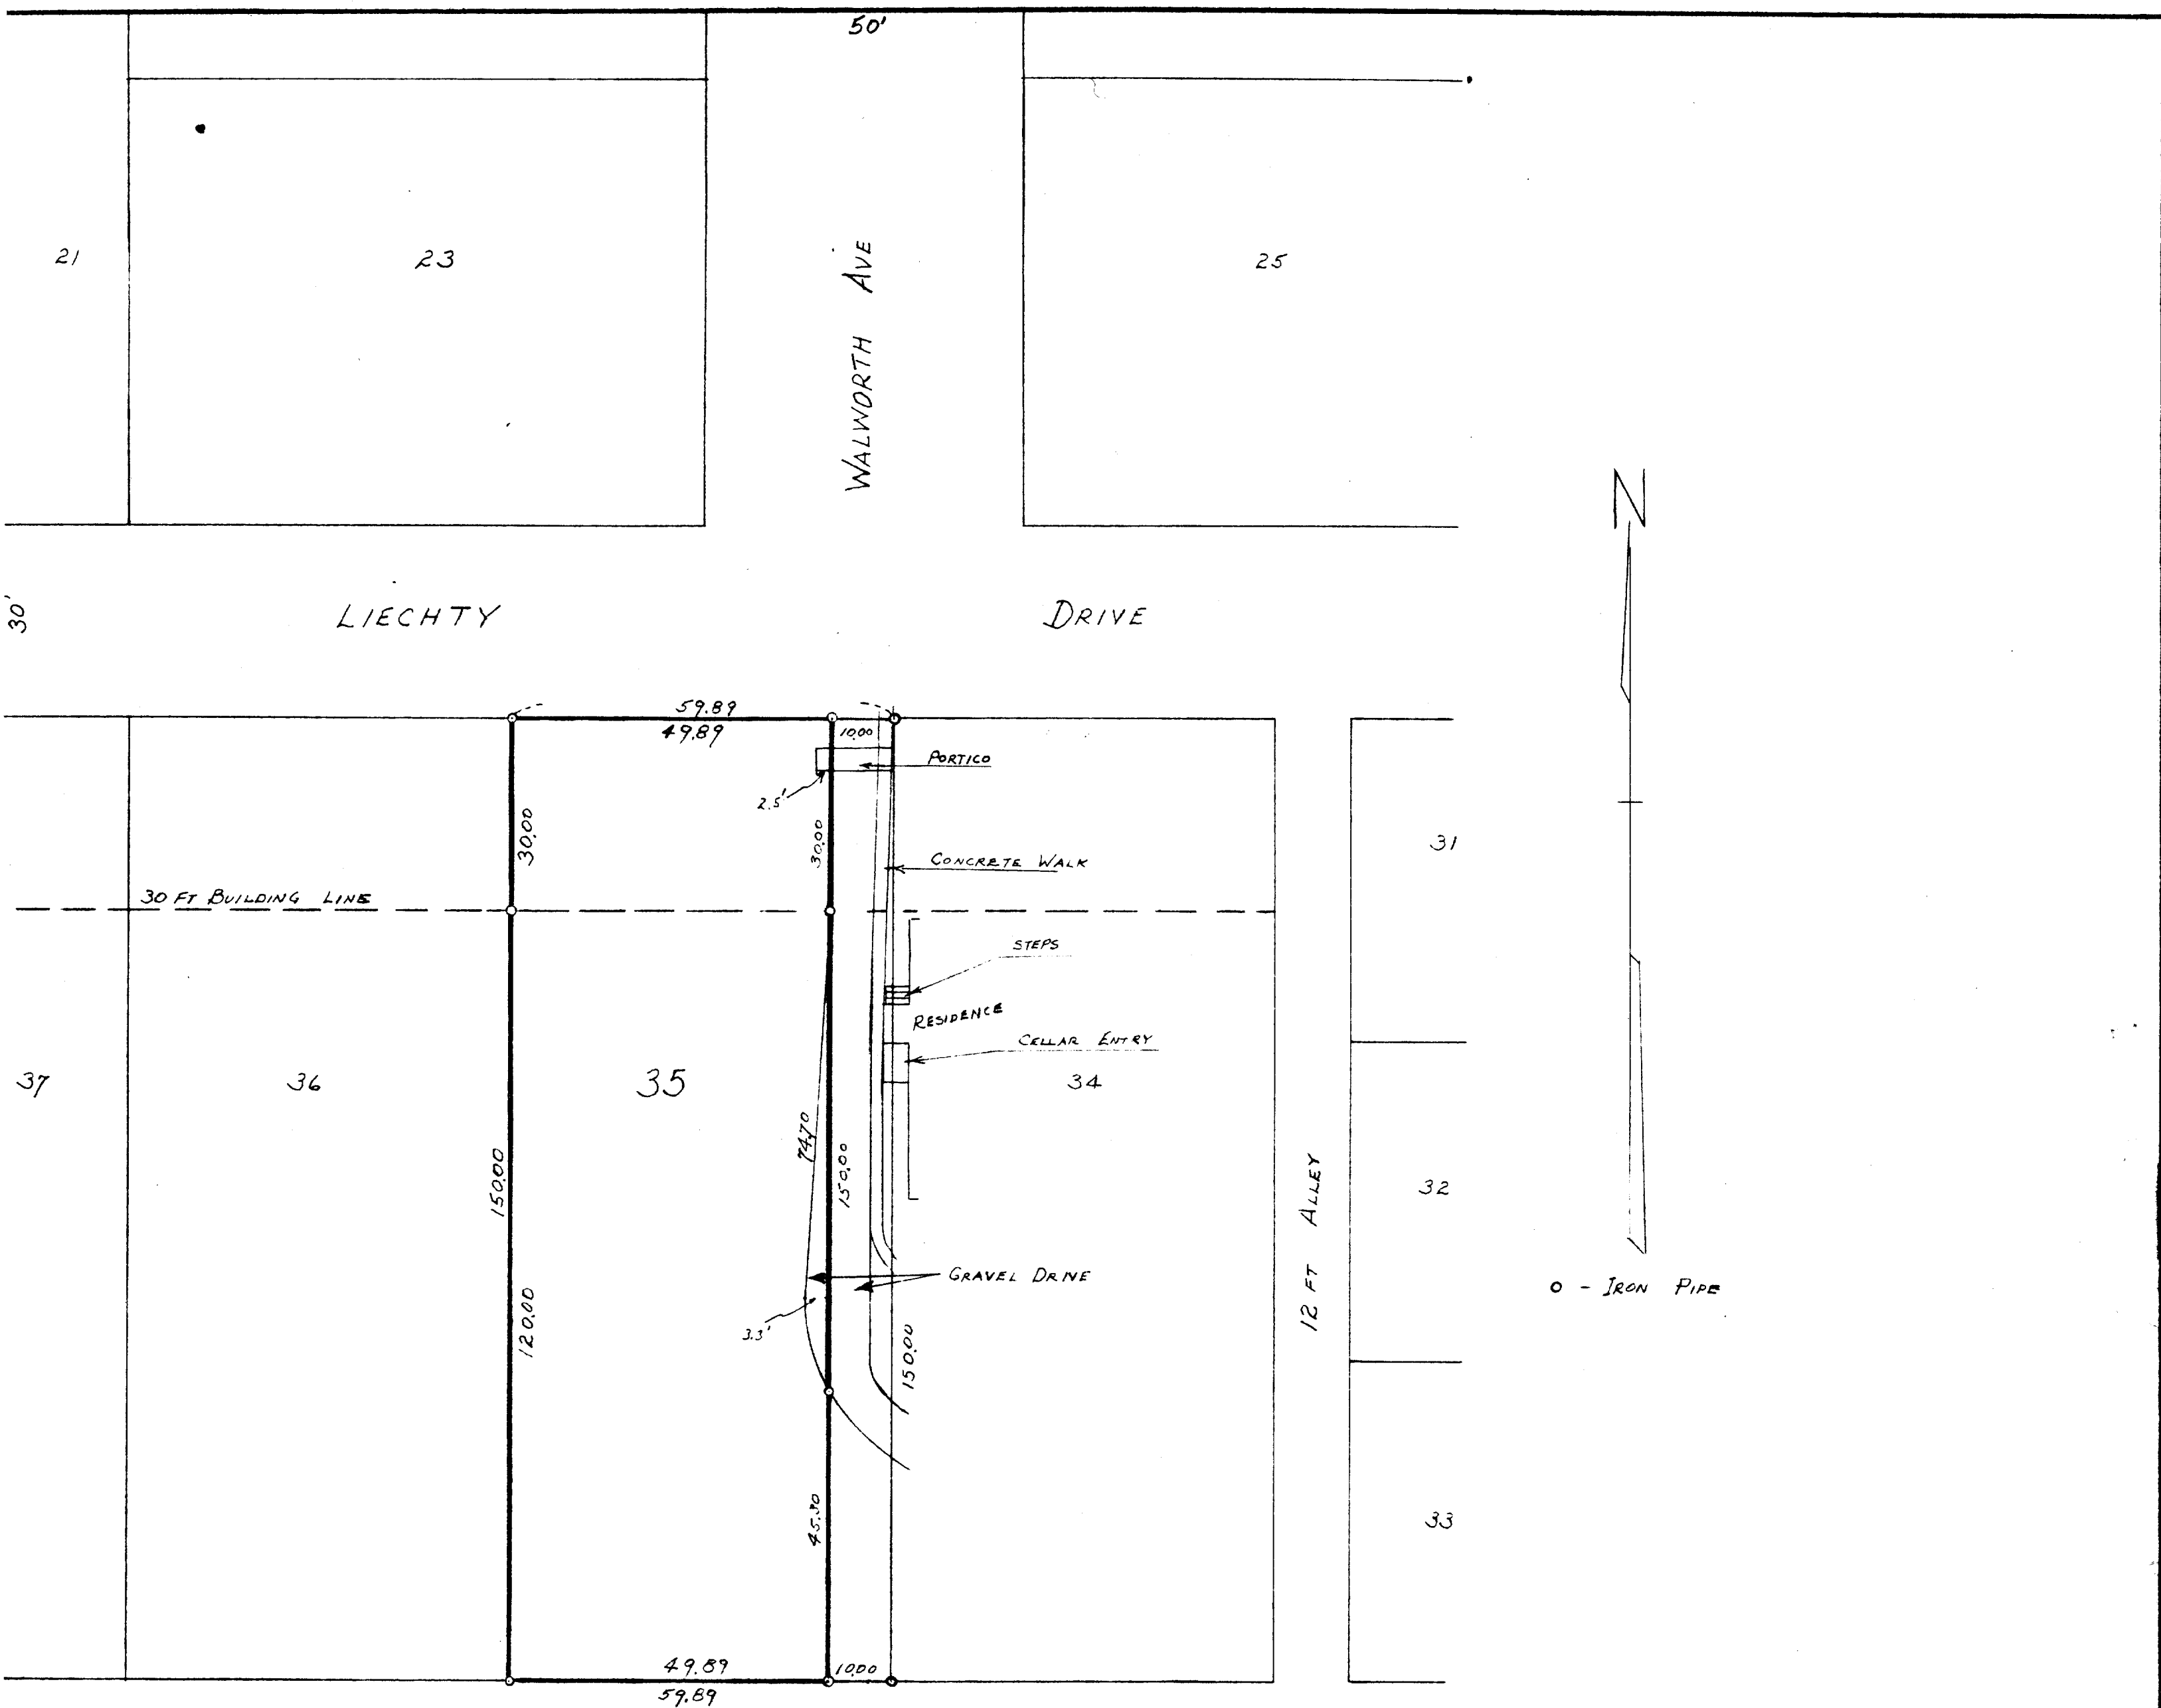

PLAT OF SURVEY
OF

LOT 35

EXCEPT EAST 10 FT. OF
SUMMERHAVEN
VILLAGE OF WILLIAMS BAY
WALWORTH COUNTY, WISCONSIN

Floyd L. Jensen
SURVEYOR

SCALE 1" = 20'

DATE FEB. 15, 1954