


Rt. 3, Box 273
Elkhorn, Wisconsin 53121
Phone: (414) 723-4260 (office)
(414) 723-7209 (FAX)

LOT 26 OF SUMMER HAVEN, LOCATED
IN THE SOUTHEAST 1/4 OF SECTION
1, TOWN 1 NORTH, RANGE 16 EAST,
VILLAGE OF WILLIAMS BAY, WALWORTH
COUNTY, WISCONSIN.

BUILDER: WOLF / MIDWEST
BUILDING AND DEVELOPMENT
67 N AYER ST. P.O. BOX 755
HARVARD, IL. 60033

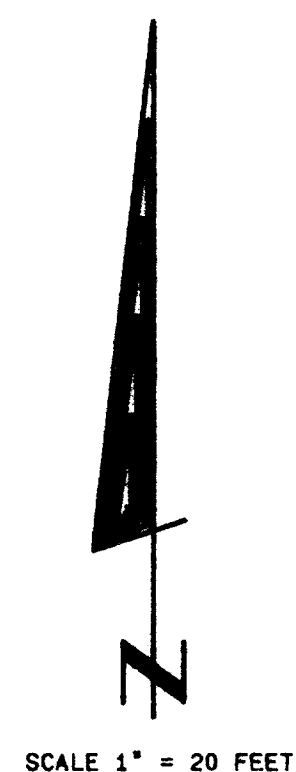


SCALE 1" = 20 FEET

- FOUND IRON PIPE
- FOUND IRON ROD
- FOUND BRASS CAPPED MONUMENT
- FOUND CONCRETE MONUMENT
- + CHISEL CUT IN CONCRETE
- SET IRON ROD, 24" LONG, WEIGHING 1.5 LBS./LINEAL FT., 3/4" DIA
- SET IRON ROD, 30" LONG, WEIGHING 4.5 LBS./LINEAL FT. 1-11/16" DIA.

(XX) RECORDED AS DIMENSION

—XX— EXISTING FENCE

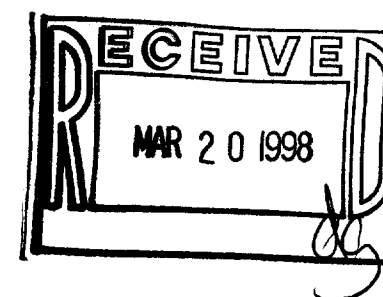

SCALE: 1" = 20 FEET



"I hereby certify that the above described property has been surveyed by me or under my direction, that the above map is a true and correct representation and shows the site and location of the property, its exterior boundaries, the location of all visible structures and dimensions of all principal buildings thereon, boundary fences, apparent easements, roadways and visible encroachments, if any."

one year from date hereof."

Kenneth B. Athern

KENNETH B. ABERNATHY, JR.
WISCONSIN REGISTERED LAND SURVEYOR.

Date: 2-13-98 S-1594
Job No. 98-203

WSU-26