


CLEVELAND

PARKWAY

● CONCRETE MONUMENT
○ IRON PIPE

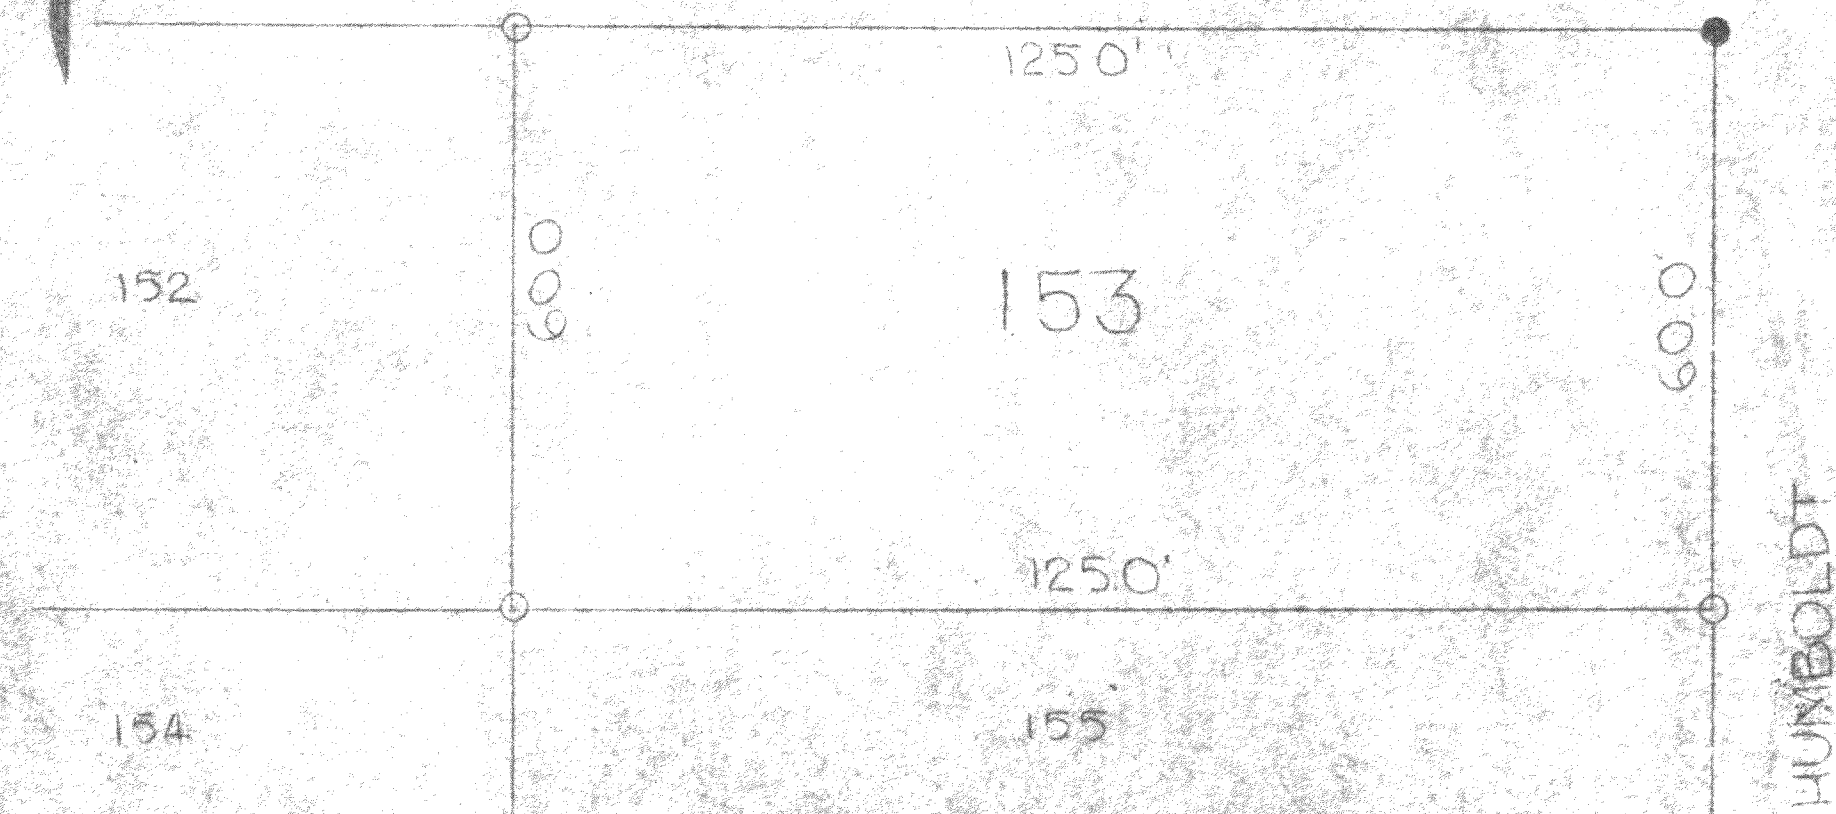

PLAT OF SURVEY OF LOT 153 IN CEDAR POINT
PARK SUBDIVISION, VILLAGE OF WILLIAMS BAY,
WALWORTH COUNTY, WISCONSIN

N. E. Johnson