


HAROLD H. KOLB

REGISTERED PROFESSIONAL LAND SURVEYOR
LAKE GENEVA, WISCONSIN

*Iron pipe reset 0.15'
SW of Lot Corner*

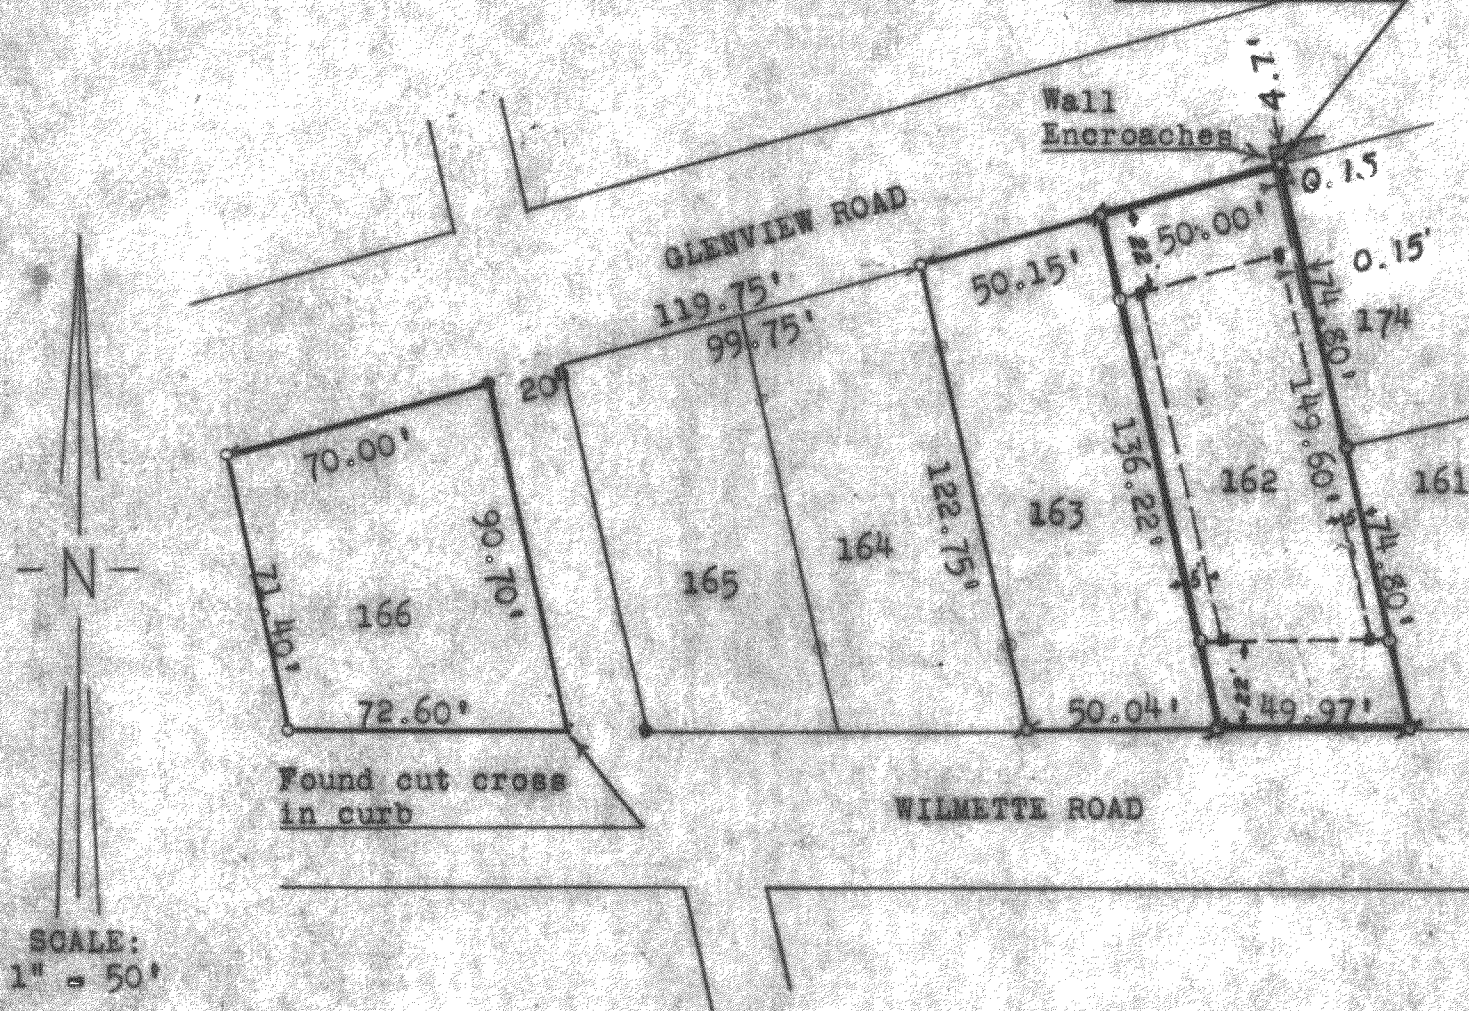

PLAT OF SURVEY OF

Lots 162, 163, and 166, Cedar Point
Park, Second Addition, Village of Williams
Bay, Walworth County, Wisconsin.

LEGEND

- - IRON PIPE FOUND
- - IRON PIPE PLACED
- - CONCRETE MONUMENT
- x - SPIKE
- - Wood Stake

RESURVEY OF

Lot 162, Cedar Point Park,
Second Addition.

Harold H. Kolb
DATE: June 28, 1966

I, HAROLD H. KOLB, DO HEREBY CERTIFY THAT I HAVE
SURVEYED THE PROPERTY HEREON DESCRIBED ACCORDING
TO THE OFFICIAL RECORDS, AND THAT THE PLAT HEREON
IS A CORRECT REPRESENTATION OF THE LOT LINES.

Harold H. Kolb
HAROLD H. KOLB
WISCONSIN REGISTERED LAND SURVEYOR, S-187
DATE August 13, 1964

11-132