


HAROLD H. KOLB
REGISTERED PROFESSIONAL LAND SURVEYOR
LAKE GENEVA, WISCONSIN

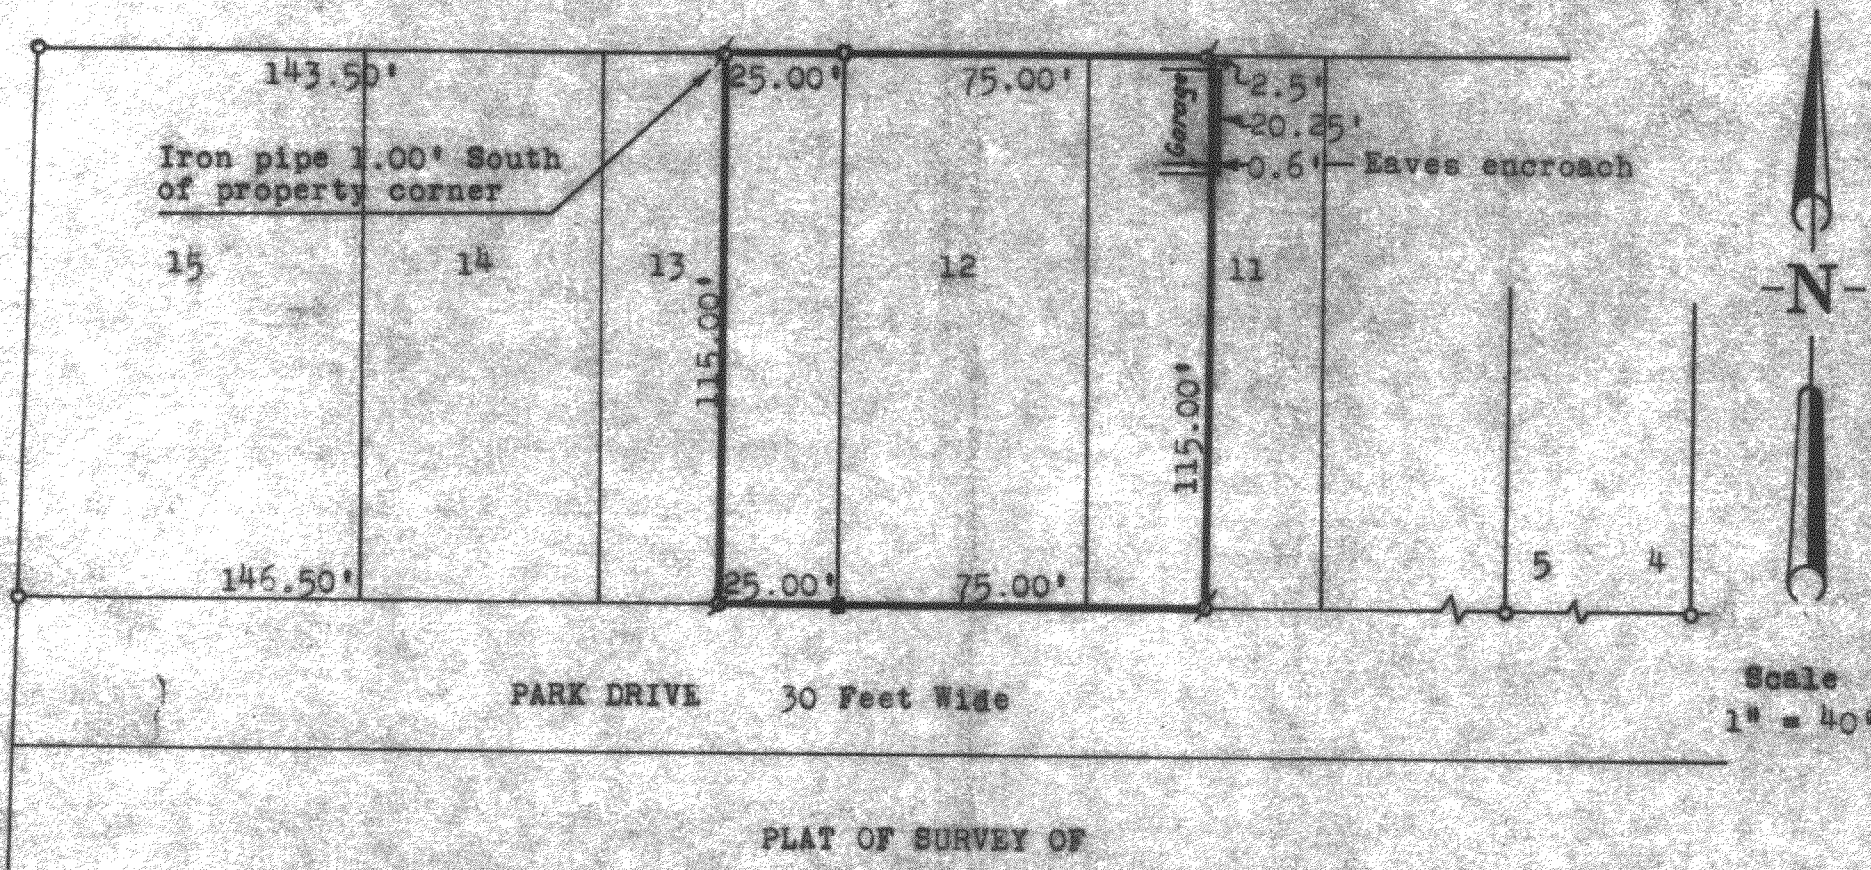

PLAT OF SURVEY OF

A parcel of land being the East 1/2 of Lot 13, all of Lot 12, and the West 1/2 of Lot 11, of Loch Vista Club Subdivision Number 1, Village of Williams Bay, Walworth County, Wisconsin.

- Found wood stake mark
- Found wood Stake
- Found iron pipe
- ✕ Set iron pipe

Harold H. Kolb

Harold H. Kolb, Wisconsin Surveyor, S-187

Date: April 20, 1964

WLV-10

11-133