


HAROLD H. KOLB
REGISTERED PROFESSIONAL LAND SURVEYOR
LAKE GENEVA, WISCONSIN

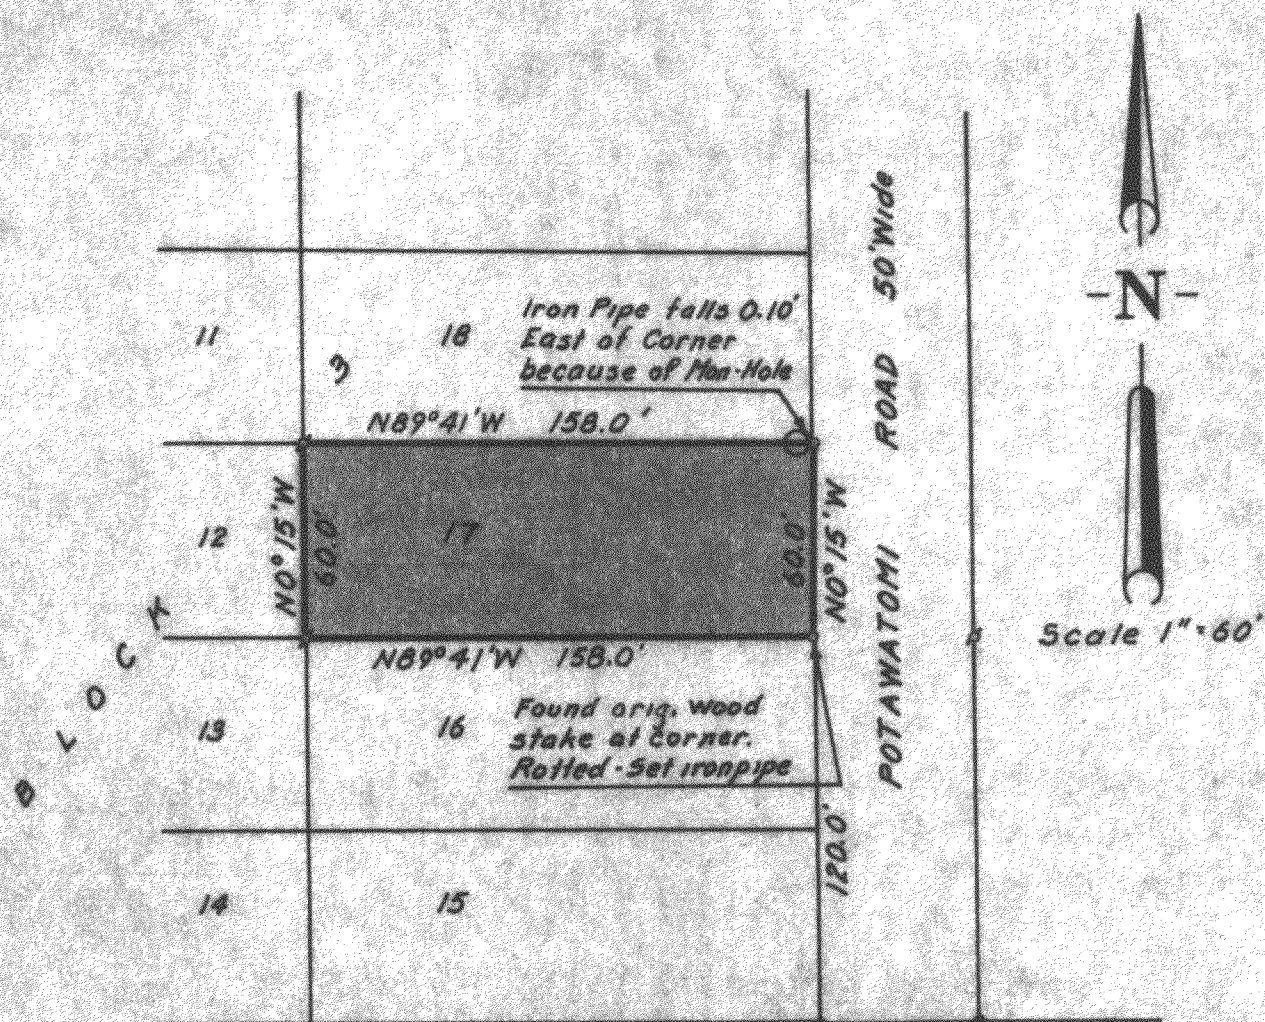

PLAT OF SURVEY OF

Lot 17, Block 3, Harbor View Subdivision,
Village of Williams Bay, Walworth County,
Wisconsin.

Harold H. Kolb

Harold H. Kolb, Wisconsin Surveyor, S-187
DATE: October 29, 1963

- - Conc. Monument Found
- - Iron Pipe Found
- - Iron Pipe Placed

WHV-47

11-134