


ABERNATHY and ASSOCIATES

Kenneth B. Abernathy Jr.

Wisconsin Registered Land Surveyor S-1594

PLAT OF SURVEY


LOT 191 OF CEDAR POINT PARK,
LOCATED IN THE VILLAGE OF
WILLIAMS BAY, WALWORTH
COUNTY, WISCONSIN.

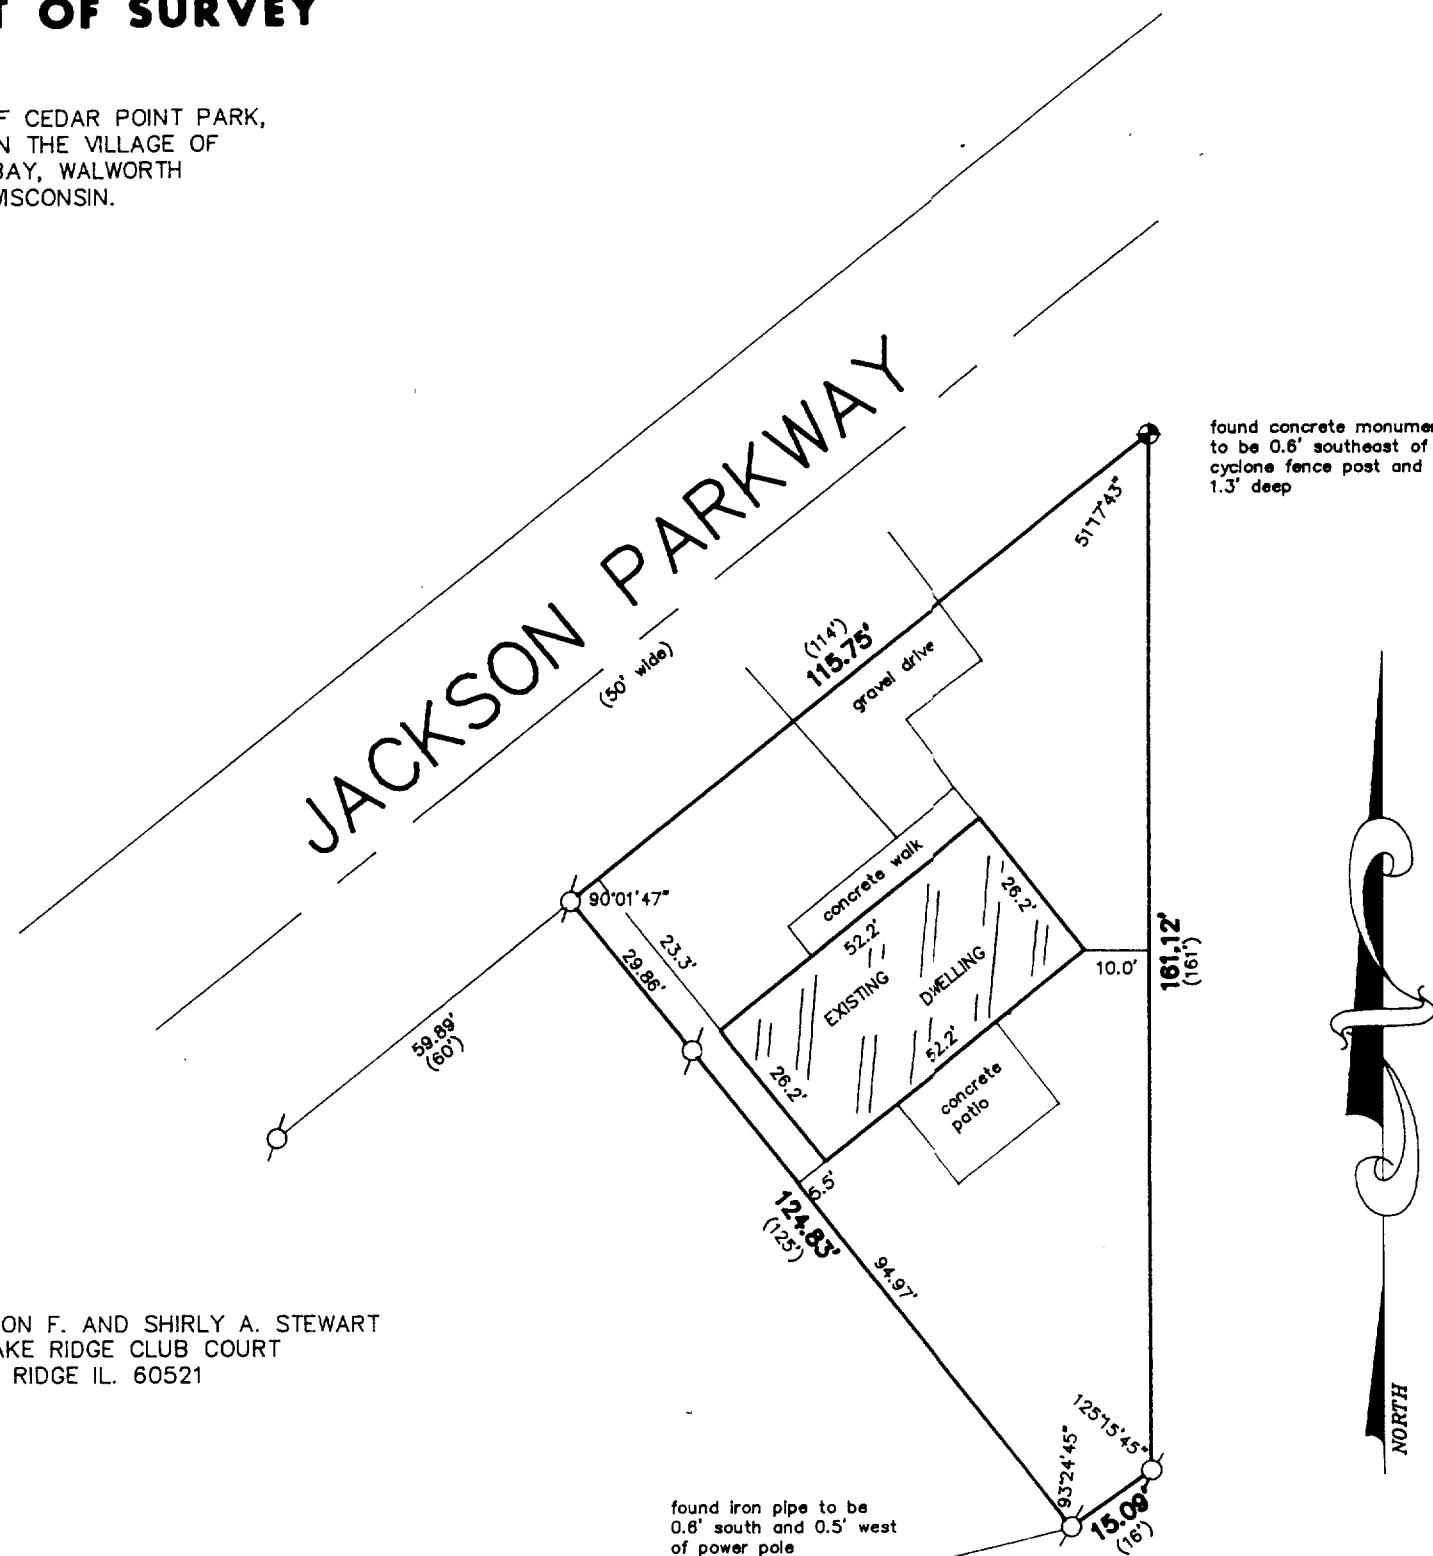

OWNER OF PROPERTY: SHARON F. AND SHIRLY A. STEWART
19 LAKE RIDGE CLUB COURT
BURR RIDGE IL. 60521

011-1344

WCP-165

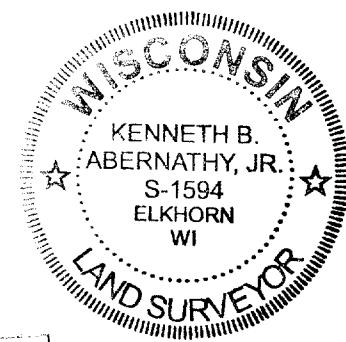

SCALE: 1" = 30 FEET

Legend

- ✗ FOUND IRON PIPE
- ✗ FOUND IRON ROD
- FOUND BRASS CAPPED MONUMENT
- ⊗ FOUND CONCRETE MONUMENT
- + CHISEL CUT IN CONCRETE
- SET IRON ROD, 24" LONG, WEIGHING 1.5 LBS./LINEAL FT., 3/4" DIA.
- SET IRON ROD, 30" LONG, WEIGHING 4.5 LBS./LINEAL FT., 1-11/16" DIA.
- (xx) RECORDED AS DIMENSION
- x—x— EXISTING FENCE

"I hereby certify that I have surveyed the above described property and that the above map is a true representation thereof and shows the size and location of the property, its exterior boundaries, the location of all visible structures and dimensions of all principal buildings thereon, boundary fences, apparent easements, roadways and visible encroachments, if any."

"This survey is made for the use of the present owners of the property, and also those who purchase, mortgage, or guarantee the title thereto within one year from date hereof."

eof."

Kenneth B. Dennis Jr.

KENNETH B. ABERNATHY, JR.
WISCONSIN REGISTERED LAND SURVEYOR,
S-1594

Date: 2/8/99 Job No. 99116