
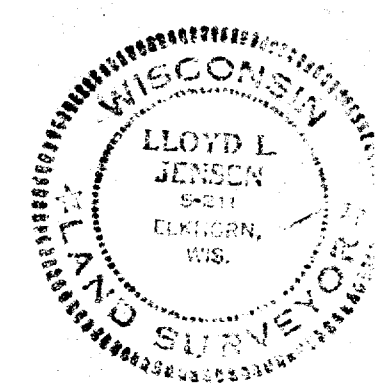


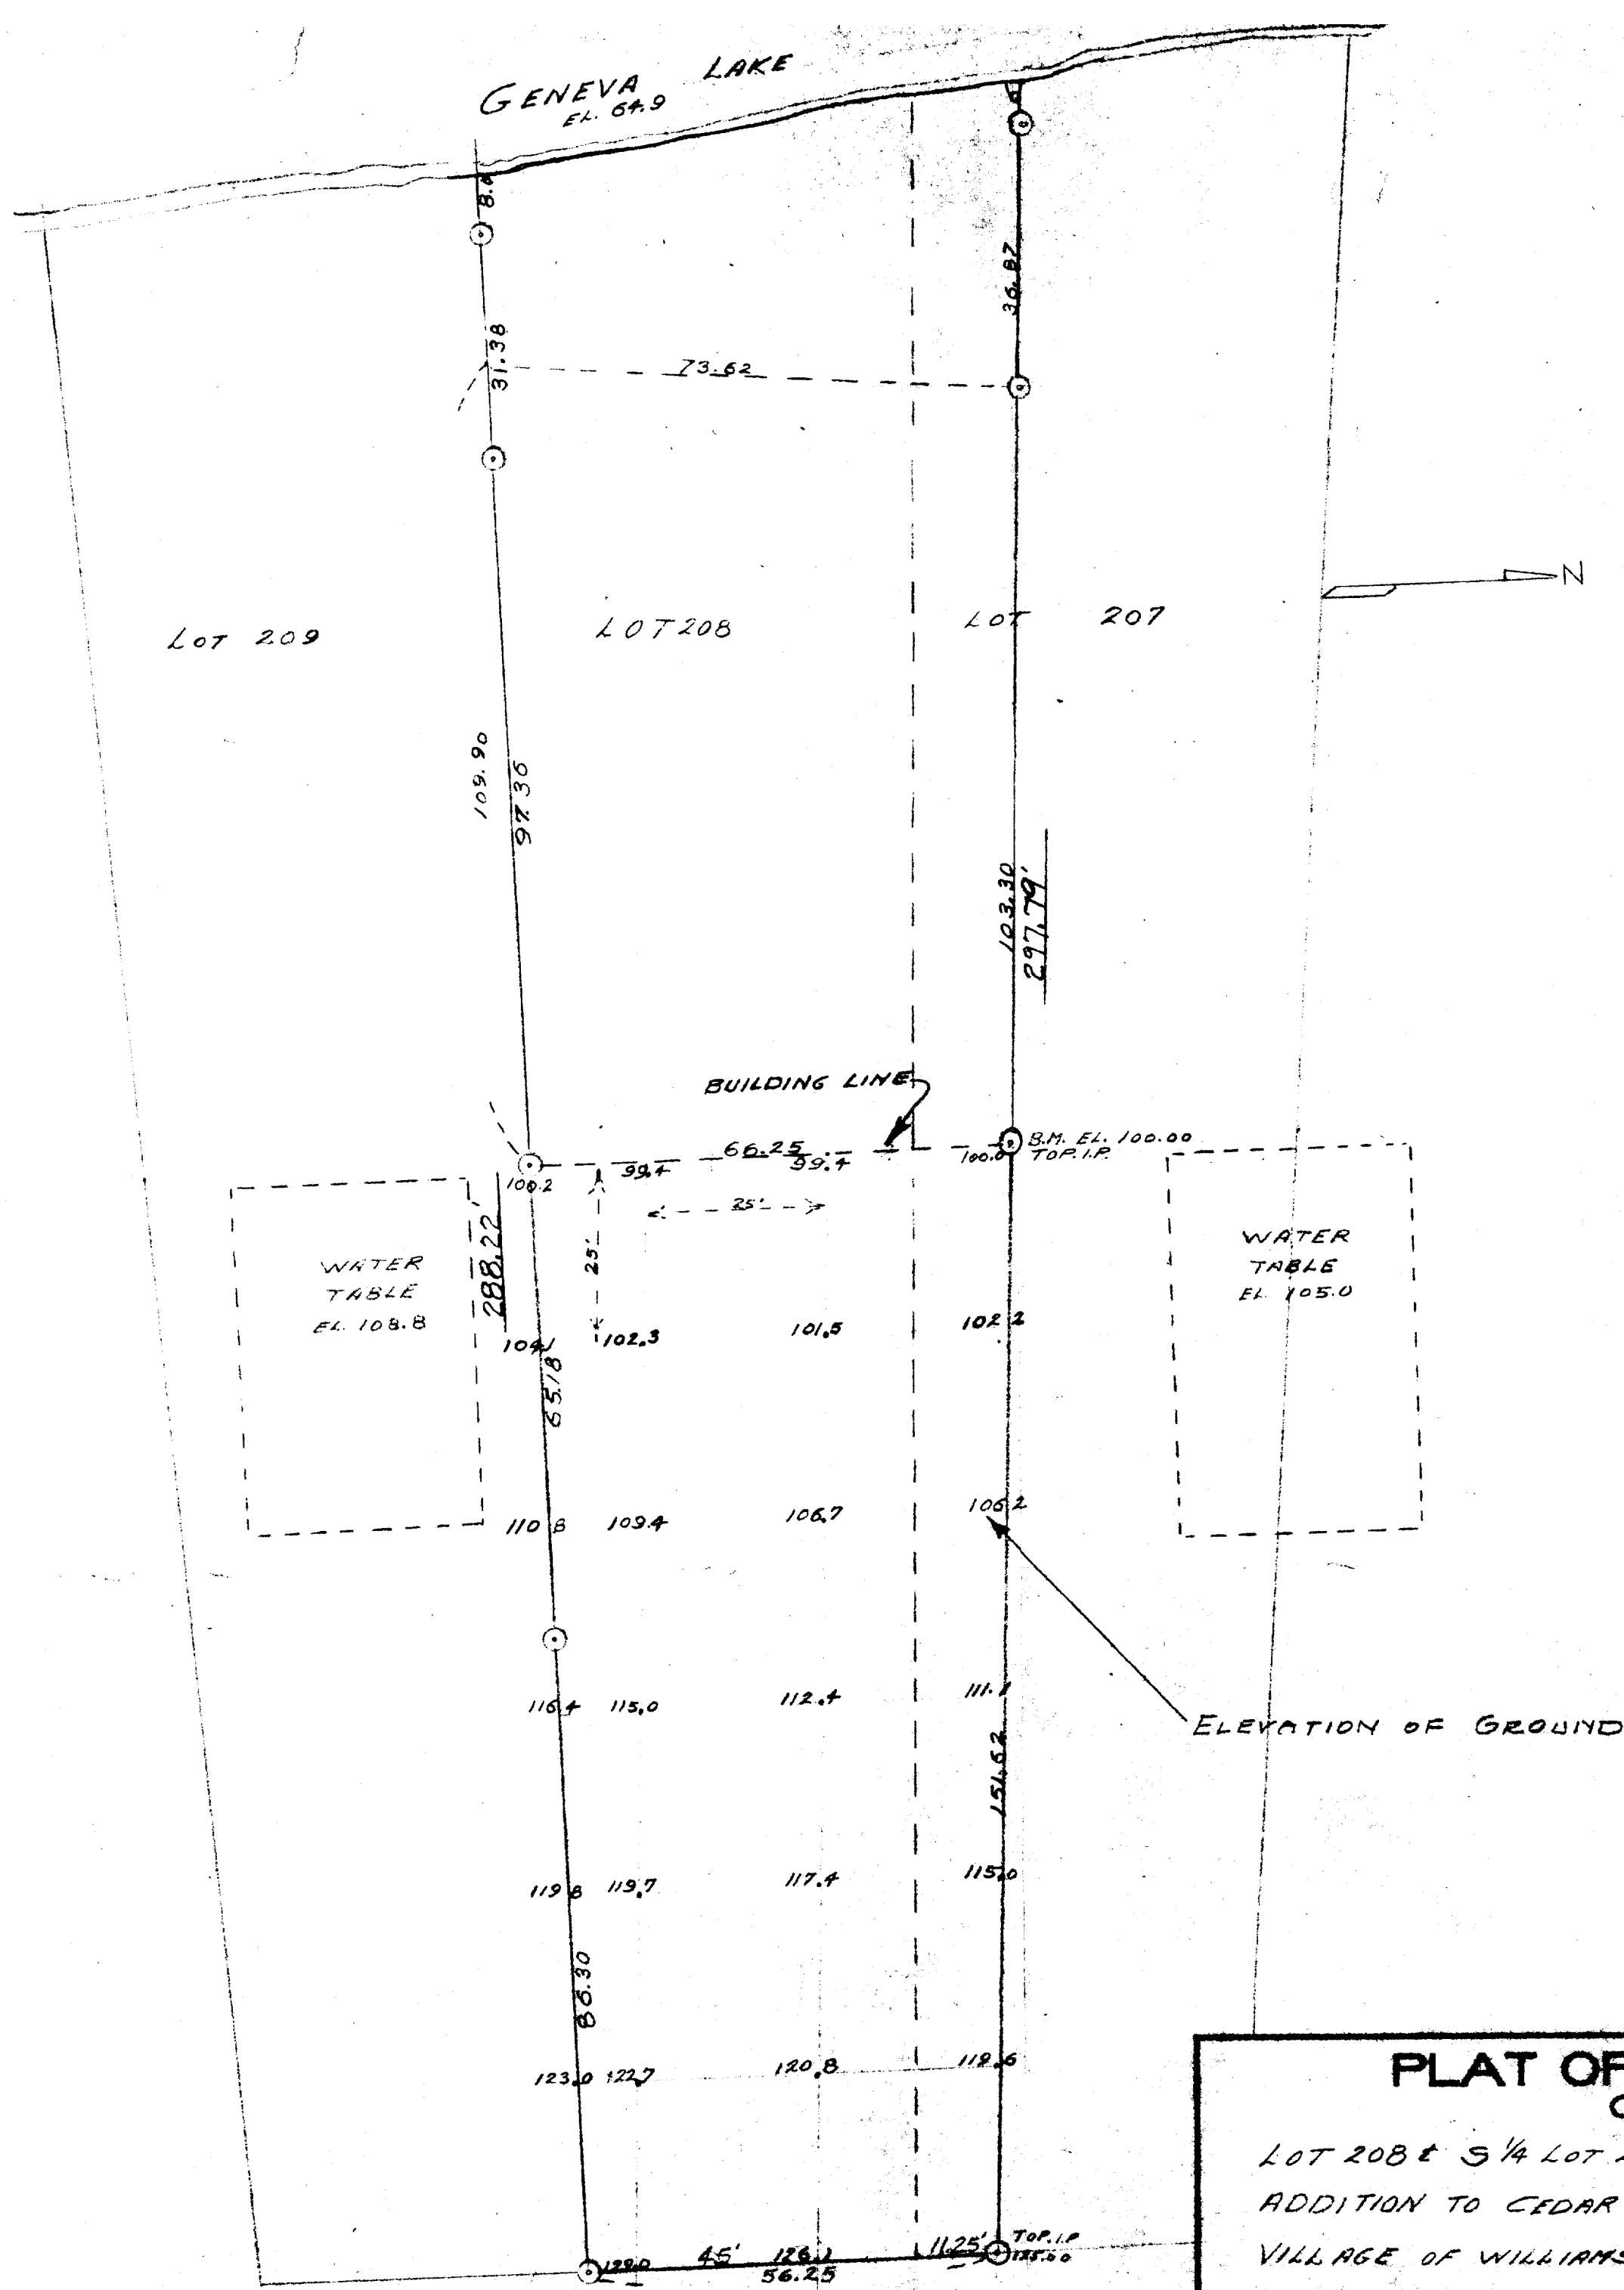

PLAT OF SURVEY
OF
LOT 208 & S 1/4 LOT 207 OF THE THIRD
ADDITION TO CEDAR POINT PARK IN THE
VILLAGE OF WILLIAMS BAY, WALWORTH
COUNTY, WISCONSIN

Lloyd L. Jensen
SURVEYOR

WCP 3-7